


SH (06) SH (07) SH (M1) SH (08) SH (01) SH (09) SH (02) SH (10) SH (04) SH (11) SH (12) SH (05)

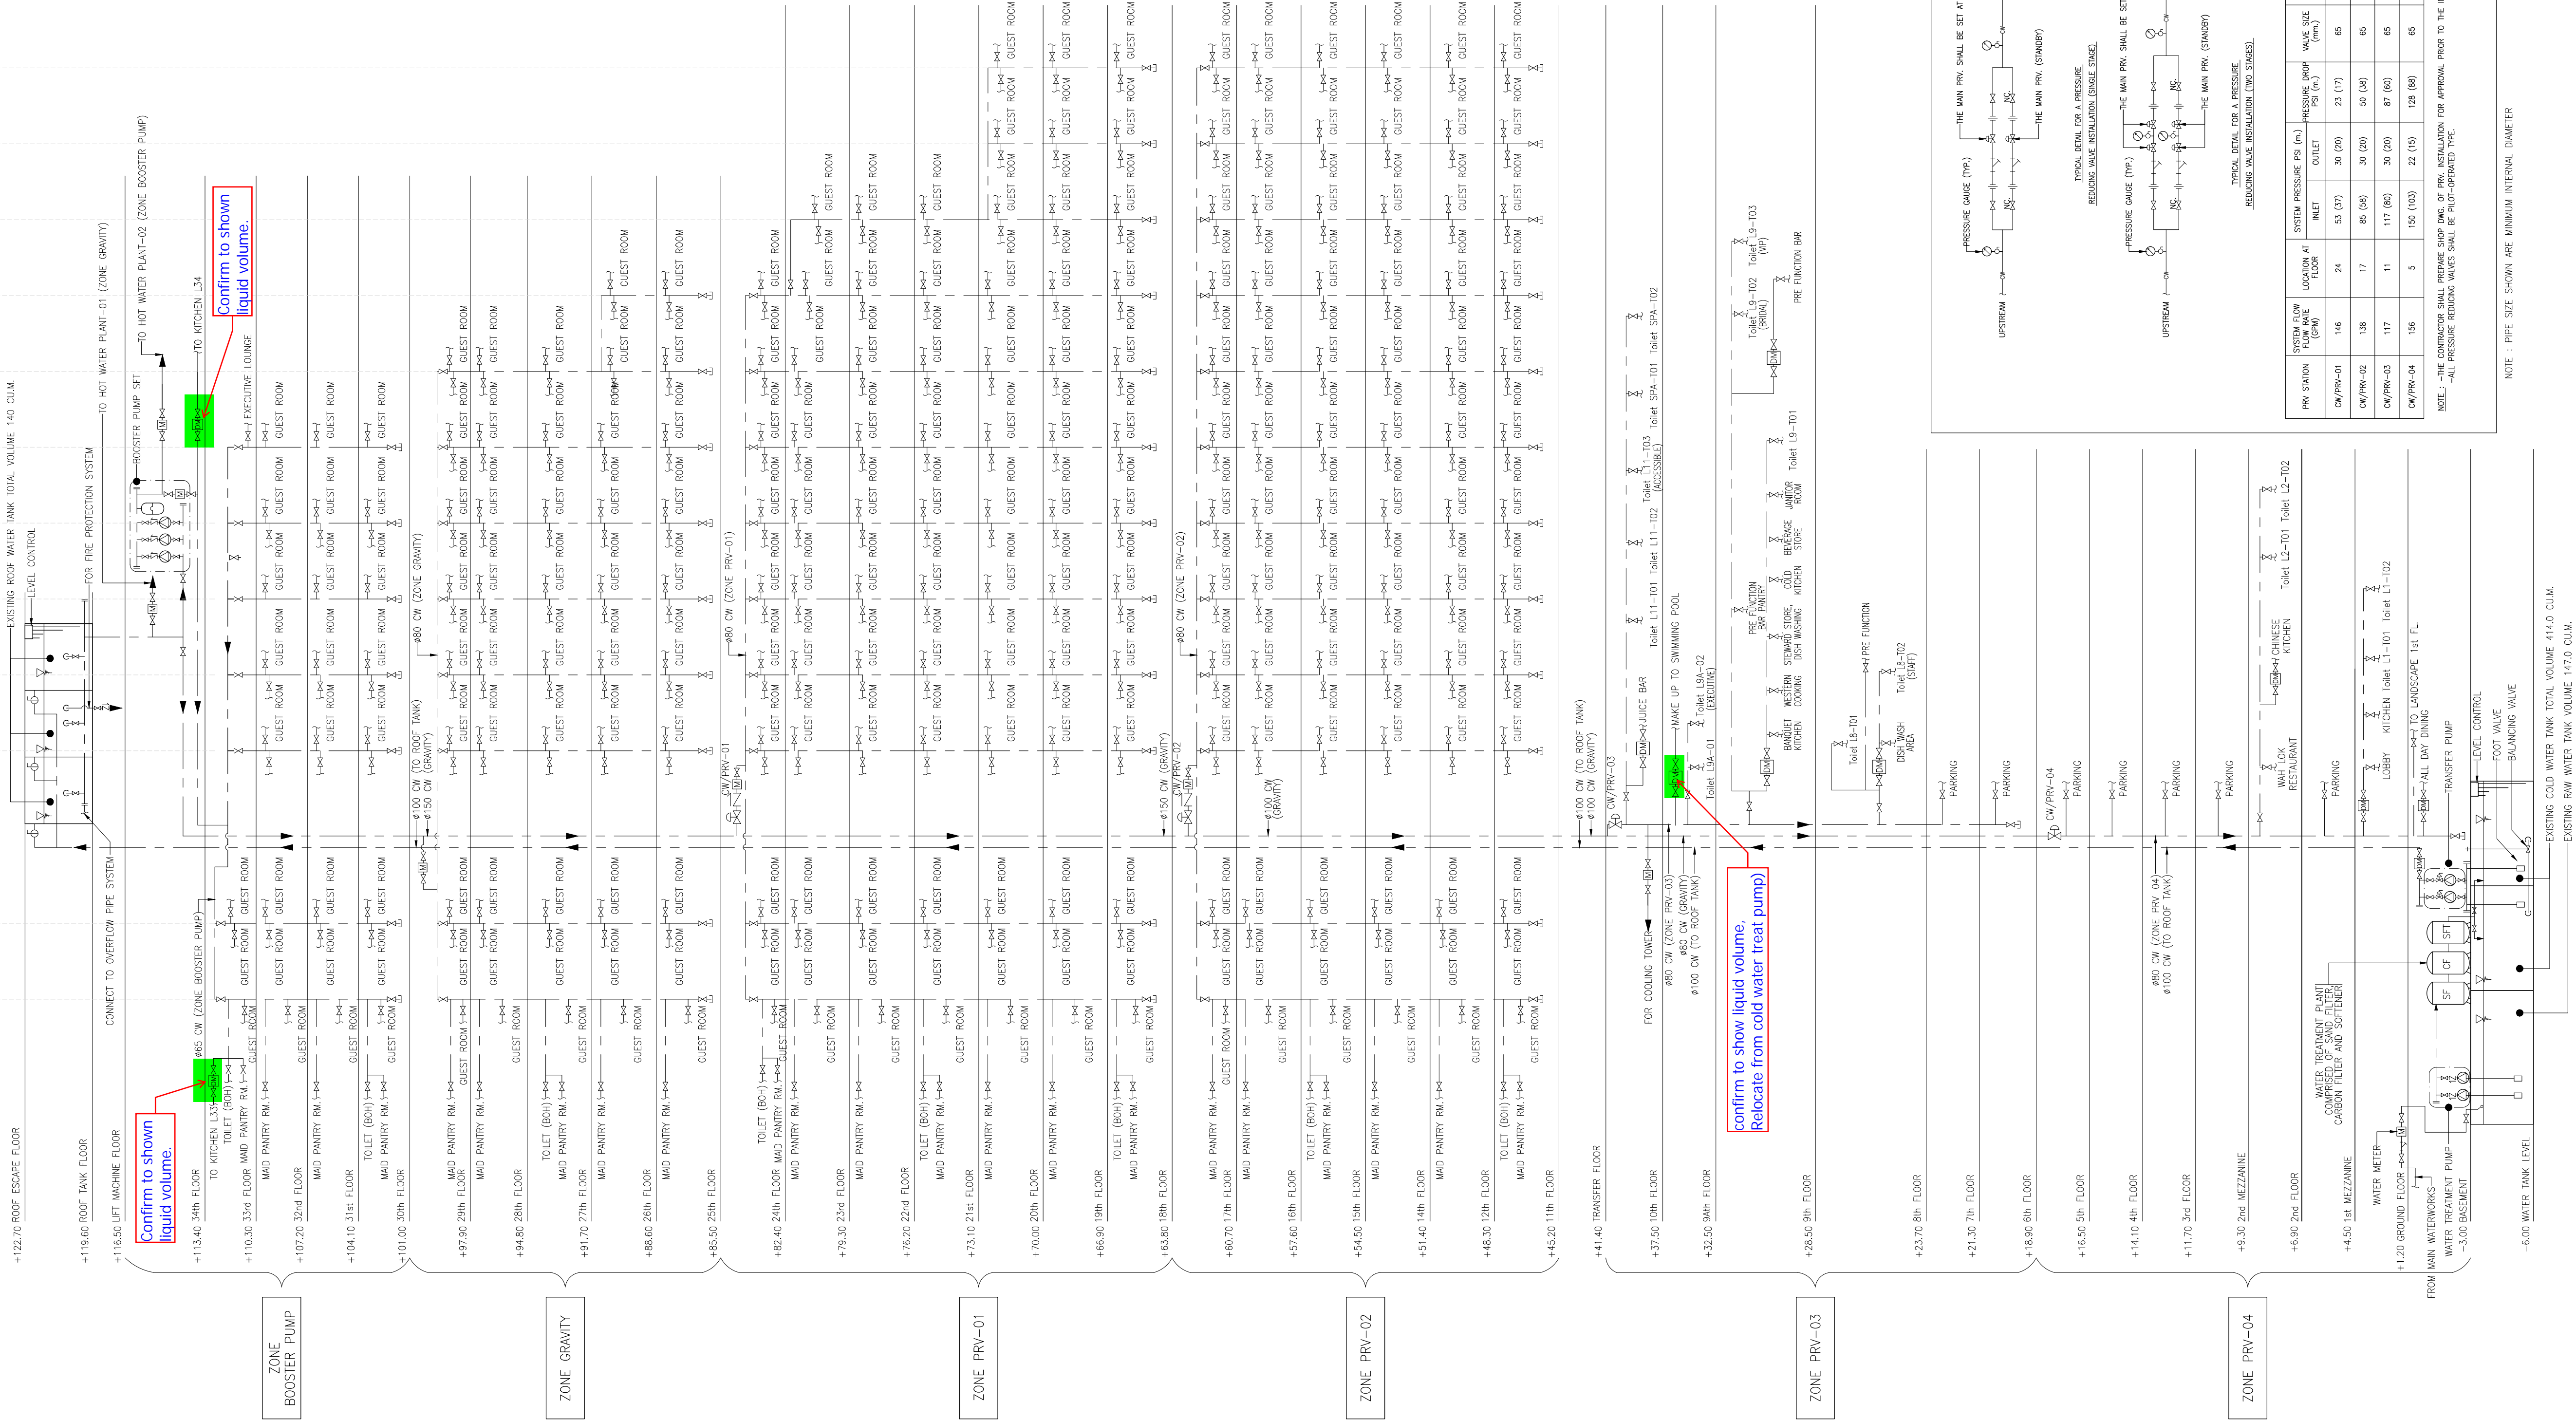

Item No. :  
Drawing No. : **SN-101**  
Drawing Title : **COLD WATER SYSTEM RISER DIAGRAM**  
Revision No. :  
Copy / Print Date : **24/02/2020**  
Distribute By :  
Remarks :

Submitted by

Approved by

REMI

AS-BUILT DRAWING

Date

Date

PROJECT NAME

**CARLTON**

27 Sukhumvit Rd, Khlong Toei, Khlong Toei, Bangkok 10110

OWNER

CARLTON HOTEL BANGKOK Co., Ltd

57 Park Ventures EcoPLEX, Level 18, Wireless Road, Lumpini, Pathumwan, Bangkok 10330, Thailand.

ARCHITECTS

Meinhardt (Thailand) Ltd

Co. Reg. No. 0100534077670

STRUCTURAL ENGINEERS

Electrical Engineers

Mechanical Engineers

Sanitary Engineers

Interior Designers

GREEN ARCHITECTS CO., LTD.

LANDSCAPE ARCHITECTS

FAÇADE CONSULTANT

FOODSERVICE & LAUNDRY CONSULTANT

LIGHTBOX

Lighting Designers

Acoustic Designers

ProjectsAsia

CONSTRUCTION CONTRACTOR

RITTA CO. LTD.

300 ROMUALDO ROAD

KLONG 3 PROMET, LAKHONG, BANGKOK 10520

Tel: (662) 328-5000, 105-5000 Fax: (662) 328-5011, 105-5011

ASBUILT DRAWING

DRAWING TITLE

COLD WATER SYSTEM RISER DIAGRAM

CHECKED BY: RITTA



DRAWN BY: WCI

SCALE: NTS

DATE: 24/02/2020


DRAWING NO. 5430496 SN-101



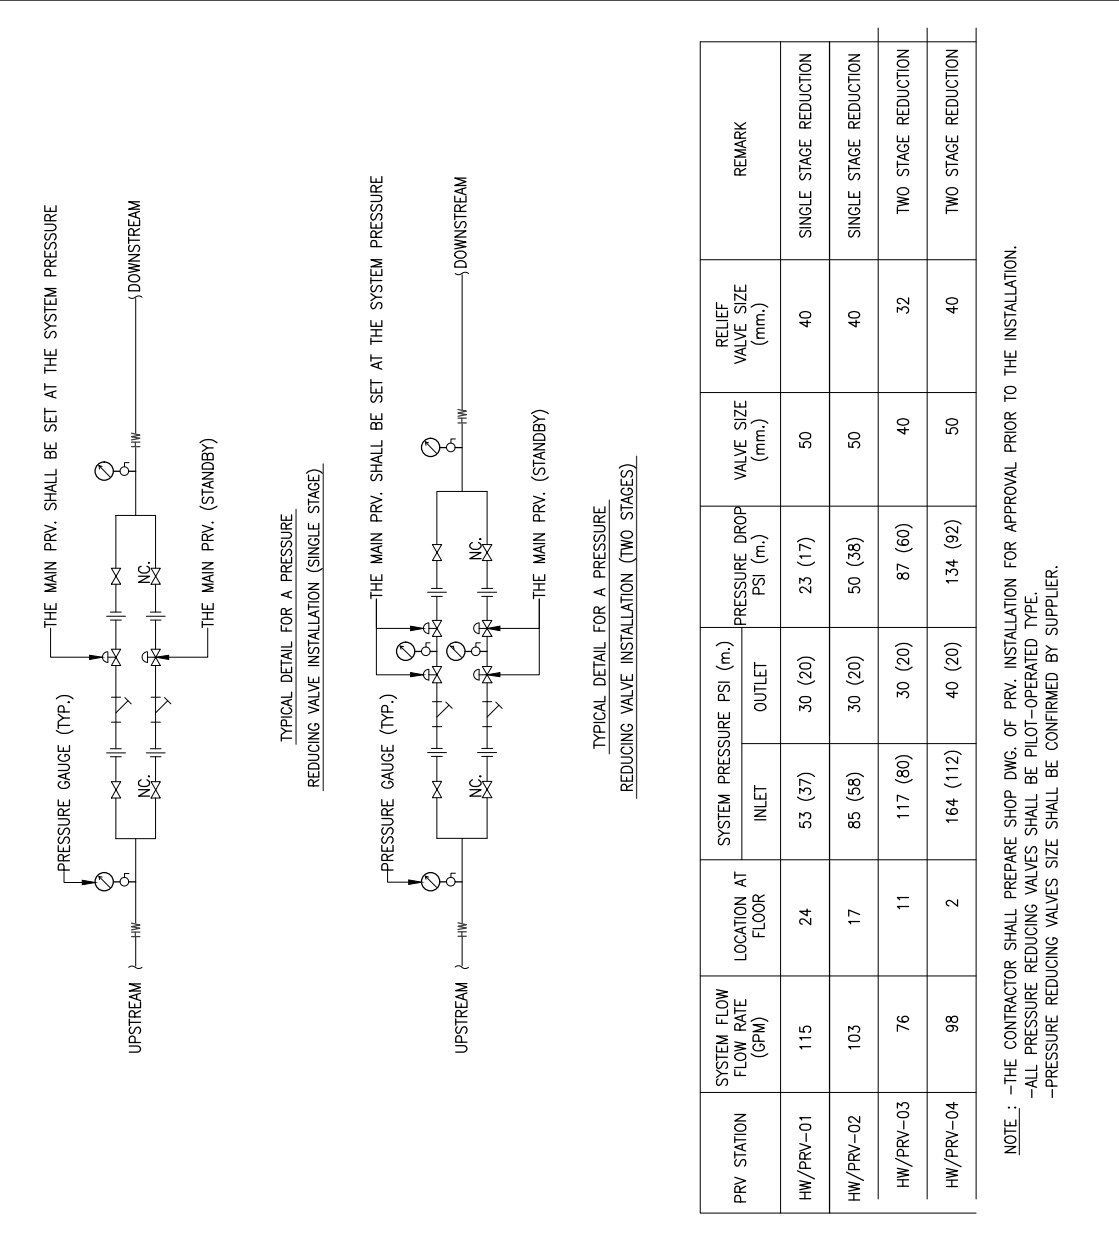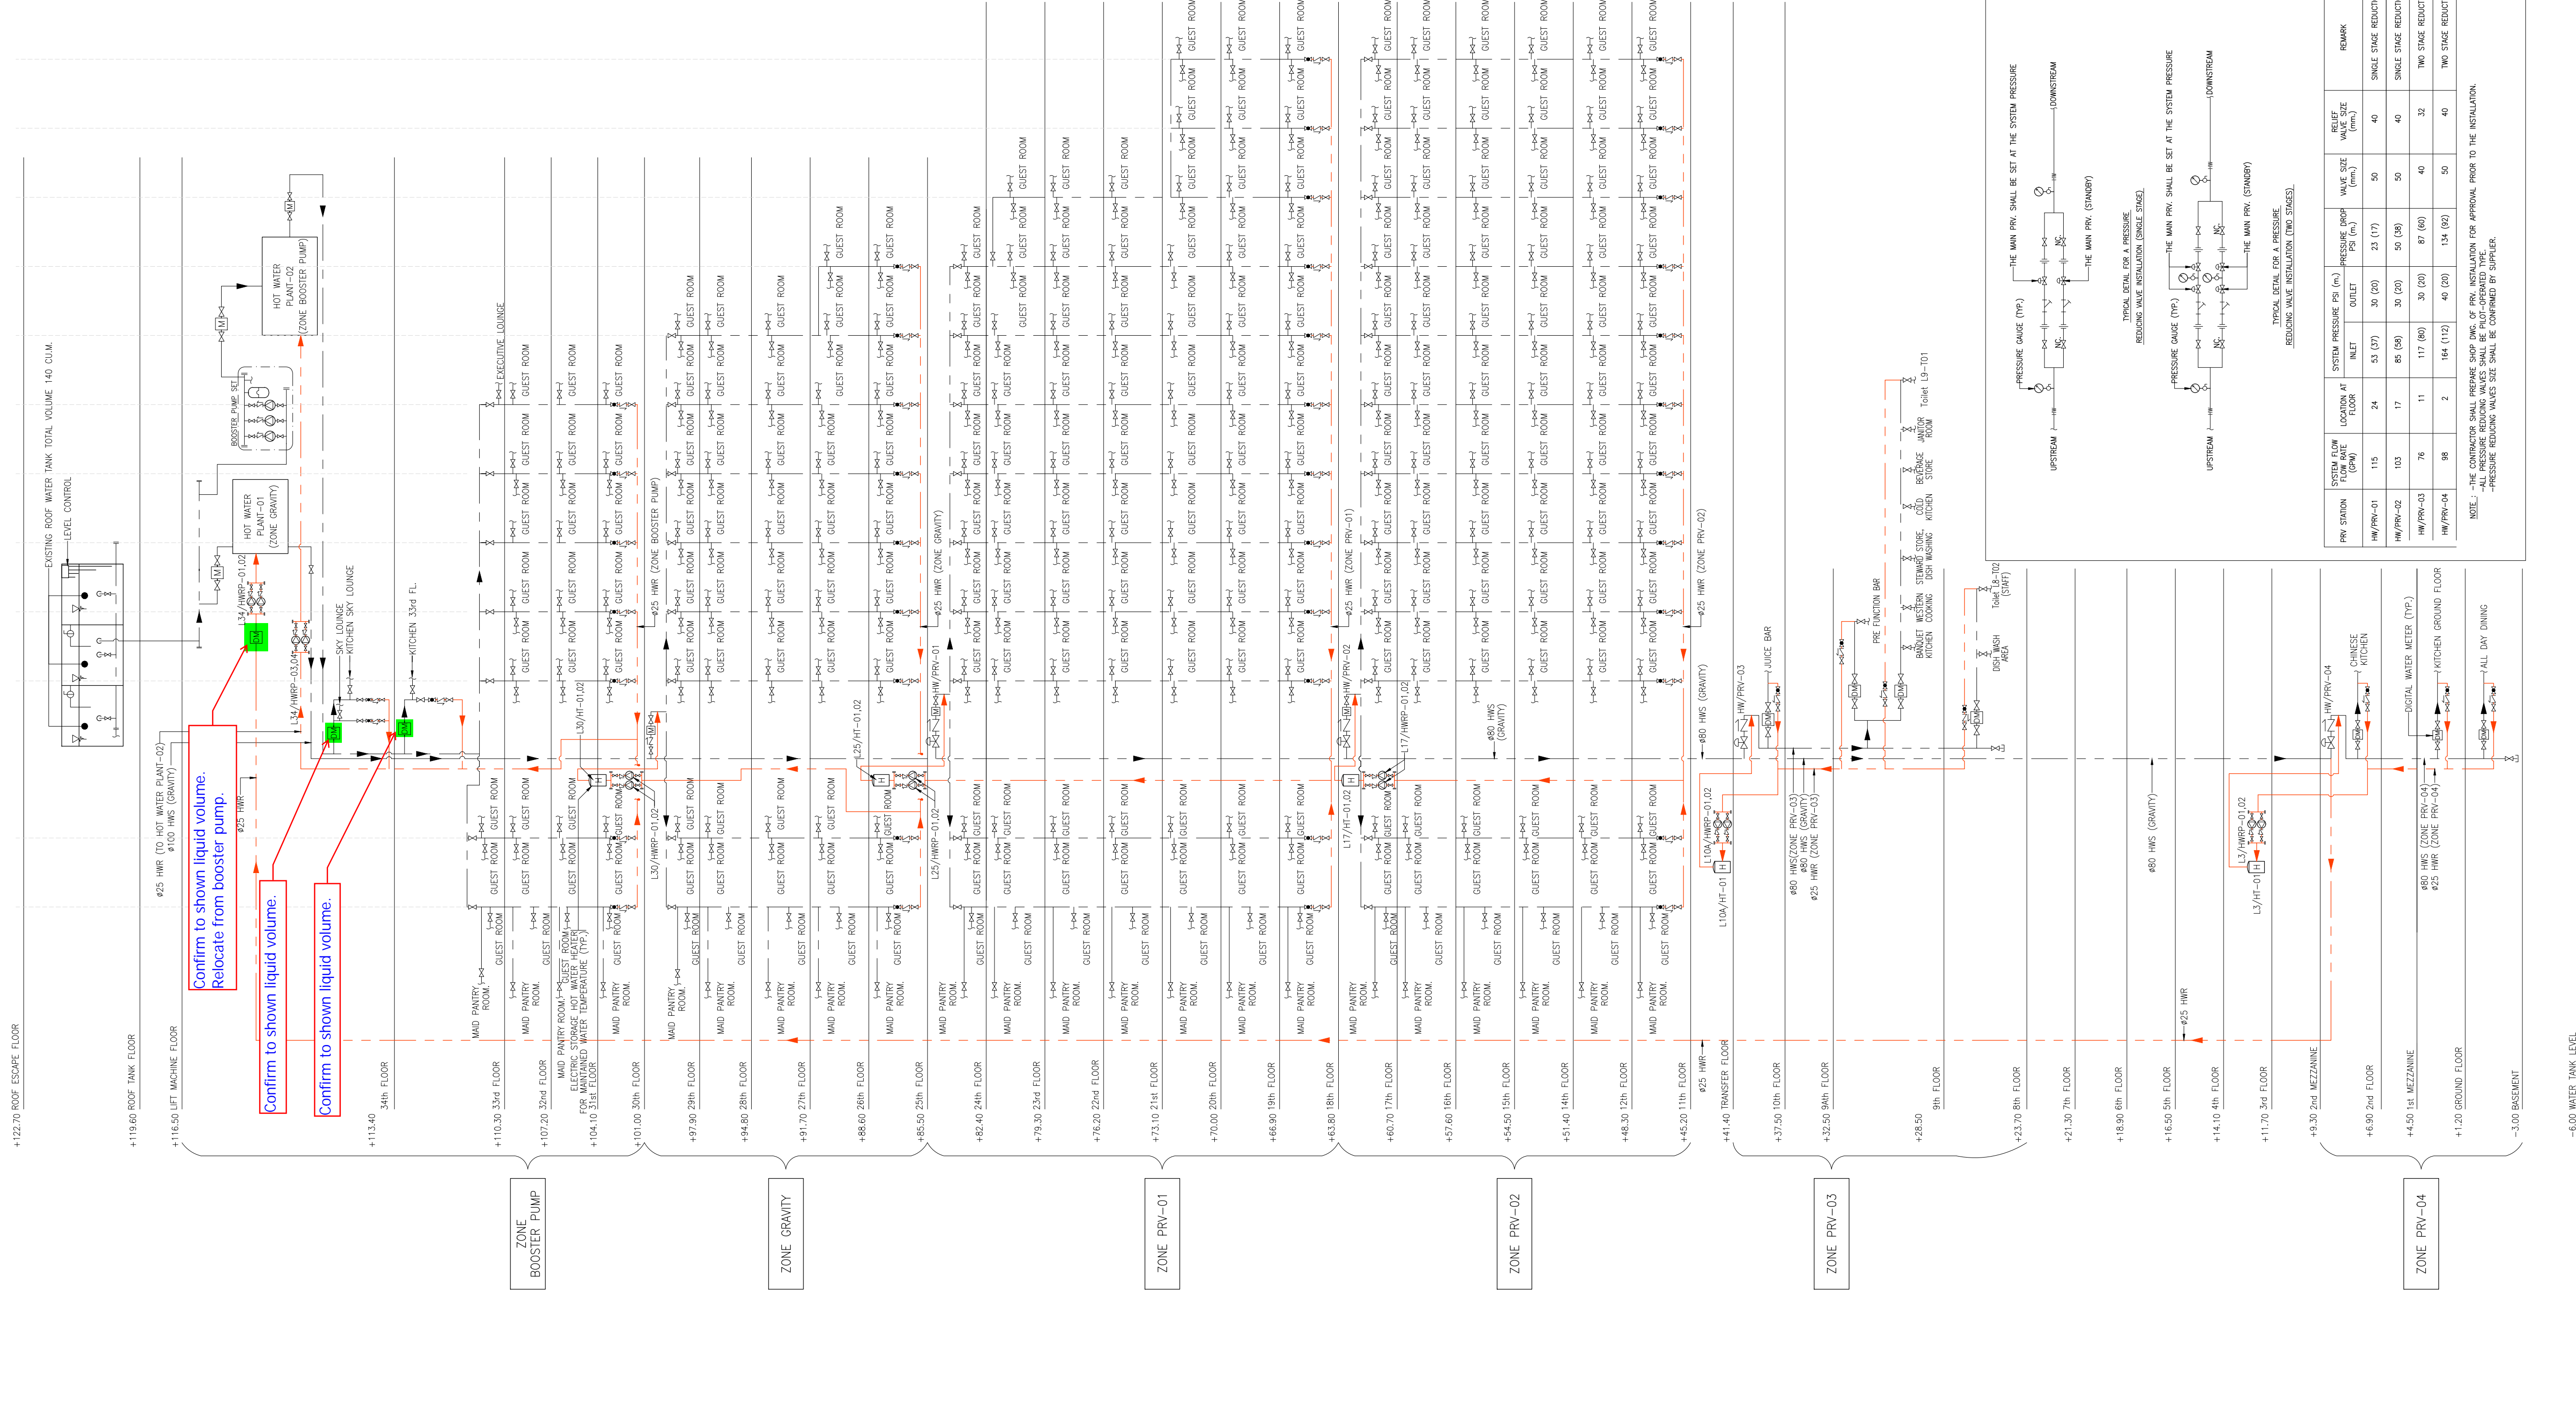

HOT WATER SYSTEM RISER DIAGRAM

Item No. : \_\_\_\_\_  
Drawing No. : **SN-102**  
Drawing Title : **HOT WATER SYSTEM RISER DIAGRAM**  
Revision No. : \_\_\_\_\_ Date : \_\_\_\_\_  
Copy / Print Date : **24/02/2020** Due Date : \_\_\_\_\_  
Distribute By : \_\_\_\_\_  
Remarks : \_\_\_\_\_



Submitted by \_\_\_\_\_  
Approved by \_\_\_\_\_  
REM

**AS-BUILT DRAWING**

Date \_\_\_\_\_

PROJECT NAME

**CARLTON**

27 Sukhumvit Rd, Khlong Toei, Khlong Toei, Bangkok 10110

OWNER

CARLTON HOTEL BANGKOK Co., Ltd  
57 Park Ventures EcoPLEX, Level 18, Wireless Road, Lumpini, Pathumwan, Bangkok 10330, Thailand.

ARCHITECTS

Meinhardt (Thailand) Ltd  
Co. Reg. No. 0105534077670

STRUCTURAL ENGINEERS

BECA

ELECTRICAL ENGINEERS

MECHANICAL ENGINEERS

SANITARY ENGINEERS

INTERIOR DESIGNERS

LANDSCAPE ARCHITECTS

FAÇADE CONSULTANT

FOODSERVICE & LAUNDRY CONSULTANT

LIGHTING DESIGNERS

ACOUSTIC DESIGNERS

PROJECTSAsia

CONSTRUCTION CONTRACTOR

RITTA CO. LTD.

ASBUILT DRAWING

CHECKED BY: RITTA

DRAWN BY: WCI

SCALE: NTS

DATE: 24/02/2020

DRAWING NO. 5430496 SN-102