

#### **6.12 เอกสารหนังสือรับรองการฝึกซ้อมอพยพหนีไฟ ปี 2563**



ที่ รย ๗๑๘๐๑ / ๑๐๐๓

องค์การบริหารส่วนตำบลตาสีห์  
๔๖ หมู่ที่ ๒ ถนนบ้านค่าย-บ้านบึง  
ตำบลตาสีห์ อำเภอลวกแดง  
จังหวัดระยอง ๒๑๑๔๐

### หนังสือรับรอง

หนังสือฉบับนี้ให้ไว้เพื่อแสดงว่า บริษัท อีเอสบี วัน จำกัด (สาขา ๐๐๐๐๑) ตั้งอยู่ เลขที่ ๑๕๙ หมู่ ๖ ตำบลมาบยางพร อำเภอลวกแดง จังหวัดระยอง ได้ดำเนินการจัดการฝึกซ้อม อพยพหนีไฟ ให้แก่พนักงาน ในสถานประกอบการ ตามกฎกระทรวง กำหนดมาตรฐานในการบริหารจัดการ และการดำเนินการด้านความปลอดภัยอาชีวอนามัย และสภาพแวดล้อมในการทำงานเกี่ยวกับการป้องกัน และระงับอัคคีภัย พ.ศ.๒๕๕๕ ข้อ ๓๐ โดยจัดให้มีการฝึกซ้อมดับเพลิง และอพยพหนีไฟ เมื่อวันที่ ๑๒ พฤศจิกายน ๒๕๖๓ จำนวน ๘ คน (ดังเอกสารรายชื่อ ประทับตราองค์การบริหารส่วนตำบลแนบหนังสือรับรองฉบับนี้) โดยได้รับการสนับสนุนวิทยากร และครูฝึกอบรม จากองค์การบริหารส่วนตำบลตาสีห์

ผลการฝึกอบรมดับเพลิงขั้นต้น ปรากฏว่าผู้เข้ารับการฝึกอบรมมีความรู้ ความเข้าใจในการฝึกซ้อมดับเพลิง และอพยพหนีไฟ ตามหลักเกณฑ์และวิธีการเป็นอย่างดี เป็นไปตามวัตถุประสงค์และเป้าหมายทุกประการ

จึงขอรับรองว่าข้อความดังกล่าวข้างต้นเป็นความจริง

ให้ไว้ ณ วันที่ ๑๕ เดือนพฤศจิกายน พ.ศ. ๒๕๖๓



(นายบุญผไท พงษ์โพธิ์)

นายกองค์การบริหารส่วนตำบลตาสีห์

ที่ รย ๗๑๘๐๑/๑๐๐๖



องค์การบริหารส่วนตำบลตาสีห์  
๔๖ หมู่ที่ ๒ ถนนบ้านค่าย-บ้านบึง  
ตำบลตาสีห์ อำเภอลวกแดง  
จังหวัดระยอง ๒๑๑๔๐

### หนังสือรับรอง

หนังสือฉบับนี้ให้ไว้เพื่อแสดงว่า บริษัท อีเอสบี วัน จำกัด (สาขา ๐๐๐๐๑) ตั้งอยู่ เลขที่ ๑๕๙ หมู่ ๖ ตำบลมาบยางพร อำเภอลวกแดง จังหวัดระยอง ได้ดำเนินการจัดการฝึกอบรมการดับเพลิงขั้นต้น ให้แก่ พนักงานในสถานประกอบการ ตามกฎกระทรวง กำหนดมาตรฐานในการบริหารจัดการ และการดำเนินการด้านความปลอดภัยอาชีวอนามัย และสภาพแวดล้อมในการทำงานเกี่ยวกับการป้องกันและระงับอัคคีภัย พ.ศ.๒๕๕๕ ข้อ ๒๗ โดยจัดให้มีการฝึกอบรมทั้งภาคทฤษฎี และภาคปฏิบัติ วันที่ ๑๒ พฤศจิกายน ๒๕๖๓ จำนวน ๘ คน (ดังเอกสารรายชื่อประทับตราองค์การบริหารส่วนตำบลแนบหนังสือรับรองฉบับนี้) โดยได้รับการสนับสนุนวิทยากร และครูฝึกอบรมจากองค์การบริหารส่วนตำบลตาสีห์

ผลการฝึกอบรมดับเพลิงขั้นต้น ปรากฏว่าผู้เข้ารับการฝึกอบรมมีความรู้ ความเข้าใจทั้งภาคทฤษฎี และภาคปฏิบัติ ตามหลักเกณฑ์และวิธีการเป็นอย่างดี เป็นไปตามวัตถุประสงค์และเป้าหมายทุกประการ

จึงขอรับรองว่าข้อความดังกล่าวข้างต้นเป็นความจริง

ให้ไว้ ณ วันที่ ๑๕ เดือนพฤศจิกายน พ.ศ. ๒๕๖๓



(นายบุญสืบ พมพ์โพธิ์)

นายกองค์การบริหารส่วนตำบลตาสีห์

### 6.13 เบอร์ประสานงานกรณีเกิดเหตุฉุกเฉิน



## เบอร์โทรศัพท์ กรณีฉุกเฉิน

- |  |                         |
|--|-------------------------|
| 1.ช่างอาคารมาบยางพร  | 061-384-7011            |
| 2.แจ้งเหตุไฟไหม้ งานป้องกันสาธารณะ อบต.มาบยางพร                      | 038-659679,086-849-4442 |
| 3.อบต.มาบยางพร   | 038-659-314             |
| 4.แจ้งเหตุไฟฟ้าขัดข้อง การไฟฟ้าส่วนภูมิภาค                           | 038-659-070             |
| 5.แจ้งน้ำประปาไม่ไหล การประปาส่วนภูมิภาค                             | 038-222-461             |
| 6.โรงพยาบาล กรุงเทพมหานคร โทร 038 921921 , 038 921999 (สายด้วย 1719) |                         |
| 7.สายด่วนเหตุร้าย  | 191                     |
| 8.กระทรวงแรงงาน สายด่วน  | 1506                    |
| 9.โรงพยาบาลปลวกแดง   | 038 659 005             |
| 10.สถานีตำรวจภูธรปลวกแดง   | 0-3865-9201             |
| 11.ตรวจคนเข้าเมืองชลบุรี   | 038-252750-4            |



## 紧急救助电话

1. MAPYANGPHORN 公寓维修 061-384-7011
2. 火灾报警 社会治安 MAPTYANGPHORN 居委会 038-659679,086-849-4442
3. MAPTYANGPHORN 居委会 038-659-314
4. 电中断，省电力局 038-659-070
5. 自来水不流，自来水厂 038-222-461
6. 曼谷-罗勇医院 打 038 921921 , 038 921999 (紧急线 1719)
7. 救助紧急线 191
8. 劳工部 紧急线 1506
9. PLUAKDAENG 医院 038 659 005
10. PLUAKDAENG 警察局 0-3865-9201
11. 春武里移民局 038-252750-4

#### 6.14 ตัวอย่างแบบฟอร์มของโครงการที่มีการกรอกข้อมูลประวัติส่วนตัวของผู้เข้า



บริษัท อีเอสบี วัน จำกัด (สาขาที่ 1) 159 หมู่ที่ 6 ตำบลมาบยางพร อำเภอลวกแดง จังหวัดระยอง 21140 โทร. 033-005968  
ESB One Co., Ltd. (Branch Office 1) 159 Moo. 6, Mabyangpom, Pluakdaeng, Rayong 21140 Tel. 033-005968

นิติบุคคลเลขที่ 0105556132151  
Tax ID: 0105556132151

เอกสารลงทะเบียนเข้าพัก / REGISTRATION FORM / 登记表

เลขที่สัญญา / Contract No.: ..... รหัสผู้เช่า / Customer Code: ..... อาคาร / Building: E ห้องเลขที่ / Room No. 304  
วันที่ย้ายเข้า / Check in Date: 30/09/2022 เวลา / Time: ..... ระยะเวลา / Period from: ..... ถึง / To: .....



เอกสารนี้มีการเก็บรวบรวมข้อมูลส่วนบุคคล ตาม พ.ร.บ.คุ้มครองข้อมูลส่วนบุคคล พ.ศ. 2562 โดยใช้ฐานสัญญาและฐานประโยชน์อันชอบด้วยกฎหมาย เพื่อนำไปประมวลผลในการให้บริการและปฏิบัติตามสัญญา ท่านสามารถดู "ประกาศเกี่ยวกับการคุ้มครองข้อมูลส่วนบุคคล (Privacy Notice) บริษัทในเครือโครงการเอเพ็กซ์ อพาร์ทเมนต์" ฉบับเต็มได้ที่กระดานติดประกาศ ณ สำนักงานขาย หรือสแกน QR Code นี้





# Accessory and Facilities Checklist รายการตรวจสอบเช็คความพร้อมเรียบร้อยอุปกรณ์และสิ่งอำนวยความสะดวกในห้องพัก

โครงการ/Project Pa อาคาร/Building E เลขที่ห้อง/Room No 304 วันที่เข้าพัก/Arrival Date 30/9/22

ประเภทห้อง/Room Specification FUR

รายการ / Item/项目	ย้ายเข้า / Check In/入住		ย้ายออก / Check Out/退房		จำนวนจุดปรับ No. of damage 损坏数量	หมายเหตุ Remark 备注
	ปกติ / Normal/普通	ผิดปกติ / Damage/损坏	ปกติ / Normal/普通	ผิดปกติ / Damage/损坏		
ภายในห้อง / Bedroom/宿舍里						
1 ผนังและสีผนัง / Wall And Paint / 墙和墙色	✓					
2 ฝ้าเพดาน / Ceiling / 天花板	✓					
3 ไฟเพดาน / Ceiling Light / 天花灯	✓					
4 สวิตช์ / Switch / 开关	✓					
5 ประตูทางเข้า / Entrance Door / 宿舍门	✓					
6 กรอบประตูห้อง / Door Frame / 宿舍门框	✓					
7 ลูกบิดประตู / Door Knob / 门把手	✓					
8 หน้าต่าง / Window / 窗户	✓					
9 มุ้งลวด / Mosquito Net / 蚊帐	✓					
10 บานเกล็ด / Louver / 百叶窗	✓					
11 ปลั๊กไฟ / Outlet Plug / 插座	✓					
12 กระเบื้องพื้น / Floor Tiles / 地砖	✓					
13 ขอบพื้น พีวีซี / PVC Floor Skirting / 地砖 pvc 胶	✓					
14 คานมว / Door Viewer / 门眼	✓					
15 ตู้เสื้อผ้า / Wardrobe / 柜子	✓					
16 เก้าอี้ / Chairs / 椅子	✓					
17 โต๊ะ / Table / 桌子	✓					
18 เตียง / Bed / 床	✓					
19 ที่นอน / Mattress / 床垫	✓					
20 พัดลมผนัง / Wall Fan / 风扇	✓					
21 แอร์ / Air Conditioner / 空调						
22 รีโมทแอร์ / Air Conditioner Remote Control/ 空调遥控器						
23 คอมเพรสเซอร์แอร์ / Air Conditioner Compressor / 空调压缩机						
ห้องน้ำ / Bathroom/浴室						
24 ประตูห้องน้ำ / Bathroom Door / 浴室门	✓					
25 กรอบประตู / Door Frame / 浴室门框	✓					
26 ลูกบิดประตู / Door Knob / 门把手	✓					
27 กระเบื้อง / Floor Tiles / 地砖	✓					
28 ราวตากผ้า / Clothesline / 晾衣绳	✓					
29 ลีกริน / Shower / 淋浴	✓					
30 ก๊อกน้ำ / Faucet / 水龙头	✓					
31 ชั้นวางสบู่ / Soap Shelf/ 肥皂架	✓					
32 ชักโครก / Flush Toilet / 马桶	✓					
33 สายชำระ / Bidet Spray / 坐浴盆喷雾	✓					
34 ที่ใส่กระดาษชำระ / Tissue Holder / 纸巾架	✓					
35 ไฟเพดาน / Ceiling Light / 天花灯	✓					
36 สวิตช์ / Switch / 开关	✓					
37 เครื่องทำน้ำอุ่น / Water Heater / 热水器	✓					
ระเบียง / Balcony/阳台						
38 ประตูระเบียง / Balcony Door / 阳台门	✓					
39 กรอบประตู / Door Frame / 阳台门框	✓					
40 ลูกบิดประตู / Door Knob / 门把手	✓					
41 อ่างล้างหน้า / Wash Basin / 洗脸盆	✓					
42 กระจก / Mirror / 镜子	✓					
43 ลูกยางอุดอ่าง / Rubber Tub Stopper / 洗脸盆橡胶塞	✓					
44 ก๊อกน้ำอ่างล้างหน้า / Washbasin Faucet / 洗脸盆龙头	✓					
45 ชั้นวางหม้ออ่าง / Shelf / 架	✓					
46 ไฟเพดาน / Ceiling Light / 天花灯	✓					
47 สวิตช์ / Switch / 开关	✓					
48 พื้นระเบียง / Floor Tiles / 阳台地砖	✓					
อื่นๆ / Others/其他						
49 กุญแจห้อง / Room Key / 宿舍钥匙	✓					
50 กุญแจระเบียง / Balcony Key / 阳台钥匙						
51 กุญแจตู้เสื้อผ้า / Wardrobe Key / 柜子钥匙						
52 กุญแจกล่องจดหมาย / Mailbox Key / 邮箱钥匙						
53 โทรทัศน์ / Television / 电视						
54 ตู้เย็น / Refrigerator / 冰箱						

#### **6.15 แบบโครงสร้างอาคารของโครงการ**

# ESB ONE Co.,Ltd.

75 White Group Tower 2, 11<sup>th</sup> Fl., Soi Rubia, Sukhumvit 42,  
Prakanong, Khlongtoey, Bangkok, Thailand

## โครงการอาคารพักอาศัยรวม

### LCH-PROJECT 1

#### อาคาร TYPE 1 A,C,E,G,I,J,L,N,Q,R

#### - STRUCTURE AS-BUILT - แบบก่อสร้างจริง



TESCO LTD. CONSULTING ENGINEERS  
21/11-14 SOI SUKHUMVIT 18 ,BANGKOK 10110  
TEL. 259-6573 (10 LINES AUTOMATIC) FAX 258-1313

JUNE 2017

#### DRAWING SET

- ☐ A แบบสถาปัตยกรรม  
ARCHITECTURE
- ☐ I แบบสถาปัตยกรรมภายใน  
INTERIOR
- ☐ L แบบภูมิสถาปัตยกรรม  
LANDSCAPE
- ☐ C แบบวิศวกรรมโยธา  
CIVIL

#### ☒ S แบบวิศวกรรมโครงสร้าง STRUCTURE


- ☐ AC แบบวิศวกรรมระบบปรับอากาศและระบายอากาศ  
AIR CONDITIONING AND VENTILATING
- ☐ SN แบบวิศวกรรมระบบสุขาภิบาล  
SANITARY
- ☐ EE แบบวิศวกรรมไฟฟ้าและสื่อสาร  
ELECTRICAL AND COMMUNICATION

#### ISSUED OF PACKAGE

- ☐ แบบเพื่อการประสานงาน  
CO-ORDINATION
- ☐ แบบขออนุญาตปลูกสร้าง  
AUTHORITY SUBMITTAL
- ☐ แบบประกวดราคา  
BIDDING DOCUMENT
- ☐ แบบคู่สัญญาก่อสร้าง  
CONTRACT DOCUMENT


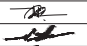




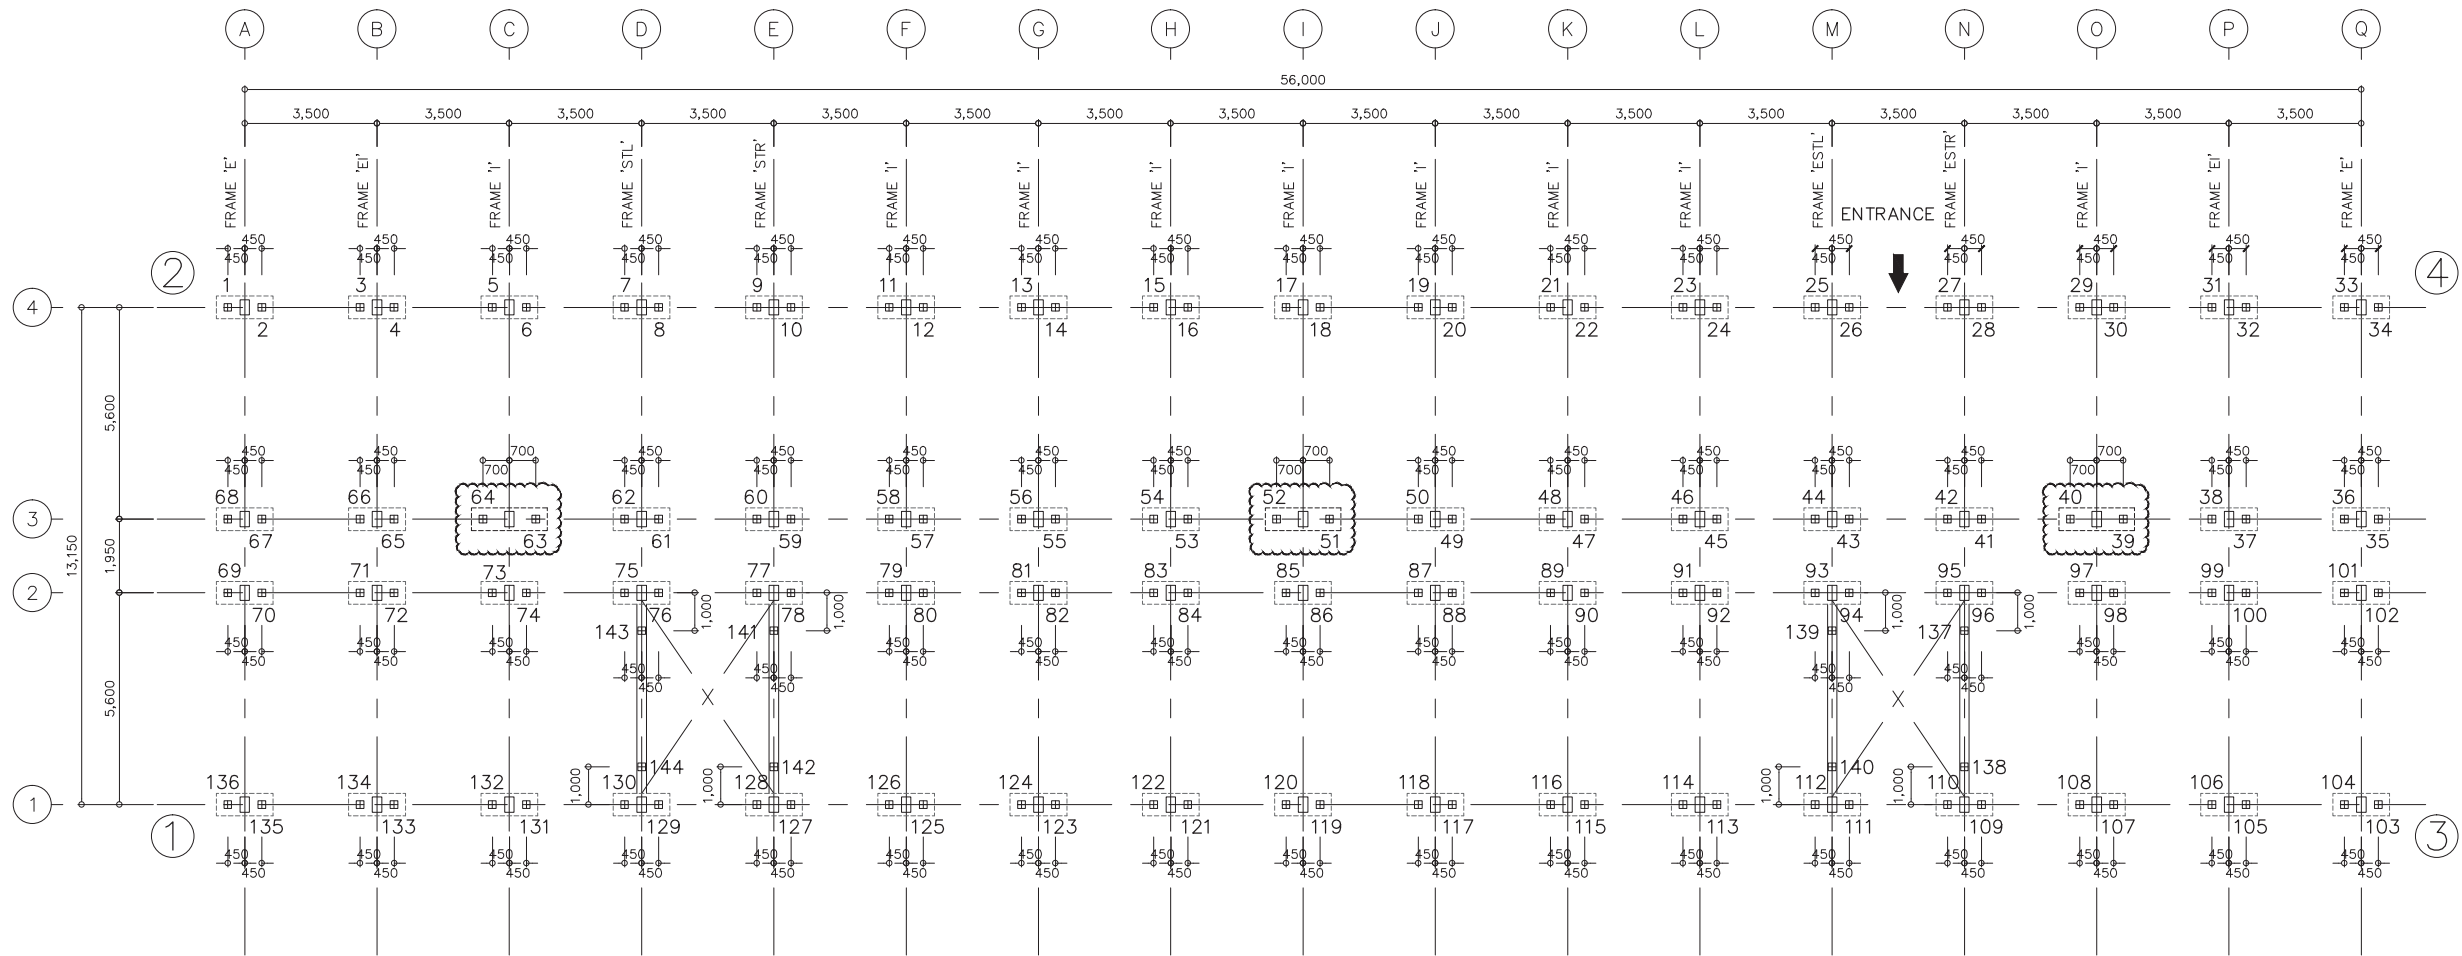


DRAWING LIST LCH1 STRUCTURAL DRAWING (TYPE 1)

[illegible][illegible]



BUILDING A  
PILING PLAN (TYPE 1)  
SCALE 1:100

PILE NO.	N	E	PILE NO.	N	E	PILE NO.	N	E	PILE NO.	N	E	PILE NO.	N	E	PILE NO.	N	E
1	N. 1436330.5887	E. 731612.4595	26	N. 1436290.4763	E. 731597.2476	51	N. 1436305.3185	E. 731596.8871	76	N. 1436322.6066	E. 731601.3578	101	N. 1436280.9046	E. 731585.5431	126	N. 1436318.8887	E. 731593.9587
2	N. 1436329.7472	E. 731612.1404	27	N. 1436288.0452	E. 731596.3257	52	N. 1436306.6275	E. 731597.3836	77	N. 1436320.1755	E. 731600.4359	102	N. 1436280.0631	E. 731585.2240	127	N. 1436321.3197	E. 731594.8806
3	N. 1436327.3161	E. 731611.2185	28	N. 1436287.2037	E. 731596.0066	53	N. 1436308.8248	E. 731598.2168	78	N. 1436319.3340	E. 731600.1167	103	N. 1436282.0488	E. 731579.9878	128	N. 1436322.1612	E. 731595.1998
4	N. 1436326.4746	E. 731610.8994	29	N. 1436284.7726	E. 731595.0846	54	N. 1436309.6664	E. 731598.5360	79	N. 1436316.9030	E. 731599.1948	104	N. 1436282.8903	E. 731580.3070	129	N. 1436324.5923	E. 731596.1217
5	N. 1436324.0435	E. 731609.9774	30	N. 1436283.9311	E. 731594.7655	55	N. 1436312.0974	E. 731599.4579	80	N. 1436316.0614	E. 731598.8757	105	N. 1436285.3214	E. 731581.2289	130	N. 1436325.4338	E. 731596.4408
6	N. 1436323.2020	E. 731609.6583	31	N. 1436281.5000	E. 731593.8436	56	N. 1436312.9389	E. 731599.7770	81	N. 1436313.6304	E. 731597.9537	106	N. 1436286.1629	E. 731581.5480	131	N. 1436327.8649	E. 731597.3627
7	N. 1436320.7710	E. 731608.7364	32	N. 1436280.6585	E. 731593.5244	57	N. 1436315.3700	E. 731600.6990	82	N. 1436312.7889	E. 731597.6346	107	N. 1436288.5940	E. 731582.4700	132	N. 1436328.7064	E. 731597.6819
8	N. 1436319.9295	E. 731608.4172	33	N. 1436278.2275	E. 731592.6025	58	N. 1436316.2115	E. 731601.0181	83	N. 1436310.3578	E. 731596.7127	108	N. 1436289.4355	E. 731582.7891	133	N. 1436331.1375	E. 731598.6038
9	N. 1436317.4984	E. 731607.4953	34	N. 1436277.3860	E. 731592.2834	59	N. 1436318.6426	E. 731601.9400	84	N. 1436309.5163	E. 731596.3936	109	N. 1436291.8665	E. 731583.7110	134	N. 1436331.9790	E. 731598.9229
10	N. 1436316.6569	E. 731607.1762	35	N. 1436279.3717	E. 731587.0473	60	N. 1436319.4841	E. 731602.2592	85	N. 1436307.0852	E. 731595.4716	110	N. 1436292.7081	E. 731584.0302	135	N. 1436334.4100	E. 731599.8449
11	N. 1436314.2258	E. 731606.2542	36	N. 1436280.2132	E. 731587.3664	61	N. 1436321.9152	E. 731603.1811	86	N. 1436306.2437	E. 731595.1525	111	N. 1436295.1391	E. 731584.9521	136	N. 1436335.2516	E. 731600.1640
12	N. 1436313.3843	E. 731605.9351	37	N. 1436282.6442	E. 731588.2883	62	N. 1436322.7567	E. 731603.5002	87	N. 1436303.8127	E. 731594.2306	112	N. 1436295.9806	E. 731585.2712	137	N. 1436290.6562	E. 731588.1717
13	N. 1436310.9532	E. 731605.0132	38	N. 1436283.4858	E. 731588.6075	63	N. 1436324.9540	E. 731604.3335	88	N. 1436302.9711	E. 731593.9114	113	N. 1436298.4117	E. 731586.1932	138	N. 1436291.9327	E. 731584.8056
14	N. 1436310.1117	E. 731604.6940	39	N. 1436285.6831	E. 731589.4407	64	N. 1436326.2630	E. 731604.8299	89	N. 1436300.5401	E. 731592.9895	114	N. 1436299.2532	E. 731586.5123	139	N. 1436293.9288	E. 731589.4128
15	N. 1436307.6807	E. 731603.7721	40	N. 1436286.9921	E. 731589.9372	65	N. 1436328.4603	E. 731605.6632	90	N. 1436299.6986	E. 731592.6704	115	N. 1436301.6843	E. 731587.4342	140	N. 1436295.2053	E. 731586.0467
16	N. 1436306.8391	E. 731603.4530	41	N. 1436289.1894	E. 731590.7705	66	N. 1436329.3018	E. 731605.9824	91	N. 1436297.2675	E. 731591.7484	116	N. 1436302.5258	E. 731587.7534	141	N. 1436320.1094	E. 731599.3413
17	N. 1436304.4081	E. 731602.5310	42	N. 1436290.0309	E. 731591.0896	67	N. 1436331.7329	E. 731606.9043	92	N. 1436296.4260	E. 731591.4293	117	N. 1436304.9568	E. 731588.6753	142	N. 1436321.3859	E. 731595.9752
18	N. 1436303.5666	E. 731602.2119	43	N. 1436292.4620	E. 731592.0115	68	N. 1436332.5744	E. 731607.2234	93	N. 1436293.9949	E. 731590.5074	118	N. 1436305.7984	E. 731588.9944	143	N. 1436323.3820	E. 731600.5824
19	N. 1436301.1355	E. 731601.2900	44	N. 1436293.3035	E. 731592.3307	69	N. 1436333.2659	E. 731605.4001	94	N. 1436293.1534	E. 731590.1882	119	N. 1436308.2294	E. 731589.9164	144	N. 1436324.6585	E. 731597.2163
20	N. 1436300.2940	E. 731600.9708	45	N. 1436295.7345	E. 731593.2526	70	N. 1436332.4243	E. 731605.0810	95	N. 1436290.7224	E. 731589.2663	120	N. 1436309.0709	E. 731590.2355			
21	N. 1436297.8629	E. 731600.0489	46	N. 1436296.5761	E. 731593.5717	71	N. 1436329.9933	E. 731604.1591	96	N. 1436289.8808	E. 731588.9472	121	N. 1436311.5020	E. 731591.1574			
22	N. 1436297.0214	E. 731599.7298	47	N. 1436299.0071	E. 731594.4936	72	N. 1436329.1518	E. 731603.8399	97	N. 1436287.4498	E. 731588.0252	122	N. 1436312.3435	E. 731591.4766			
23	N. 1436294.5904	E. 731598.8078	48	N. 1436299.8486	E. 731594.8128	73	N. 1436326.7207	E. 731602.9180	98	N. 1436286.6083	E. 731587.7061	123	N. 1436314.7746	E. 731592.3985			
24	N. 1436293.7488	E. 731598.4887	49	N. 1436302.2797	E. 731595.7347	74	N. 1436325.8792	E. 731602.5989	99	N. 1436284.1772	E. 731586.7842	124	N. 1436315.6161	E. 731592.7176			
25	N. 1436291.3178	E. 731597.5668	50	N. 1436303.1212	E. 731596.0538	75	N. 1436323.4481	E. 731601.6769	100	N. 1436283.3357	E. 731586.4650	125	N. 1436318.0472	E. 731593.6396			


 <b>TESCO LTD. CONSULTING ENGINEERS</b> 21/11-14 SOI SUKHUMVIT 18 , BANGKOK 10110 TEL. 259-8573 (10 LINES AUTOMATIC) FAX 258-1313					
DESIGN	NAME	SIGNATURE	DESIGN	NAME	SIGNATURE
ARCHITECT	NARAE T. ๕๓๓.1821		MECHANICAL ENGINEER	POTE L. ๕๓๓.2055	
	PIYA S. ๖๓๓.9661			WICHAN T. ๓๓๓.14151	
STRUCTURAL ENGINEER	YUTTANA C. ๕๓๓.6404		ELECTRICAL ENGINEER	TOSAPHON B. ๕๓๓.2341	
CIVIL ENGINEER	PASIT T. ๕๓๓.2706		SANITARY ENGINEER	PASIT T. ๕๓๓.2706	
DATE 28/1/2014					



บริษัท ไทยเอสซีเอส จำกัด  
(สำนักงานใหญ่)  
537/102 ถนนสายประดิษฐ์ แขวงจันทนาภิรมย์  
เขตจันทนาภิรมย์ กรุงเทพมหานคร 10120



REV.	REVISION	DATE	APPR.	APPROVAL		ESB ONE	ESB ONE CO.,LTD		
MARK				ISSUED FOR			75 White Group Tower 2, 11 <sup>th</sup> Fl., Soi Rubin, Sukhumvit 42, Prakanong, Khlongtoey, Bangkok, Thailand	LCH – PROJECT 1	SCALE
△	–	–	–	CONSTRUCTION		PROJECT			
△	–	–	–	DATE	–	CLIENTS ADDRESS	PILING PLAN BUILDING A		
△	–	–	–	APPROVED	–	DRAWING TITLE			
△	–	–	–	ORDER NO.	–				
△	–	–	–	CONTRACTOR	–				
△	–	–	–	CONTRACT DATE	–				
△	AS–BUILT	18/08/60	–						

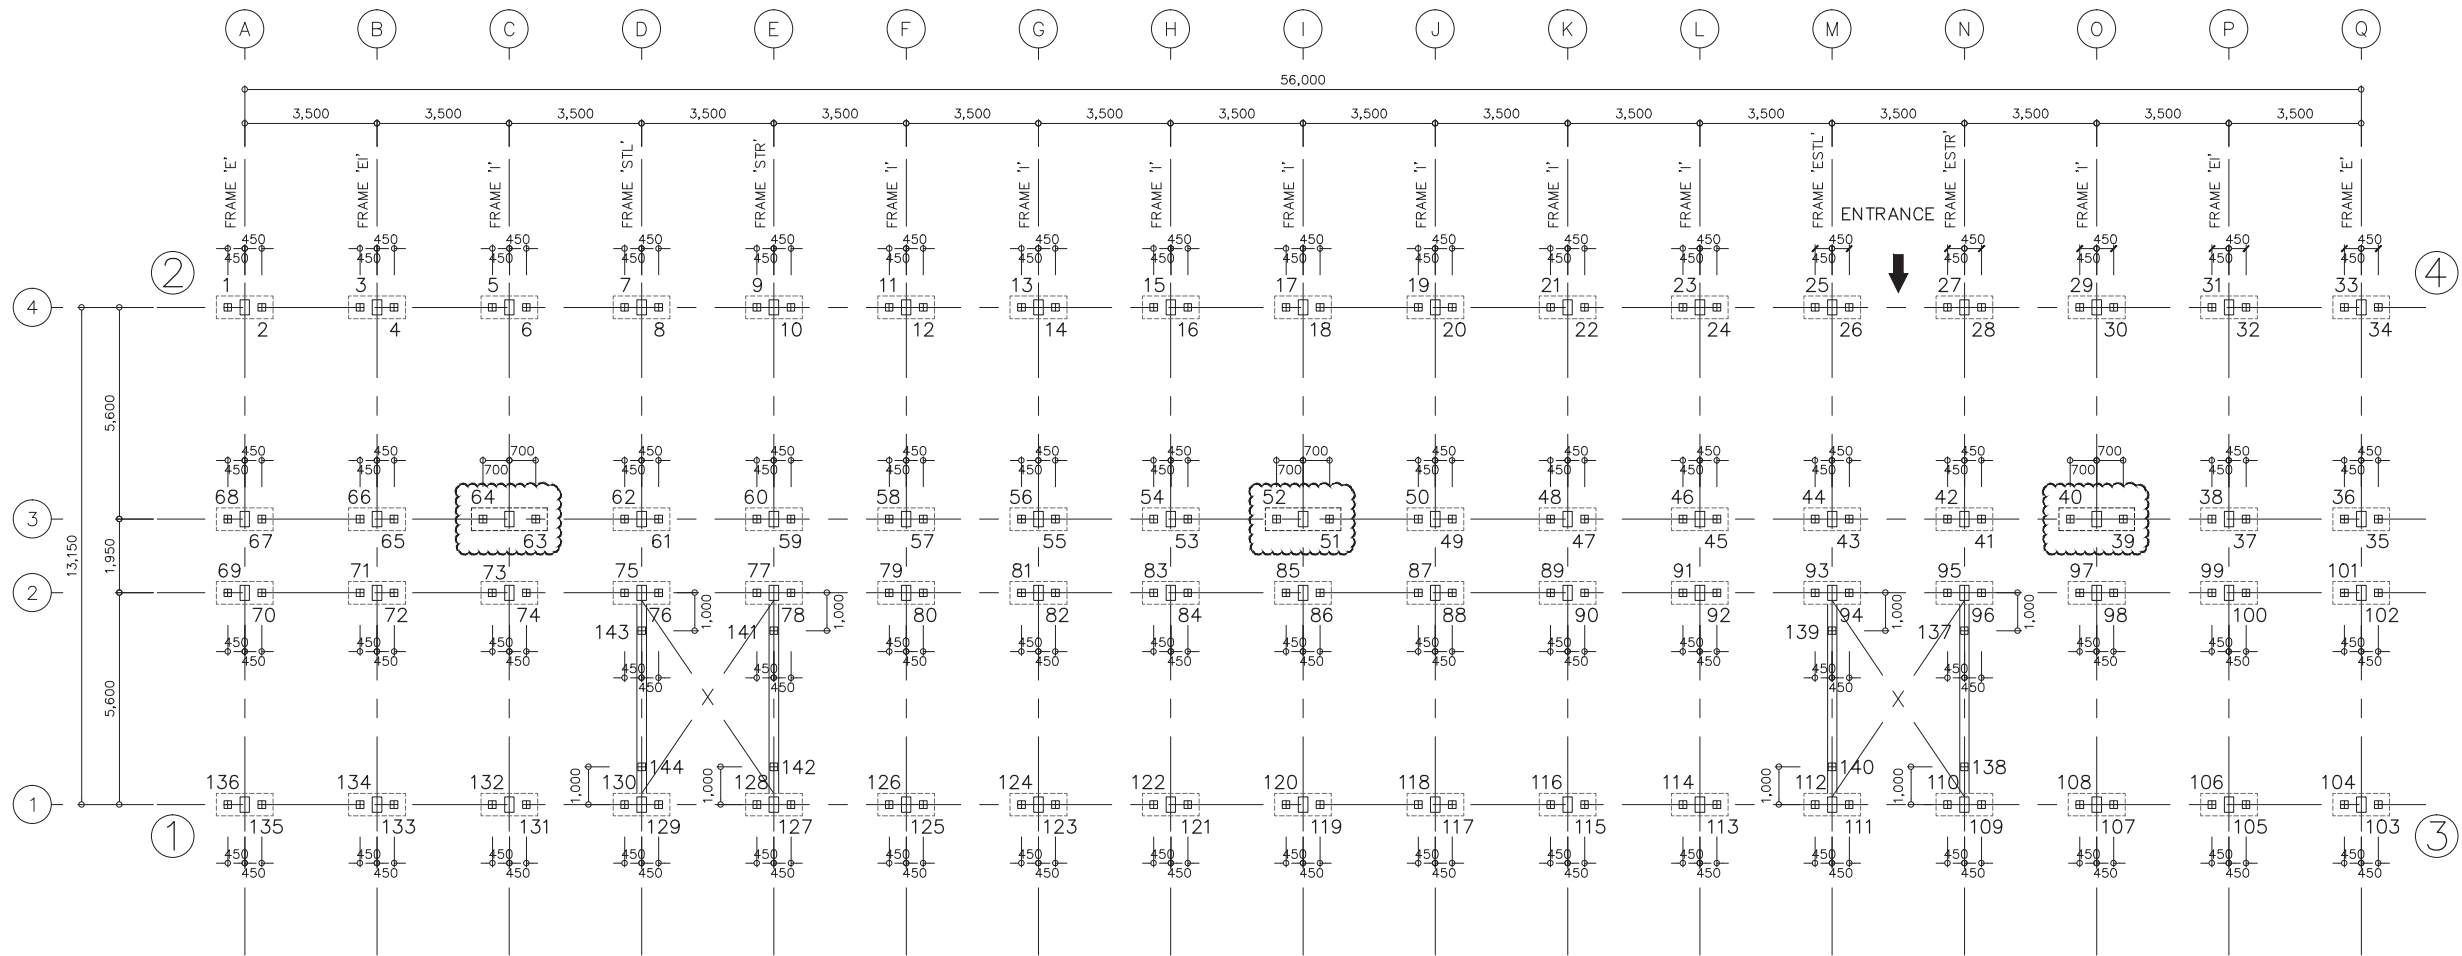




BUILDING C  
PILING PLAN (TYPE 1)  
SCALE 1:100






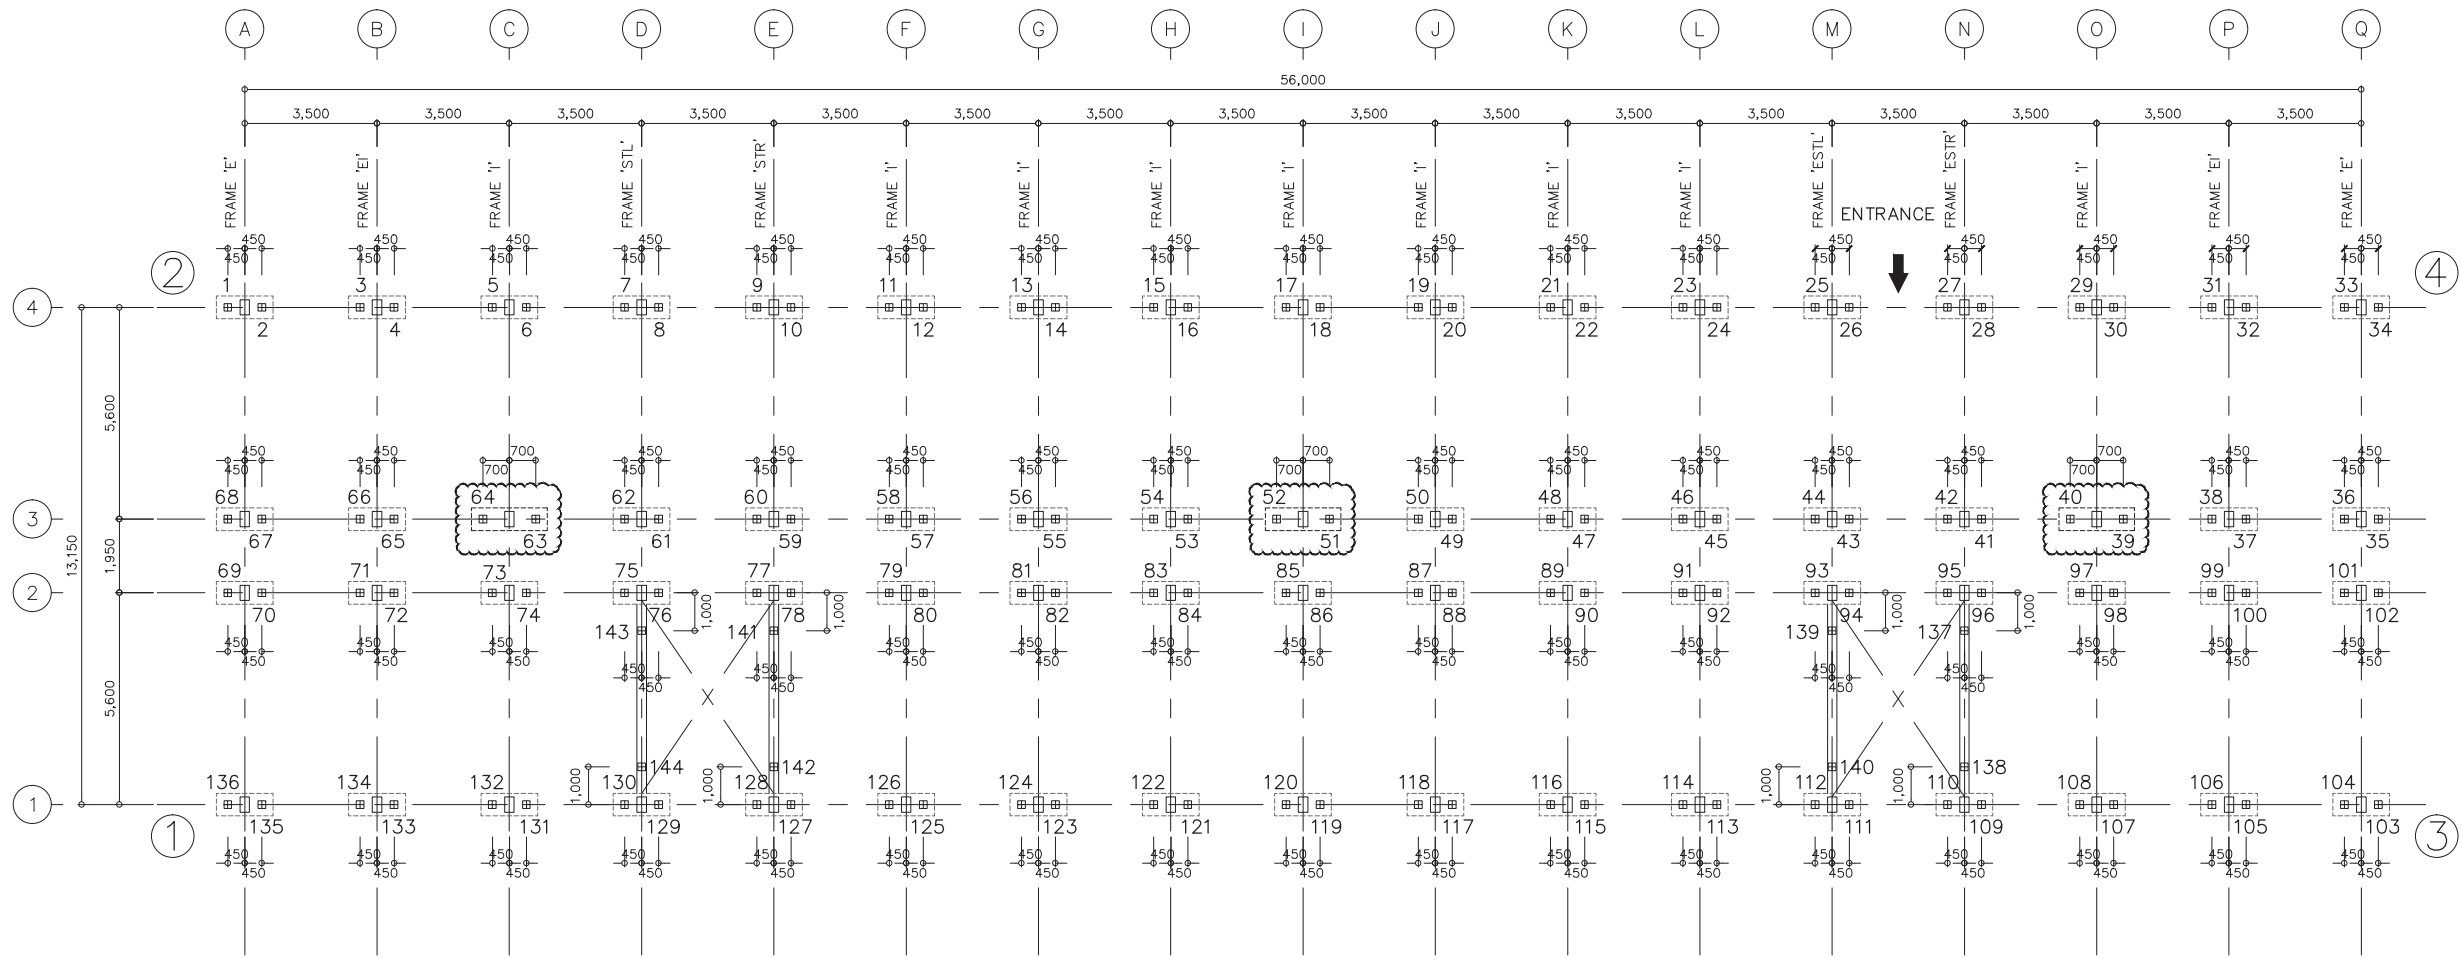




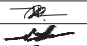




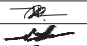


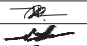







PILE NO.	N	E	PILE NO.	N	E	PILE NO.	N	E	PILE NO.	N	E	PILE NO.	N	E	PILE NO.	N	E
1	N. 1436312.4337	E. 731660.3327	26	N. 1436272.3213	E. 731645.1208	51	N. 1436287.1635	E. 731644.7603	76	N. 1436304.4516	E. 731649.2309	101	N. 1436262.7496	E. 731633.4162	126	N. 1436300.7337	E. 731641.8318
2	N. 1436311.5922	E. 731660.0135	27	N. 1436269.8902	E. 731644.1988	52	N. 1436288.4725	E. 731645.2567	77	N. 1436302.0205	E. 731648.3090	102	N. 1436261.9081	E. 731633.0971	127	N. 1436303.1647	E. 731642.7537
3	N. 1436309.1611	E. 731659.0916	28	N. 1436269.0487	E. 731643.8797	53	N. 1436290.6698	E. 731646.0900	78	N. 1436301.1790	E. 731647.9899	103	N. 1436263.8938	E. 731627.8610	128	N. 1436304.0062	E. 731643.0729
4	N. 1436308.3196	E. 731658.7725	29	N. 1436266.6176	E. 731642.9578	54	N. 1436291.5114	E. 731646.4091	79	N. 1436298.7480	E. 731647.0679	104	N. 1436264.7353	E. 731628.1801	129	N. 1436306.4373	E. 731643.9948
5	N. 1436305.8885	E. 731657.8505	30	N. 1436265.7761	E. 731642.6386	55	N. 1436293.9424	E. 731647.3310	80	N. 1436297.9064	E. 731646.7488	105	N. 1436267.1664	E. 731629.1020	130	N. 1436307.2788	E. 731644.3139
6	N. 1436305.0470	E. 731657.5314	31	N. 1436263.3450	E. 731641.7167	56	N. 1436294.7839	E. 731647.6502	81	N. 1436295.4754	E. 731645.8269	106	N. 1436268.0079	E. 731629.4212	131	N. 1436309.7099	E. 731645.2359
7	N. 1436302.6160	E. 731656.6095	32	N. 1436262.5035	E. 731641.3976	57	N. 1436297.2150	E. 731648.5721	82	N. 1436294.6339	E. 731645.5077	107	N. 1436270.4390	E. 731630.3431	132	N. 1436310.5514	E. 731645.5550
8	N. 1436301.7744	E. 731656.2903	33	N. 1436260.0725	E. 731640.4756	58	N. 1436298.0565	E. 731648.8912	83	N. 1436292.2028	E. 731644.5858	108	N. 1436271.2805	E. 731630.6622	133	N. 1436312.9825	E. 731646.4769
9	N. 1436299.3434	E. 731655.3684	34	N. 1436259.2310	E. 731640.1565	59	N. 1436300.4876	E. 731649.8132	84	N. 1436291.3613	E. 731644.2667	109	N. 1436273.7115	E. 731631.5842	134	N. 1436313.8240	E. 731646.7961
10	N. 1436298.5019	E. 731655.0493	35	N. 1436261.2167	E. 731634.9204	60	N. 1436301.3291	E. 731650.1323	85	N. 1436288.9302	E. 731643.3447	110	N. 1436274.5531	E. 731631.9033	135	N. 1436316.2550	E. 731647.7180
11	N. 1436296.0708	E. 731654.1273	36	N. 1436262.0582	E. 731635.2395	61	N. 1436303.7602	E. 731651.0542	86	N. 1436288.0887	E. 731643.0256	111	N. 1436276.9841	E. 731632.8252	136	N. 1436317.0966	E. 731648.0371
12	N. 1436295.2293	E. 731653.8082	37	N. 1436264.4892	E. 731636.1615	62	N. 1436304.6017	E. 731651.3734	87	N. 1436285.6577	E. 731642.1037	112	N. 1436277.8256	E. 731633.1444	137	N. 1436272.5012	E. 731636.0448
13	N. 1436292.7982	E. 731652.8863	38	N. 1436265.3308	E. 731636.4806	63	N. 1436306.8041	E. 731652.2086	88	N. 1436284.8161	E. 731641.7845	113	N. 1436280.2567	E. 731634.0663	138	N. 1436273.7777	E. 731632.6788
14	N. 1436291.9567	E. 731652.5672	39	N. 1436267.5281	E. 731637.3139	64	N. 1436308.1080	E. 731652.7031	89	N. 1436282.3851	E. 731640.8626	114	N. 1436281.0982	E. 731634.3854	139	N. 1436275.7738	E. 731637.2859
15	N. 1436289.5257	E. 731651.6452	40	N. 1436268.8371	E. 731637.8103	65	N. 1436310.3053	E. 731653.5364	90	N. 1436281.5436	E. 731640.5435	115	N. 1436283.5293	E. 731635.3074	140	N. 1436277.0503	E. 731633.9198
16	N. 1436288.6841	E. 731651.3261	41	N. 1436271.0344	E. 731638.6436	66	N. 1436311.1468	E. 731653.8555	91	N. 1436279.1125	E. 731639.6215	116	N. 1436284.3708	E. 731635.6265	141	N. 1436301.9544	E. 731647.2144
17	N. 1436286.2531	E. 731650.4042	42	N. 1436271.8759	E. 731638.9627	67	N. 1436313.5779	E. 731654.7774	92	N. 1436278.2710	E. 731639.3024	117	N. 1436286.8018	E. 731636.5484	142	N. 1436303.2309	E. 731643.8483
18	N. 1436285.4116	E. 731650.0850	43	N. 1436274.3070	E. 731639.8846	68	N. 1436314.4194	E. 731655.0965	93	N. 1436275.8399	E. 731638.3805	118	N. 1436287.6434	E. 731636.8676	143	N. 1436305.2270	E. 731648.4555
19	N. 1436282.9805	E. 731649.1631	44	N. 1436275.1485	E. 731640.2038	69	N. 1436315.1109	E. 731653.2733	94	N. 1436274.9984	E. 731638.0614	119	N. 1436290.0744	E. 731637.7895	144	N. 1436306.5035	E. 731645.0894
20	N. 1436282.1390	E. 731648.8440	45	N. 1436277.5795	E. 731641.1257	70	N. 1436314.2693	E. 731652.9541	95	N. 1436272.5674	E. 731637.1394	120	N. 1436290.9159	E. 731638.1086			
21	N. 1436279.7079	E. 731647.9220	46	N. 1436278.4211	E. 731641.4448	71	N. 1436311.8383	E. 731652.0322	96	N. 1436271.7258	E. 731636.8203	121	N. 1436293.3470	E. 731639.0306			
22	N. 1436278.8664	E. 731647.6029	47	N. 1436280.8521	E. 731642.3668	72	N. 1436310.9968	E. 731651.7131	97	N. 1436269.2948	E. 731635.8984	122	N. 1436294.1885	E. 731639.3497			
23	N. 1436276.4354	E. 731646.6810	48	N. 1436281.6936	E. 731642.6859	73	N. 1436308.5657	E. 731650.7911	98	N. 1436268.4533	E. 731635.5792	123	N. 1436296.6196	E. 731640.2716			
24	N. 1436275.5938	E. 731646.3618	49	N. 1436284.1247	E. 731643.6078	74	N. 1436307.7242	E. 731650.4720	99	N. 1436266.0222	E. 731634.6573	124	N. 1436297.4611	E. 731640.5907			
25	N. 1436273.1628	E. 731645.4399	50	N. 1436284.9662	E. 731643.9270	75	N. 1436305.2931	E. 731649.5501	100	N. 1436265.1807	E. 731634.3382	125	N. 1436299.8922	E. 731641.5127			

 <b>TESCO LTD. CONSULTING ENGINEERS</b> 21/11-14 SOI SUKHUMVIT 18 , BANGKOK 10110 TEL. 259-8573 (10 LINES AUTOMATIC) FAX 258-1313						 <b>ESB ONE</b> 75 White Group Tower 2, 11 <sup>th</sup> Fl., Soi Rubin, Sukhumvit 42, Prakanong, Khlongtoey, Bangkok, Thailand															
DESIGN		NAME	SIGNATURE	DESIGN		NAME	SIGNATURE	DATE		REV. MARK		REVISION		DATE	APPR.	APPROVAL		ESB ONE		ESB ONE CO.,LTD	
ARCHITECT		NARAE T.	๒๕๓.๑๘๒๑	MECHANICAL ENGINEER		POTE L.	๒๕๓.๒๐๕๕	28/1/2014		1		-		-	-	ISSUED FOR		PROJECT		LCH - PROJECT 1	
		PIYA S.	๒๕๓.๑๙๖๑			WICHAN T.	๒๕๓.๑๙๖๑			2		-		-	-	CONSTRUCTION		CLIENTS ADDRESS		MAPYANGPHON PLUAK-DAENG RAYONG	
STRUCTURAL ENGINEER		YUTTANA C.	๒๕๓.๑๙๖๑	ELECTRICAL ENGINEER		TOSAPHON B.	๒๕๓.๑๙๖๑			3		-		-	-	DATE		DRAWING TITLE		PILING PLAN	
CIVIL ENGINEER		PASIT T.	๒๕๓.๑๙๖๑	SANITARY ENGINEER		PASIT T.	๒๕๓.๑๙๖๑			4		-		-	-	ORDER NO.				Building C	
										5		-		-	-	CONTRACTOR				DRAWING NO.	
										6		-		-	-	CONTRACT DATE				LCH1-T1C-ST-101	
										7		-		-	-					REV.	
										8		-		-	-					0	













BUILDING E  
PILING PLAN (TYPE 1)  
SCALE 1:100

PILE NO.	N	E	PILE NO.	N	E	PILE NO.	N	E	PILE NO.	N	E	PILE NO.	N	E	PILE NO.	N	E
1	N. 1436294.2787	E. 731708.2058	26	N. 1436254.1663	E. 731692.9939	51	N. 1436269.0085	E. 731692.6464	76	N. 1436286.2966	E. 731697.1041	101	N. 1436244.5946	E. 731681.2893	126	N. 1436282.5787	E. 731689.7049
2	N. 1436293.4372	E. 731707.8867	27	N. 1436251.7352	E. 731692.0720	52	N. 1436270.3175	E. 731693.1298	77	N. 1436283.8655	E. 731696.1821	102	N. 1436243.7531	E. 731680.9702	127	N. 1436285.0097	E. 731690.6269
3	N. 1436291.0061	E. 731706.9647	28	N. 1436250.8937	E. 731691.7528	53	N. 1436272.5148	E. 731693.9631	78	N. 1436283.0240	E. 731695.8630	103	N. 1436245.7388	E. 731675.7341	128	N. 1436285.8512	E. 731690.9460
4	N. 1436290.1646	E. 731706.6456	29	N. 1436248.4626	E. 731690.8309	54	N. 1436273.3564	E. 731694.3101	79	N. 1436280.5930	E. 731694.9411	104	N. 1436246.5803	E. 731676.0532	129	N. 1436288.2823	E. 731691.8679
5	N. 1436287.7335	E. 731705.7237	30	N. 1436247.6211	E. 731690.5118	55	N. 1436275.7874	E. 731695.2042	80	N. 1436279.7514	E. 731694.6219	105	N. 1436249.0114	E. 731676.9752	130	N. 1436289.1238	E. 731692.1871
6	N. 1436286.8920	E. 731705.4045	31	N. 1436245.1900	E. 731689.5898	56	N. 1436276.6289	E. 731695.5233	81	N. 1436277.3204	E. 731693.7000	106	N. 1436249.8529	E. 731677.2943	131	N. 1436291.5549	E. 731693.1090
7	N. 1436284.4610	E. 731704.4826	32	N. 1436244.3485	E. 731689.2707	57	N. 1436279.0600	E. 731696.4452	82	N. 1436276.4789	E. 731693.3809	107	N. 1436252.2840	E. 731678.2162	132	N. 1436292.3928	E. 731693.4376
8	N. 1436283.6194	E. 731704.1635	33	N. 1436241.9175	E. 731688.3488	58	N. 1436279.9015	E. 731696.7643	83	N. 1436274.0478	E. 731692.4589	108	N. 1436253.1255	E. 731678.5354	133	N. 1436294.8275	E. 731694.3501
9	N. 1436281.1884	E. 731703.2415	34	N. 1436241.0760	E. 731688.0296	59	N. 1436282.3326	E. 731697.6863	84	N. 1436273.2063	E. 731692.1398	109	N. 1436255.5565	E. 731679.4573	134	N. 1436295.6690	E. 731694.6692
10	N. 1436280.3469	E. 731702.9224	35	N. 1436243.0617	E. 731682.7935	60	N. 1436283.1741	E. 731698.0054	85	N. 1436270.7752	E. 731691.2179	110	N. 1436256.3981	E. 731679.7764	135	N. 1436298.1000	E. 731695.5911
11	N. 1436277.9158	E. 731702.0005	36	N. 1436243.9032	E. 731683.1126	61	N. 1436285.6052	E. 731698.9273	86	N. 1436269.9337	E. 731690.8987	111	N. 1436258.8291	E. 731680.6984	136	N. 1436298.9416	E. 731695.9103
12	N. 1436277.0743	E. 731701.6813	37	N. 1436246.3342	E. 731684.0346	62	N. 1436286.4467	E. 731699.2465	87	N. 1436267.5027	E. 731689.9768	112	N. 1436259.6706	E. 731681.0175	137	N. 1436254.3462	E. 731683.9180
13	N. 1436274.6432	E. 731700.7594	38	N. 1436247.1758	E. 731684.3537	63	N. 1436288.6440	E. 731700.0798	88	N. 1436266.6611	E. 731689.6577	113	N. 1436262.1017	E. 731681.9394	138	N. 1436255.6227	E. 731680.5519
14	N. 1436273.8017	E. 731700.4403	39	N. 1436249.3731	E. 731685.1870	64	N. 1436289.9530	E. 731700.5762	89	N. 1436264.2301	E. 731688.7357	114	N. 1436262.9432	E. 731682.2585	139	N. 1436257.6188	E. 731685.1590
15	N. 1436271.3707	E. 731699.5183	40	N. 1436250.6821	E. 731685.6834	65	N. 1436292.1503	E. 731701.4095	90	N. 1436263.3886	E. 731688.4166	115	N. 1436265.3743	E. 731683.1805	140	N. 1436258.8953	E. 731681.7929
16	N. 1436270.5291	E. 731699.1992	41	N. 1436252.8794	E. 731686.5167	66	N. 1436292.9918	E. 731701.7286	91	N. 1436260.9575	E. 731687.4947	116	N. 1436266.2158	E. 731683.4996	141	N. 1436283.7994	E. 731695.0875
17	N. 1436268.0981	E. 731698.2773	42	N. 1436253.7209	E. 731686.8358	67	N. 1436295.4229	E. 731702.6505	92	N. 1436260.1160	E. 731687.1755	117	N. 1436268.6468	E. 731684.4215	142	N. 1436285.0759	E. 731691.7341
18	N. 1436267.2566	E. 731697.9581	43	N. 1436256.1520	E. 731687.7578	68	N. 1436296.2644	E. 731702.9697	93	N. 1436257.6849	E. 731686.2536	118	N. 1436269.4884	E. 731684.7407	143	N. 1436287.0720	E. 731696.3286
19	N. 1436264.8255	E. 731697.0362	44	N. 1436256.9935	E. 731688.0769	69	N. 1436296.9559	E. 731701.1464	94	N. 1436256.8434	E. 731685.9345	119	N. 1436271.9194	E. 731685.6626	144	N. 1436288.3485	E. 731692.9625
20	N. 1436263.9840	E. 731696.7171	45	N. 1436259.4245	E. 731688.9988	70	N. 1436296.1143	E. 731700.8272	95	N. 1436254.4124	E. 731685.0125	120	N. 1436272.7609	E. 731685.9817			
21	N. 1436261.5529	E. 731695.7952	46	N. 1436260.2661	E. 731689.3180	71	N. 1436293.6833	E. 731699.9053	96	N. 1436253.5708	E. 731684.6934	121	N. 1436275.1920	E. 731686.9037			
22	N. 1436260.7114	E. 731695.4760	47	N. 1436262.6971	E. 731690.2399	72	N. 1436292.8418	E. 731699.5862	97	N. 1436251.1398	E. 731683.7715	122	N. 1436276.0335	E. 731687.2228			
23	N. 1436258.2804	E. 731694.5541	48	N. 1436263.5386	E. 731690.5590	73	N. 1436290.4107	E. 731698.6643	98	N. 1436250.2983	E. 731683.4523	123	N. 1436278.4646	E. 731688.1447			
24	N. 1436257.4388	E. 731694.2350	49	N. 1436265.9697	E. 731691.4810	74	N. 1436289.5692	E. 731698.3451	99	N. 1436247.8672	E. 731682.5304	124	N. 1436279.3061	E. 731688.4639			
25	N. 1436255.0078	E. 731693.3130	50	N. 1436266.8112	E. 731691.8001	75	N. 1436287.1381	E. 731697.4232	100	N. 1436247.0257	E. 731682.2113	125	N. 1436281.7372	E. 731689.3858			


 <b>TESCO LTD. CONSULTING ENGINEERS</b> 21/11-14 SOI SUKHUMVIT 18 , BANGKOK 10110 TEL. 259-8573 (10 LINES AUTOMATIC) FAX 258-1313								บริษัท เอสบีวัน จำกัด (สำนักงานใหญ่) 537/102 ถนนสายประดิษฐ์ แขวงจันทนาภิรมย์ เขตจันทนาภิรมย์ กรุงเทพมหานคร 10120		<table><tr><th>REV.</th><th>REVISION</th><th>DATE</th><th>APPR.</th></tr><tr><td>△</td><td>-</td><td>-</td><td>-</td></tr><tr><td>△</td><td>-</td><td>-</td><td>-</td></tr><tr><td>△</td><td>-</td><td>-</td><td>-</td></tr><tr><td>△</td><td>-</td><td>-</td><td>-</td></tr><tr><td>△</td><td>-</td><td>-</td><td>-</td></tr><tr><td>△</td><td>-</td><td>-</td><td>-</td></tr><tr><td>△</td><td>AS-BUILT</td><td>18/08/60</td><td>-</td></tr></table>		REV.	REVISION	DATE	APPR.	△	-	-	-	△	-	-	-	△	-	-	-	△	-	-	-	△	-	-	-	△	-	-	-	△	AS-BUILT	18/08/60	-	<table><tr><th colspan="2">APPROVAL</th></tr><tr><th colspan="2">ISSUED FOR</th></tr><tr><th colspan="2">CONSTRUCTION</th></tr><tr><th>DATE</th><th>-</th></tr><tr><th>APPROVED</th><th>-</th></tr><tr><th>ORDER NO.</th><th>-</th></tr><tr><th>CONTRACTOR</th><th>-</th></tr><tr><th>CONTRACT DATE</th><th>-</th></tr></table>		APPROVAL		ISSUED FOR		CONSTRUCTION		DATE	-	APPROVED	-	ORDER NO.	-	CONTRACTOR	-	CONTRACT DATE	-	ESB ONE		ESB ONE CO.,LTD 75 White Group Tower 2, 11 <sup>th</sup> Fl., Soi Rubin, Sukhumvit 42, Prakanong, Khlongtoey, Bangkok, Thailand	
REV.	REVISION	DATE	APPR.																																																														
△	-	-	-																																																														
△	-	-	-																																																														
△	AS-BUILT	18/08/60	-																																																														
APPROVAL																																																																	
ISSUED FOR																																																																	
CONSTRUCTION																																																																	
DATE	-																																																																
APPROVED	-																																																																
ORDER NO.	-																																																																
CONTRACTOR	-																																																																
CONTRACT DATE	-																																																																
<table><tr><th>DESIGN</th><th>NAME</th><th>SIGNATURE</th><th>DESIGN</th><th>NAME</th><th>SIGNATURE</th><th>DATE</th></tr><tr><td>ARCHITECT</td><td>NARAE T. ๕๓๑.1821</td><td></td><td>MECHANICAL ENGINEER</td><td>POTE L. ๕๓๑.2055</td><td></td><td rowspan="3">28/1/2014</td></tr><tr><td></td><td>PIYA S. ๕๓๑.9661</td><td></td><td></td><td>WICHAN T. ๓๓๑.14151</td><td></td></tr><tr><td>STRUCTURAL ENGINEER</td><td>YUTTANA C. ๕๓๑.6404</td><td></td><td>ELECTRICAL ENGINEER</td><td>TOSAPHON B. ๕๓๑.2341</td><td></td></tr><tr><td>CIVIL ENGINEER</td><td>PASIT T. ๕๓๑.2706</td><td></td><td>SANITARY ENGINEER</td><td>PASIT T. ๕๓๑.2706</td><td></td><td></td><td></td></tr></table>		DESIGN	NAME	SIGNATURE	DESIGN	NAME	SIGNATURE	DATE	ARCHITECT	NARAE T. ๕๓๑.1821		MECHANICAL ENGINEER	POTE L. ๕๓๑.2055		28/1/2014		PIYA S. ๕๓๑.9661			WICHAN T. ๓๓๑.14151		STRUCTURAL ENGINEER	YUTTANA C. ๕๓๑.6404		ELECTRICAL ENGINEER	TOSAPHON B. ๕๓๑.2341		CIVIL ENGINEER	PASIT T. ๕๓๑.2706		SANITARY ENGINEER	PASIT T. ๕๓๑.2706				PROJECT CLIENTS ADDRESS DRAWING TITLE PILING PLAN Building E		LCH - PROJECT 1 MAPYANGPHON PLUAK-DAENG RAYONG SCALE 1:100 DRAWING NO. LCH1-T1E-ST-101 REV. 0																											
DESIGN	NAME	SIGNATURE	DESIGN	NAME	SIGNATURE	DATE																																																											
ARCHITECT	NARAE T. ๕๓๑.1821		MECHANICAL ENGINEER	POTE L. ๕๓๑.2055		28/1/2014																																																											
	PIYA S. ๕๓๑.9661			WICHAN T. ๓๓๑.14151																																																													
STRUCTURAL ENGINEER	YUTTANA C. ๕๓๑.6404		ELECTRICAL ENGINEER	TOSAPHON B. ๕๓๑.2341																																																													
CIVIL ENGINEER	PASIT T. ๕๓๑.2706		SANITARY ENGINEER	PASIT T. ๕๓๑.2706																																																													



PILE NO.	N	E	PILE NO.	N	E	PILE NO.	N	E	PILE NO.	N	E	PILE NO.	N	E	PILE NO.	N	E
1	N. 1436277.3827	E. 731756.4969	26	N. 1436236.3037	E. 731744.1515	51	N. 1436251.0843	E. 731742.7318	76	N. 1436268.6430	E. 731745.9812	101	N. 1436225.9361	E. 731733.1248	126	N. 1436264.4161	E. 731738.8605
2	N. 1436276.5209	E. 731756.2374	27	N. 1436233.8141	E. 731743.3810	52	N. 1436252.4249	E. 731743.1353	77	N. 1436266.1533	E. 731745.2317	102	N. 1436225.0743	E. 731732.8653	127	N. 1436266.9058	E. 731739.6100
3	N. 1436274.0313	E. 731755.4880	28	N. 1436232.9523	E. 731743.1216	53	N. 1436254.6751	E. 731743.8128	78	N. 1436265.2915	E. 731744.9723	103	N. 1436226.6886	E. 731727.5030	128	N. 1436267.7676	E. 731739.8694
4	N. 1436273.1695	E. 731755.2285	29	N. 1436230.4626	E. 731742.3721	54	N. 1436255.5369	E. 731744.0722	79	N. 1436262.8019	E. 731744.2228	104	N. 1436227.5504	E. 731727.7625	129	N. 1436270.2572	E. 731740.6189
5	N. 1436270.6798	E. 731754.4790	30	N. 1436229.6008	E. 731742.1127	55	N. 1436258.0266	E. 731744.8217	80	N. 1436261.9401	E. 731743.9634	105	N. 1436230.0400	E. 731728.5119	130	N. 1436271.1190	E. 731740.8783
6	N. 1436269.8180	E. 731754.2196	31	N. 1436227.1112	E. 731741.3632	56	N. 1436258.8883	E. 731745.0811	81	N. 1436259.4505	E. 731743.2139	106	N. 1436230.9018	E. 731728.7714	131	N. 1436273.6086	E. 731741.6278
7	N. 1436267.3284	E. 731753.4701	32	N. 1436226.2494	E. 731741.1038	57	N. 1436261.3780	E. 731745.8306	82	N. 1436258.5887	E. 731742.9544	107	N. 1436233.3915	E. 731729.5209	132	N. 1436274.4704	E. 731741.8872
8	N. 1436266.4666	E. 731753.2107	33	N. 1436223.7598	E. 731740.3543	58	N. 1436262.2398	E. 731746.0900	83	N. 1436256.0990	E. 731742.2050	108	N. 1436234.2533	E. 731729.7803	133	N. 1436276.9601	E. 731742.6367
9	N. 1436263.9770	E. 731752.4612	34	N. 1436222.8022	E. 731740.0680	59	N. 1436264.7294	E. 731746.8395	84	N. 1436255.2372	E. 731741.9455	109	N. 1436236.7429	E. 731730.5298	134	N. 1436277.8219	E. 731742.8961
10	N. 1436263.1152	E. 731752.2018	35	N. 1436224.5122	E. 731734.7325	60	N. 1436265.5912	E. 731747.0989	85	N. 1436252.7476	E. 731741.1961	110	N. 1436237.6047	E. 731730.7892	135	N. 1436280.3115	E. 731743.6456
11	N. 1436260.6255	E. 731751.4523	36	N. 1436225.3740	E. 731734.9920	61	N. 1436268.0808	E. 731747.8484	86	N. 1436251.8858	E. 731740.9366	111	N. 1436240.0943	E. 731731.5387	136	N. 1436281.1733	E. 731743.9051
12	N. 1436259.7637	E. 731751.1929	37	N. 1436227.8637	E. 731735.7415	62	N. 1436268.9426	E. 731748.1078	87	N. 1436249.3962	E. 731740.1871	112	N. 1436240.9561	E. 731731.7981	137	N. 1436235.8478	E. 731735.0642
13	N. 1436257.2741	E. 731750.4434	38	N. 1436228.7255	E. 731736.0009	63	N. 1436271.1929	E. 731748.7853	88	N. 1436248.5344	E. 731739.9277	113	N. 1436243.4458	E. 731732.5476	138	N. 1436236.8855	E. 731731.6170
14	N. 1436256.4123	E. 731750.1840	39	N. 1436230.9757	E. 731736.6783	64	N. 1436272.5335	E. 731749.1888	89	N. 1436246.0447	E. 731739.1782	114	N. 1436244.3076	E. 731732.8070	139	N. 1436239.1992	E. 731736.0731
15	N. 1436253.9227	E. 731749.4345	40	N. 1436232.3163	E. 731737.0819	65	N. 1436274.7837	E. 731749.8662	90	N. 1436245.1829	E. 731738.9188	115	N. 1436246.7972	E. 731733.5565	140	N. 1436240.2370	E. 731732.6259
16	N. 1436253.0609	E. 731749.1750	41	N. 1436234.5665	E. 731737.7593	66	N. 1436275.6455	E. 731750.1257	91	N. 1436242.6933	E. 731738.1693	116	N. 1436247.6590	E. 731733.8159	141	N. 1436266.0107	E. 731744.1444
17	N. 1436250.5712	E. 731748.4256	42	N. 1436235.4283	E. 731738.0187	67	N. 1436278.1351	E. 731750.8751	92	N. 1436241.8315	E. 731737.9099	117	N. 1436250.1486	E. 731734.5654	142	N. 1436267.0484	E. 731740.6972
18	N. 1436249.7094	E. 731748.1661	43	N. 1436237.9180	E. 731738.7682	68	N. 1436278.9969	E. 731751.1346	93	N. 1436239.3419	E. 731737.1604	118	N. 1436251.0104	E. 731734.8249	143	N. 1436269.3621	E. 731745.1533
19	N. 1436247.2198	E. 731747.4167	44	N. 1436238.7798	E. 731739.0276	69	N. 1436279.5590	E. 731749.2674	94	N. 1436238.4801	E. 731736.9010	119	N. 1436253.5001	E. 731735.5743	144	N. 1436270.3999	E. 731741.7062
20	N. 1436246.3580	E. 731747.1572	45	N. 1436241.2694	E. 731739.7771	70	N. 1436278.6973	E. 731749.0079	95	N. 1436235.9904	E. 731736.1515	120	N. 1436254.3619	E. 731735.8338			
21	N. 1436243.8684	E. 731746.4077	46	N. 1436242.1312	E. 731740.0365	71	N. 1436276.2076	E. 731748.2584	96	N. 1436235.1286	E. 731735.8921	121	N. 1436256.8515	E. 731736.5832			
22	N. 1436243.0066	E. 731746.1483	47	N. 1436244.6208	E. 731740.7860	72	N. 1436275.3458	E. 731747.9990	97	N. 1436232.6390	E. 731735.1426	122	N. 1436257.7133	E. 731736.8427			
23	N. 1436240.5169	E. 731745.3988	48	N. 1436245.4826	E. 731741.0455	73	N. 1436272.8562	E. 731747.2495	98	N. 1436231.7772	E. 731734.8831	123	N. 1436260.2029	E. 731737.5922			
24	N. 1436239.6551	E. 731745.1394	49	N. 1436247.9723	E. 731741.7949	74	N. 1436271.9944	E. 731746.9901	99	N. 1436229.2876	E. 731734.1337	124	N. 1436261.0647	E. 731737.8516			
25	N. 1436237.1655	E. 731744.3899	50	N. 1436248.8341	E. 731742.0544	75	N. 1436269.5048	E. 731746.2406	100	N. 1436228.4258	E. 731733.8742	125	N. 1436263.5544	E. 731738.6011			

 <b>TESCO LTD. CONSULTING ENGINEERS</b> 21/11-14 SOI SUKHUMVIT 18 , BANGKOK 10110 TEL. 259-6573 (10 LINES AUTOMATIC) FAX 258-1313							 บริษัท ทอส์ วิศวกรรม จำกัด (สำนักงานใหญ่) 537/102 ถนนสาธุประดิษฐ์ แขวงคลองนาทวี เขตยานนาวา กรุงเทพมหานคร 10120		REV.	REVISION	DATE	APPR.	APPROVAL		ESB ONE	ESB ONE CO.,LTD		
DESIGN	NAME	SIGNATURE	DESIGN	NAME	SIGNATURE	DATE			ISSUED FOR		75 White Group Tower 2, 11 <sup>th</sup> Fl., Soi Rubia, Sukhumvit 42, Prakanong, Khlongtoey, Bangkok, Thailand							
ARCHITECT	NARAE T. 060.1821		MECHANICAL ENGINEER	POTE L. 061.2055		28/1/2014	CONSTRUCTION		PROJECT	LCH - PROJECT 1								
	PYA S. 061.9661			WICHAN T. 061.14151			APPROVED	—	CUSTOMER ADDRESS	MAPYANGPHON PLUAK-DAENG RAYONG								
STRUCTURAL ENGINEER	YUTTANA C. 061.6404		ELECTRICAL ENGINEER	TOSAPHON B. 061.2341			ORDER NO.	—	DRAWING TITLE	PILING PLAN								
	PASIT T. 061.2706		SANITARY ENGINEER	PASIT T. 061.2706			CONTRACTOR	—	Building G	SCALE 1:100								
CIVIL ENGINEER							CONTRACT DATE	—					DRAWING NO.	LCH1-T1G-ST-101				
								AS-BUILT	18/08/60		REV.	0						



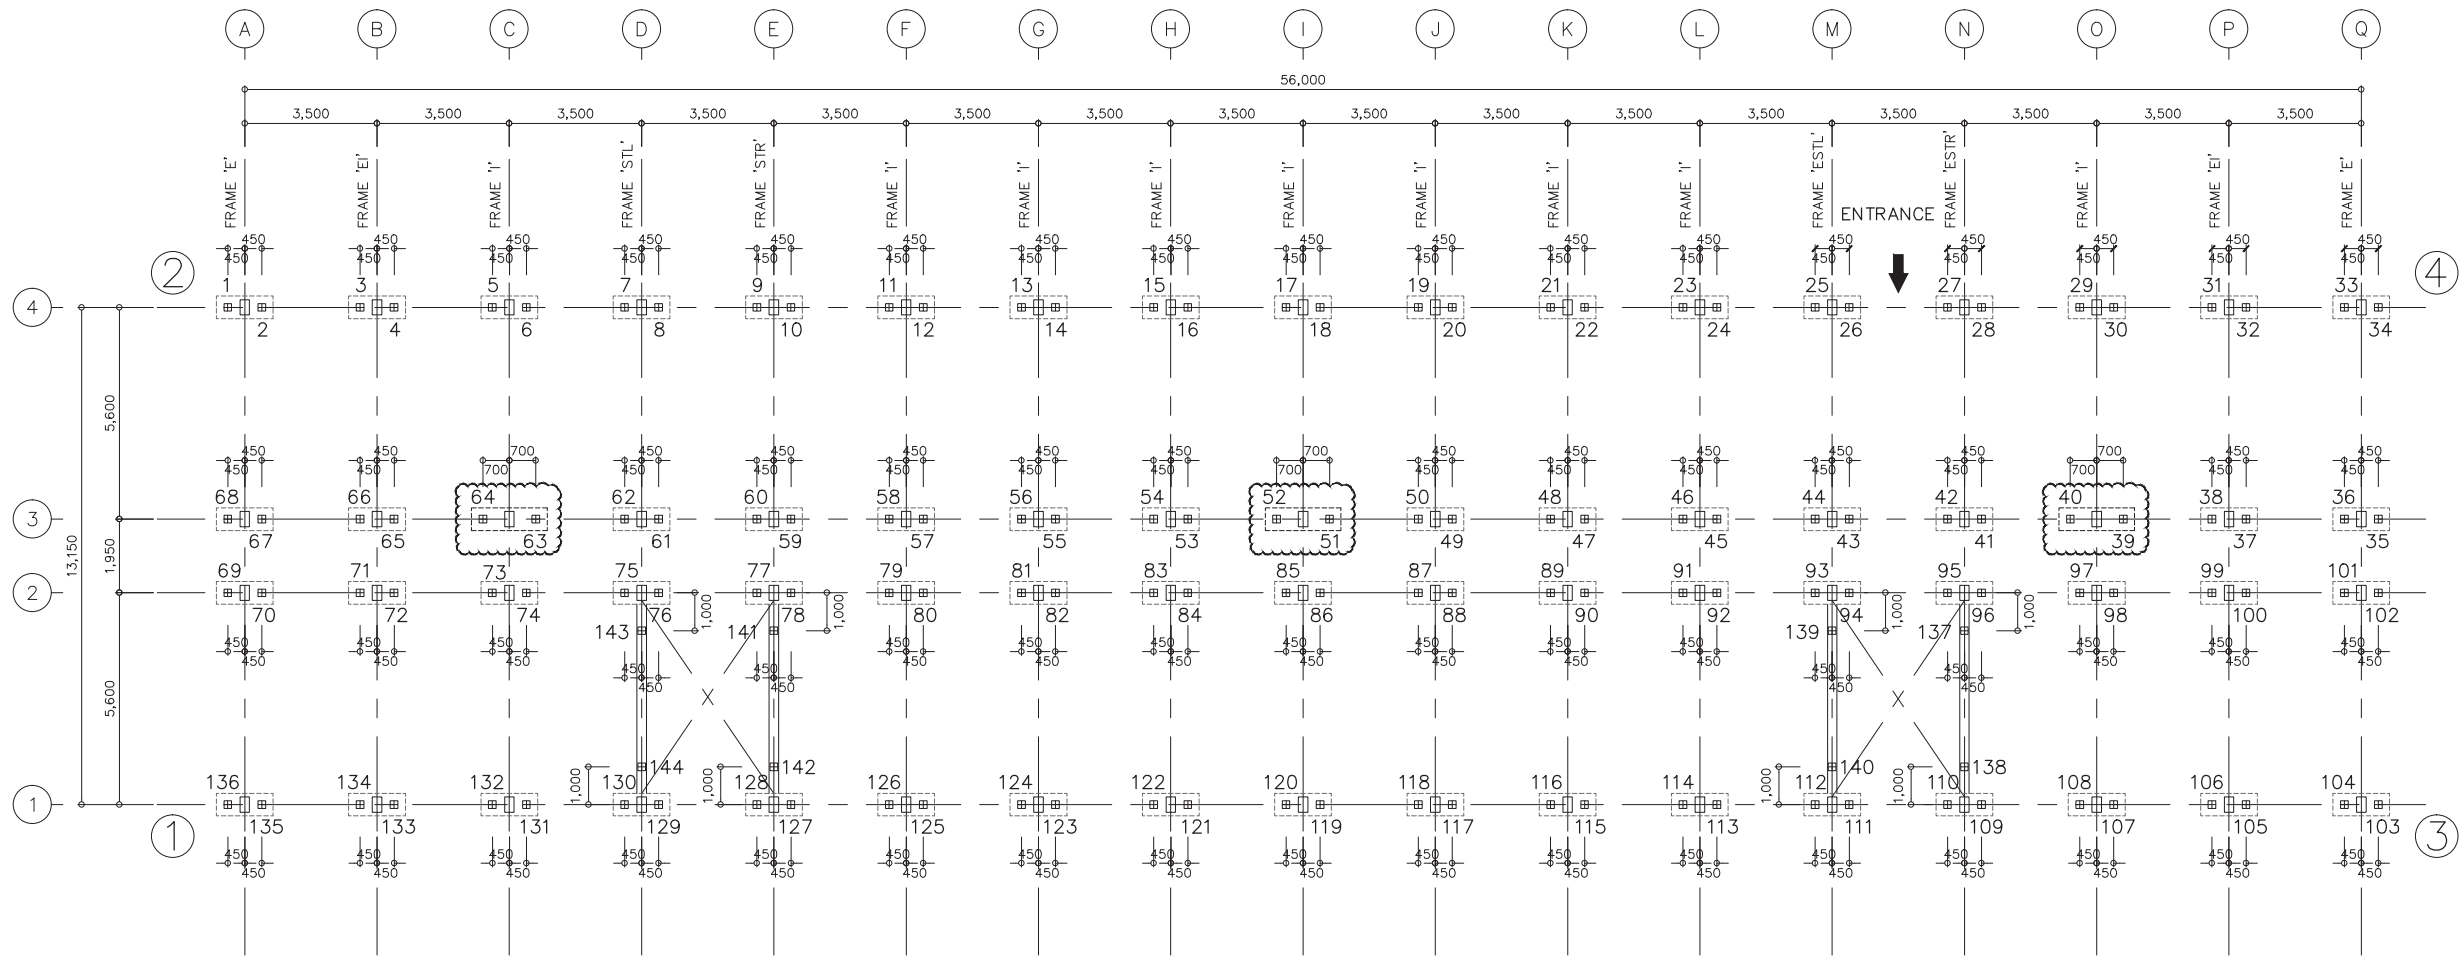

PILING PLAN (TYPE 1)  
SCALE 1:100

BUILDING I


PILE NO.	N	E	PILE NO.	N	E	PILE NO.	N	E	PILE NO.	N	E	PILE NO.	N	E	PILE NO.	N	E
1	N. 1436262.6254	E. 731805.5240	26	N. 1436221.5465	E. 731793.1577	51	N. 1436236.3271	E. 731791.7590	76	N. 1436253.8857	E. 731795.0084	101	N. 1436211.1789	E. 731782.1519	126	N. 1436249.6589	E. 731787.8877
2	N. 1436261.7637	E. 731805.2646	27	N. 1436219.0568	E. 731792.4082	52	N. 1436237.6676	E. 731792.1625	77	N. 1436251.3961	E. 731794.2589	102	N. 1436210.3171	E. 731781.8925	127	N. 1436252.1486	E. 731788.6372
3	N. 1436259.2740	E. 731804.5151	28	N. 1436218.1950	E. 731792.1488	53	N. 1436239.9179	E. 731792.8399	78	N. 1436250.5343	E. 731793.9994	103	N. 1436211.9314	E. 731776.5302	128	N. 1436253.0103	E. 731788.8966
4	N. 1436258.4122	E. 731804.2557	29	N. 1436215.7054	E. 731791.3993	54	N. 1436240.7797	E. 731793.0994	79	N. 1436248.0447	E. 731793.2500	104	N. 1436212.7932	E. 731776.7896	129	N. 1436255.5000	E. 731789.6461
5	N. 1436255.9226	E. 731803.5062	30	N. 1436214.8436	E. 731791.1398	55	N. 1436243.2693	E. 731793.8488	80	N. 1436247.1829	E. 731792.9905	105	N. 1436215.2828	E. 731777.5391	130	N. 1436256.3618	E. 731789.9055
6	N. 1436255.0608	E. 731803.2468	31	N. 1436212.3540	E. 731790.3904	56	N. 1436244.1311	E. 731794.1083	81	N. 1436244.6932	E. 731792.2411	106	N. 1436216.1446	E. 731777.7986	131	N. 1436258.8514	E. 731790.6550
7	N. 1436252.5712	E. 731802.4973	32	N. 1436211.4922	E. 731790.1309	57	N. 1436246.6208	E. 731794.8578	82	N. 1436243.8314	E. 731791.9816	107	N. 1436218.6342	E. 731778.5480	132	N. 1436259.7132	E. 731790.9144
8	N. 1436251.7094	E. 731802.2379	33	N. 1436209.0025	E. 731789.3815	58	N. 1436247.4825	E. 731795.1172	83	N. 1436241.3418	E. 731791.2321	108	N. 1436219.4960	E. 731778.8075	133	N. 1436262.2028	E. 731791.6639
9	N. 1436249.2197	E. 731801.4884	34	N. 1436208.1407	E. 731789.1220	59	N. 1436249.9722	E. 731795.8667	84	N. 1436240.4800	E. 731790.9727	109	N. 1436221.9857	E. 731779.5569	134	N. 1436263.0646	E. 731791.9233
10	N. 1436248.3579	E. 731801.2290	35	N. 1436209.7550	E. 731783.7597	60	N. 1436250.8340	E. 731796.1261	85	N. 1436237.9904	E. 731790.2232	110	N. 1436222.8475	E. 731779.8164	135	N. 1436265.5543	E. 731792.6728
11	N. 1436245.8683	E. 731800.4795	36	N. 1436210.6168	E. 731784.0192	61	N. 1436253.3236	E. 731796.8756	86	N. 1436237.1286	E. 731789.9638	111	N. 1436225.3371	E. 731780.5659	136	N. 1436266.4161	E. 731792.9322
12	N. 1436245.0065	E. 731800.2200	37	N. 1436213.1064	E. 731784.7686	62	N. 1436254.1854	E. 731797.1350	87	N. 1436234.6389	E. 731789.2143	112	N. 1436226.1989	E. 731780.8253	137	N. 1436221.0906	E. 731784.0914
13	N. 1436242.5169	E. 731799.4706	38	N. 1436213.9682	E. 731785.0281	63	N. 1436256.4357	E. 731797.8124	88	N. 1436233.7771	E. 731788.9549	113	N. 1436228.6885	E. 731781.5748	138	N. 1436222.1283	E. 731780.6442
14	N. 1436241.6551	E. 731799.2111	39	N. 1436216.2185	E. 731785.7055	64	N. 1436257.7762	E. 731798.2160	89	N. 1436231.2875	E. 731788.2054	114	N. 1436229.5503	E. 731781.8342	139	N. 1436224.4420	E. 731785.1003
15	N. 1436239.1654	E. 731798.4617	40	N. 1436217.5590	E. 731786.1090	65	N. 1436260.0265	E. 731798.8934	90	N. 1436230.4257	E. 731787.9460	115	N. 1436232.0400	E. 731782.5837	140	N. 1436225.4797	E. 731781.6531
16	N. 1436238.3036	E. 731798.2022	41	N. 1436219.8093	E. 731786.7865	66	N. 1436260.8883	E. 731799.1528	91	N. 1436227.9361	E. 731787.1965	116	N. 1436232.9018	E. 731782.8431	141	N. 1436251.2534	E. 731793.1716
17	N. 1436235.8140	E. 731797.4527	42	N. 1436220.6711	E. 731787.0459	67	N. 1436263.3779	E. 731799.9023	92	N. 1436227.0743	E. 731786.9371	117	N. 1436235.3914	E. 731783.5926	142	N. 1436252.2912	E. 731789.7244
18	N. 1436234.9522	E. 731797.1933	43	N. 1436223.1607	E. 731787.7954	68	N. 1436264.2397	E. 731800.1618	93	N. 1436224.5846	E. 731786.1876	118	N. 1436236.2532	E. 731783.8520	143	N. 1436254.6049	E. 731794.1805
19	N. 1436232.4626	E. 731796.4438	44	N. 1436224.0225	E. 731788.0548	69	N. 1436264.8018	E. 731798.2945	94	N. 1436223.7228	E. 731785.9281	119	N. 1436238.7428	E. 731784.6015	144	N. 1436255.6426	E. 731790.7333
20	N. 1436231.6008	E. 731796.1844	45	N. 1436226.5122	E. 731788.8043	70	N. 1436263.9400	E. 731798.0351	95	N. 1436221.2332	E. 731785.1787	120	N. 1436239.6046	E. 731784.8609			
21	N. 1436229.1111	E. 731795.4349	46	N. 1436227.3740	E. 731789.0637	71	N. 1436261.4504	E. 731797.2856	96	N. 1436220.3714	E. 731784.9192	121	N. 1436242.0943	E. 731785.6104			
22	N. 1436228.2493	E. 731795.1755	47	N. 1436229.8636	E. 731789.8132	72	N. 1436260.5886	E. 731797.0262	97	N. 1436217.8818	E. 731784.1698	122	N. 1436242.9561	E. 731785.8699			
23	N. 1436225.7597	E. 731794.4260	48	N. 1436230.7254	E. 731790.0726	73	N. 1436258.0990	E. 731796.2767	98	N. 1436217.0200	E. 731783.9103	123	N. 1436245.4457	E. 731786.6193			
24	N. 1436224.8979	E. 731794.1666	49	N. 1436233.2150	E. 731790.8221	74	N. 1436257.2372	E. 731796.0173	99	N. 1436214.5303	E. 731783.1608	124	N. 1436246.3075	E. 731786.8788			
25	N. 1436222.4083	E. 731793.4171	50	N. 1436234.0768	E. 731791.0815	75	N. 1436254.7475	E. 731795.2678	100	N. 1436213.6685	E. 731782.9014	125	N. 1436248.7971	E. 731787.6282			

<div><div></div><div><div>TESCO LTD. CONSULTING ENGINEERS</div><div>21/11-14 SOI SUKHUMVIT 18 , BANGKOK 10110</div><div>Tel. 259-8573 (10 LINES AUTOMATIC) FAX 258-1313</div></div></div>						DATE 28/1/2014
DESIGN	NAME	SIGNATURE	DESIGN	NAME	SIGNATURE	
ARCHITECT	NARAE T. ๑๑๑.1821		MECHANICAL ENGINEER	POTE L. ๑๑๑.2055		
	PIYA S. ๑๑๑.9661			WICHAN T. ๑๑๑.14151		
STRUCTURAL ENGINEER	YUTTANA C. ๑๑๑.6404		ELECTRICAL ENGINEER	TOSAPHON B. ๑๑๑.2341		
CIVIL ENGINEER	PASIT T. ๑๑๑.2706		SANITARY ENGINEER	PASIT T. ๑๑๑.2706		




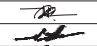




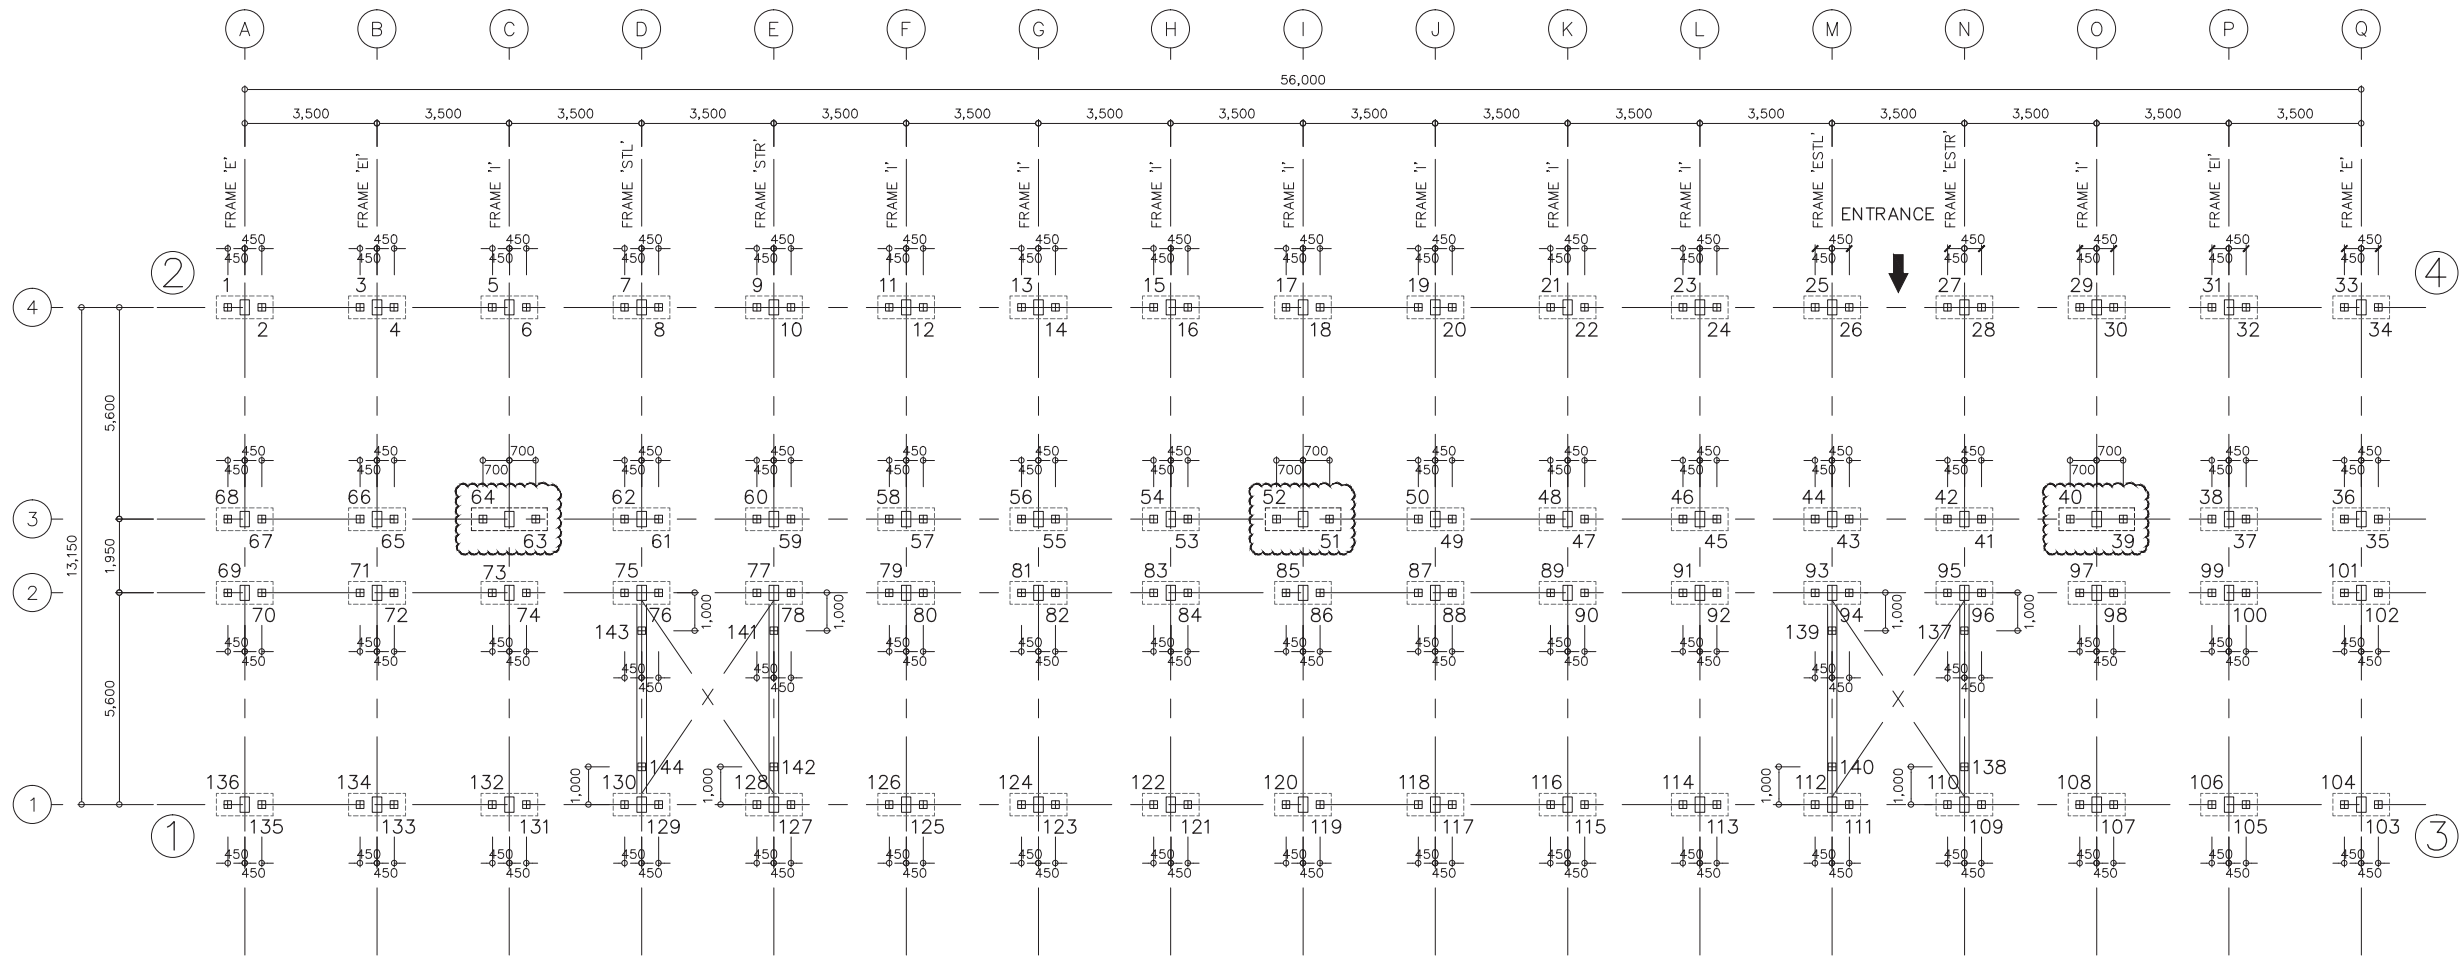


บริษัท ทรอสต์ วิศวกรรม จำกัด  
(สำนักงานใหญ่)  
537/102 ถนนสายประดิษฐ์ แขวงจันทนาภิรมย์  
เขตจันทนาภิรมย์ กรุงเทพมหานคร 10120

REV. MARK	REVISION	DATE	APPR.	APPROVAL		ESB ONE	ESB ONE CO.,LTD		
△	—	—	—	ISSUED FOR			75 White Group Tower 2, 11 <sup>th</sup> Fl., Soi Rubin, Sukhumvit 42, Prakanong, Khlongtoey, Bangkok, Thailand	LCH — PROJECT 1	SCALE 1:100
△	—	—	—	CONSTRUCTION					
△	—	—	—	DATE —					
△	—	—	—	APPROVED	—				
△	—	—	—	ORDER NO.	—	DRAWING TITLE	PILING PLAN Building I	DRAWING NO. LCH1-T11-ST-101	REV. 0
△	—	—	—	CONTRACTOR	—				
△	—	—	—	CONTRACT DATE	—				
	AS-BUILT	18/08/60	—						



BUILDING J  
PILING PLAN (TYPE J)  
SCALE 1:100


PILE NO.	N	E	PILE NO.	N	E	PILE NO.	N	E	PILE NO.	N	E	PILE NO.	N	E	PILE NO.	N	E
1	N. 1436258.8795	E. 731830.6534	26	N. 1436216.0787	E. 731827.7372	51	N. 1436230.1776	E. 731823.0848	76	N. 1436248.0190	E. 731822.3459	101	N. 1436203.5222	E. 731819.3142	126	N. 1436242.3138	E. 731816.3442
2	N. 1436257.9815	E. 731830.5922	27	N. 1436213.4847	E. 731827.5604	52	N. 1436231.5743	E. 731823.1800	77	N. 1436245.4251	E. 731822.1692	102	N. 1436202.6243	E. 731819.2530	127	N. 1436244.9078	E. 731816.5210
3	N. 1436255.3876	E. 731830.4155	28	N. 1436212.5868	E. 731827.4993	53	N. 1436233.9189	E. 731823.3397	78	N. 1436244.5271	E. 731822.1492	103	N. 1436203.0050	E. 731813.6659	128	N. 1436245.8057	E. 731816.5821
4	N. 1436254.4896	E. 731830.3543	29	N. 1436209.9928	E. 731827.3225	54	N. 1436234.8168	E. 731823.4009	79	N. 1436241.9332	E. 731821.9313	104	N. 1436203.9029	E. 731813.7271	129	N. 1436248.3997	E. 731816.7589
5	N. 1436251.8956	E. 731830.1775	30	N. 1436209.0949	E. 731827.2613	55	N. 1436237.4108	E. 731823.5776	80	N. 1436241.0352	E. 731821.8701	105	N. 1436206.4969	E. 731813.9038	130	N. 1436249.2976	E. 731816.8200
6	N. 1436250.9977	E. 731830.1164	31	N. 1436206.5009	E. 731827.0846	56	N. 1436238.3087	E. 731823.6388	81	N. 1436238.4413	E. 731821.6933	106	N. 1436207.3948	E. 731813.9650	131	N. 1436251.8916	E. 731816.9968
7	N. 1436248.4037	E. 731829.9396	32	N. 1436205.6030	E. 731827.0234	57	N. 1436240.9027	E. 731823.8156	82	N. 1436237.5433	E. 731821.6322	107	N. 1436209.9888	E. 731814.1418	132	N. 1436252.7895	E. 731817.0580
8	N. 1436247.5058	E. 731829.8785	33	N. 1436203.0090	E. 731826.8467	58	N. 1436241.8006	E. 731823.8767	83	N. 1436234.9494	E. 731821.4554	108	N. 1436210.8867	E. 731814.2029	133	N. 1436255.3835	E. 731817.2347
9	N. 1436244.9118	E. 731829.7017	34	N. 1436202.1111	E. 731826.7855	59	N. 1436244.3946	E. 731824.0535	84	N. 1436234.0514	E. 731821.3942	109	N. 1436213.4807	E. 731814.3797	134	N. 1436256.2814	E. 731817.2959
10	N. 1436244.0139	E. 731829.6405	35	N. 1436202.4917	E. 731821.1985	60	N. 1436245.2925	E. 731824.1147	85	N. 1436231.4574	E. 731821.2175	110	N. 1436214.3786	E. 731814.4409	135	N. 1436258.8754	E. 731817.4726
11	N. 1436241.4199	E. 731829.4638	36	N. 1436203.3897	E. 731821.2596	61	N. 1436247.8865	E. 731824.2914	86	N. 1436230.5595	E. 731821.1563	111	N. 1436216.9726	E. 731814.6251	136	N. 1436259.7733	E. 731817.5338
12	N. 1436240.5220	E. 731829.4026	37	N. 1436205.9836	E. 731821.4364	62	N. 1436248.7844	E. 731824.3526	87	N. 1436227.9655	E. 731820.9796	112	N. 1436217.8705	E. 731814.6788	137	N. 1436213.6169	E. 731818.9996
13	N. 1436237.9280	E. 731829.2259	38	N. 1436206.8816	E. 731821.4976	63	N. 1436251.1290	E. 731824.5123	88	N. 1436227.0676	E. 731820.9184	113	N. 1436220.4645	E. 731814.8555	138	N. 1436213.8617	E. 731815.4080
14	N. 1436237.0301	E. 731829.1647	39	N. 1436209.2261	E. 731821.6573	64	N. 1436252.5257	E. 731824.6075	89	N. 1436224.4736	E. 731820.7417	114	N. 1436221.3624	E. 731814.9167	139	N. 1436217.1088	E. 731819.2376
15	N. 1436234.4361	E. 731828.9880	40	N. 1436210.6229	E. 731821.7525	65	N. 1436254.8703	E. 731824.7672	90	N. 1436223.5757	E. 731820.6805	115	N. 1436223.9564	E. 731815.0934	140	N. 1436217.3536	E. 731815.6459
16	N. 1436233.5442	E. 731828.9268	41	N. 1436212.9675	E. 731821.9122	66	N. 1436255.7682	E. 731824.8284	91	N. 1436220.9817	E. 731820.5037	116	N. 1436224.8543	E. 731815.1546	141	N. 1436245.0441	E. 731821.1409
17	N. 1436230.9442	E. 731828.7500	42	N. 1436213.8654	E. 731821.9734	67	N. 1436258.3622	E. 731825.0052	92	N. 1436220.0838	E. 731820.4426	117	N. 1436227.4483	E. 731815.3314	142	N. 1436245.2888	E. 731817.5492
18	N. 1436230.0463	E. 731828.6889	43	N. 1436216.4594	E. 731822.1501	68	N. 1436259.2601	E. 731825.0663	93	N. 1436217.4898	E. 731820.2658	118	N. 1436228.3462	E. 731815.3925	143	N. 1436248.5360	E. 731821.3788
19	N. 1436227.4523	E. 731828.5121	44	N. 1436217.3573	E. 731822.2113	69	N. 1436259.3927	E. 731823.1209	94	N. 1436216.5919	E. 731820.2046	119	N. 1436230.9402	E. 731815.5693	144	N. 1436248.7807	E. 731817.7871
20	N. 1436226.5544	E. 731828.4509	45	N. 1436219.9513	E. 731822.3881	70	N. 1436258.4948	E. 731823.0597	95	N. 1436213.9979	E. 731820.0279	120	N. 1436231.8381	E. 731815.6305			
21	N. 1436223.9604	E. 731828.2742	46	N. 1436220.8492	E. 731822.4492	71	N. 1436255.9008	E. 731822.8829	96	N. 1436213.1000	E. 731819.9667	121	N. 1436234.4321	E. 731815.8072			
22	N. 1436223.0625	E. 731828.2130	47	N. 1436223.4432	E. 731822.6260	72	N. 1436255.0029	E. 731822.8218	97	N. 1436210.5060	E. 731819.7900	122	N. 1436235.3300	E. 731815.8684			
23	N. 1436220.4685	E. 731828.0363	48	N. 1436224.3411	E. 731822.6872	73	N. 1436252.4089	E. 731822.8450	98	N. 1436209.6081	E. 731819.7288	123	N. 1436237.9240	E. 731816.0451			
24	N. 1436219.5706	E. 731827.9751	49	N. 1436226.9351	E. 731822.8639	74	N. 1436251.5110	E. 731822.5838	99	N. 1436207.0141	E. 731819.5521	124	N. 1436238.8219	E. 731816.1063			
25	N. 1436216.9766	E. 731827.7984	50	N. 1436227.8330	E. 731822.9074	75	N. 1436248.9170	E. 731822.4071	100	N. 1436206.1162	E. 731819.4909	125	N. 1436241.4159	E. 731816.2830			

 <b>TESCO LTD. CONSULTING ENGINEERS</b> 21/11-14 SOI SUKHUMVIT 18 , BANGKOK 10110 TEL. 259-8573 (10 LINES AUTOMATIC) FAX 258-1313					
DESIGN	NAME	SIGNATURE	DESIGN	NAME	SIGNATURE
ARCHITECT	NARAE T. ๕๓๑.1821		MECHANICAL ENGINEER	POTE L. ๕๓๑.2055	
	PIYA S. ๖๓๑.9661			WICHAN T. ๓๓๑.14151	
STRUCTURAL ENGINEER	YUTTANA C. ๕๓๑.6404		ELECTRICAL ENGINEER	TOSAPHON B. ๕๓๑.2341	
CIVIL ENGINEER	PASIT T. ๕๓๑.2706		SANITARY ENGINEER	PASIT T. ๕๓๑.2706	
					DATE 28/1/2014








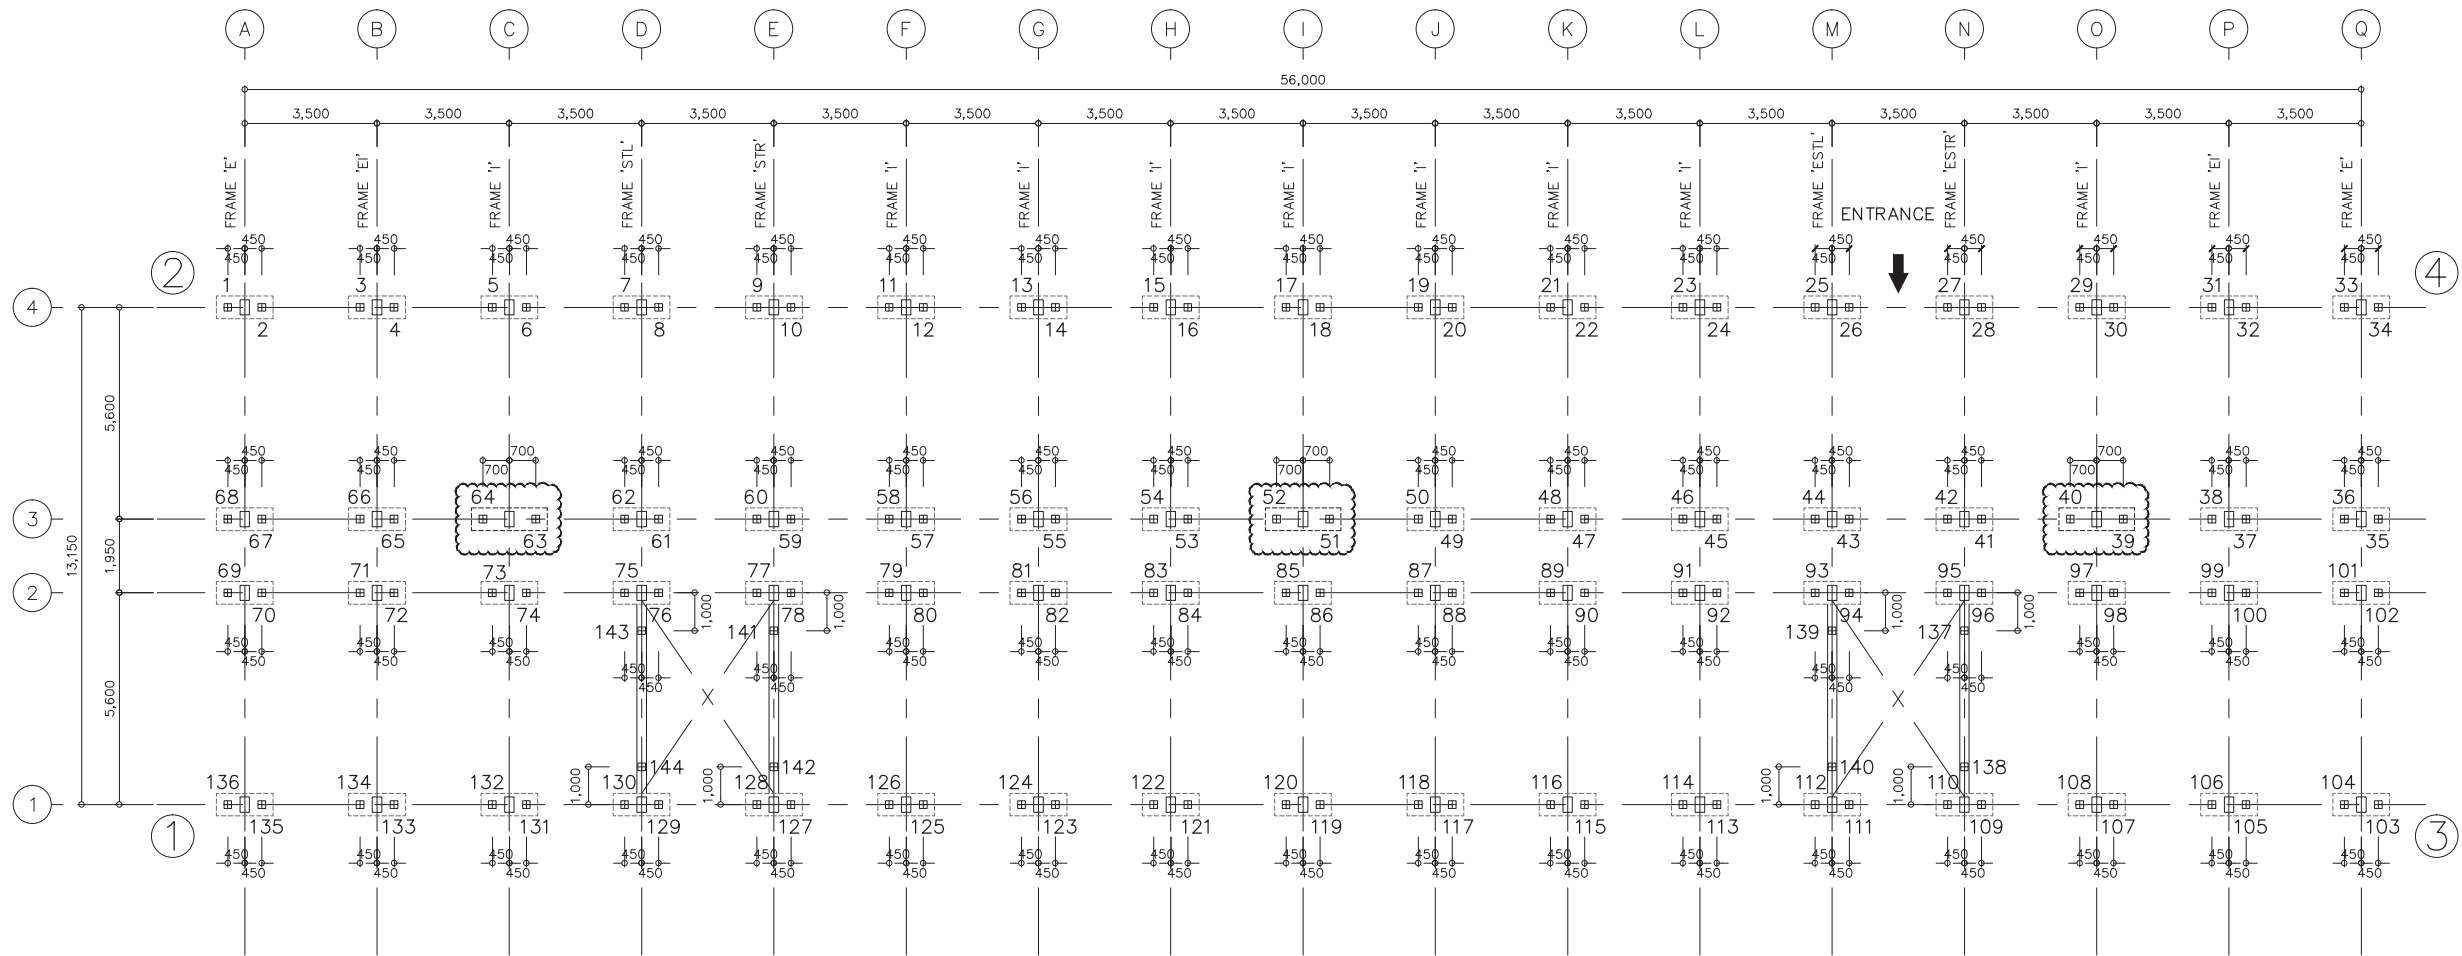




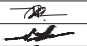




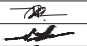


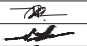







บริษัท เอสบีวัน จำกัด  
(สำนักงานใหญ่)  
537/102 ถนนสายประดิษฐ์ แขวงจันทนาภิรมย์  
เขตจันทนาภิรมย์ กรุงเทพมหานคร 10120

REV. MARK	REVISION	DATE	APPR.	APPROVAL		ESB ONE	ESB ONE CO.,LTD		
				ISSUED FOR			PROJECT CLIENTS ADDRESS DRAWING TITLE	75 White Group Tower 2, 11 <sup>th</sup> Fl., Soi Rubin, Sukhumvit 42, Prakanong, Khlongtoey, Bangkok, Thailand	
				CONSTRUCTION					
				DATE	-				
				APPROVED	-				
				ORDER NO.	-	PILING PLAN Building J	1:100		
				CONTRACTOR	-				
				CONTRACT DATE	-				
	AS-BUILT	18/08/60	-						
							DRAWING NO. LCH1-T1J-ST-101	REV. 0	




BUILDING L  
PILING PLAN (TYPE 1)  
SCALE 1:100

PILE NO.	N	E	PILE NO.	N	E	PILE NO.	N	E	PILE NO.	N	E	PILE NO.	N	E	PILE NO.	N	E
1	N. 1436255.3990	E. 731881.7350	26	N. 1436212.5983	E. 731878.8188	51	N. 1436226.6971	E. 731874.1664	76	N. 1436244.5386	E. 731873.4275	101	N. 1436200.0418	E. 731870.3957	126	N. 1436238.8334	E. 731867.4258
2	N. 1436254.5011	E. 731881.6738	27	N. 1436210.0043	E. 731878.6420	52	N. 1436228.0939	E. 731874.2616	77	N. 1436241.9447	E. 731873.2507	102	N. 1436199.1439	E. 731870.3345	127	N. 1436241.4274	E. 731867.6025
3	N. 1436251.9071	E. 731881.4970	28	N. 1436230.1064	E. 731878.5808	53	N. 1436230.4385	E. 731874.4213	78	N. 1436241.0467	E. 731873.1896	103	N. 1436199.5246	E. 731864.7475	128	N. 1436242.3253	E. 731867.6637
4	N. 1436251.0092	E. 731881.4359	29	N. 1436206.5124	E. 731878.4041	54	N. 1436231.3364	E. 731874.4825	79	N. 1436238.4528	E. 731873.0128	104	N. 1436200.4225	E. 731864.8087	129	N. 1436244.9193	E. 731867.8404
5	N. 1436248.4152	E. 731881.2591	30	N. 1436205.6145	E. 731878.3429	55	N. 1436233.9304	E. 731874.6592	80	N. 1436237.5548	E. 731872.9516	105	N. 1436203.0165	E. 731864.9854	130	N. 1436245.8172	E. 731867.9016
6	N. 1436247.5173	E. 731881.1979	31	N. 1436203.0205	E. 731878.1662	56	N. 1436234.8283	E. 731874.7204	81	N. 1436234.9608	E. 731872.7749	106	N. 1436203.9144	E. 731865.0466	131	N. 1436248.4112	E. 731868.0784
7	N. 1436244.9233	E. 731881.0212	32	N. 1436202.1226	E. 731878.1050	57	N. 1436237.4223	E. 731874.8971	82	N. 1436234.0629	E. 731872.7137	107	N. 1436206.5084	E. 731865.2233	132	N. 1436249.3091	E. 731868.1395
8	N. 1436244.0254	E. 731880.9600	33	N. 1436199.5286	E. 731877.9283	58	N. 1436238.3202	E. 731874.9583	83	N. 1436231.4689	E. 731872.5370	108	N. 1436207.4063	E. 731865.2845	133	N. 1436251.9031	E. 731868.3163
9	N. 1436241.4314	E. 731880.7833	34	N. 1436198.6307	E. 731877.8671	59	N. 1436240.9142	E. 731875.1351	84	N. 1436230.5710	E. 731872.4758	109	N. 1436210.0003	E. 731865.4613	134	N. 1436252.8010	E. 731868.3775
10	N. 1436240.5335	E. 731880.7221	35	N. 1436199.0113	E. 731872.2800	60	N. 1436241.8121	E. 731875.1962	85	N. 1436227.9770	E. 731872.2991	110	N. 1436210.8982	E. 731865.5224	135	N. 1436255.3950	E. 731868.5542
11	N. 1436237.9395	E. 731880.5454	36	N. 1436199.9093	E. 731872.3412	61	N. 1436244.4061	E. 731875.3730	86	N. 1436227.0791	E. 731872.2379	111	N. 1436213.4922	E. 731865.6992	136	N. 1436256.2929	E. 731868.6154
12	N. 1436237.0416	E. 731880.4842	37	N. 1436202.5032	E. 731872.5180	62	N. 1436245.3040	E. 731875.4342	87	N. 1436224.4851	E. 731872.0612	112	N. 1436214.3901	E. 731865.7604	137	N. 1436210.1365	E. 731870.0812
13	N. 1436234.4476	E. 731880.3074	38	N. 1436203.4012	E. 731872.5791	63	N. 1436247.6486	E. 731875.5939	88	N. 1436233.5872	E. 731872.0000	113	N. 1436216.9841	E. 731865.9371	138	N. 1436210.3813	E. 731866.4895
14	N. 1436233.5497	E. 731880.2463	39	N. 1436205.7457	E. 731872.7389	64	N. 1436249.0453	E. 731875.6891	89	N. 1436220.9932	E. 731871.8232	114	N. 1436217.8820	E. 731865.9983	139	N. 1436213.6284	E. 731870.3191
15	N. 1436230.9557	E. 731880.0695	40	N. 1436207.1425	E. 731872.8340	65	N. 1436251.3899	E. 731875.8488	90	N. 1436220.0953	E. 731871.7621	115	N. 1436220.4760	E. 731866.1750	140	N. 1436213.8732	E. 731866.7274
16	N. 1436230.0578	E. 731880.0083	41	N. 1436209.4870	E. 731872.9938	66	N. 1436252.2878	E. 731875.9100	91	N. 1436217.5013	E. 731871.5853	116	N. 1436221.3739	E. 731866.2362	141	N. 1436241.5637	E. 731872.2225
17	N. 1436227.4638	E. 731879.8316	42	N. 1436210.3850	E. 731873.0674	67	N. 1436254.8818	E. 731876.0867	92	N. 1436216.6034	E. 731871.5241	117	N. 1436223.9679	E. 731866.4129	142	N. 1436241.8084	E. 731868.6308
18	N. 1436228.5659	E. 731879.7704	43	N. 1436212.9789	E. 731873.2317	68	N. 1436255.7797	E. 731876.1479	93	N. 1436214.0094	E. 731871.3474	118	N. 1436224.8658	E. 731866.4741	143	N. 1436245.0556	E. 731872.4604
19	N. 1436223.9719	E. 731879.5937	44	N. 1436213.8769	E. 731873.2929	69	N. 1436255.9123	E. 731874.2024	94	N. 1436213.1115	E. 731871.2862	119	N. 1436227.4598	E. 731866.6508	144	N. 1436245.3003	E. 731868.8687
20	N. 1436223.0740	E. 731879.5325	45	N. 1436216.4709	E. 731873.4696	70	N. 1436255.0144	E. 731874.1412	95	N. 1436210.5175	E. 731871.1095	120	N. 1436228.3577	E. 731866.7120			
21	N. 1436220.4800	E. 731879.3558	46	N. 1436217.3688	E. 731873.5308	71	N. 1436252.4204	E. 731873.9645	96	N. 1436209.6196	E. 731871.0483	121	N. 1436230.9517	E. 731866.8888			
22	N. 1436219.5821	E. 731879.2946	47	N. 1436219.9628	E. 731873.7075	72	N. 1436251.5225	E. 731873.9033	97	N. 1436207.0256	E. 731870.8716	122	N. 1436231.8496	E. 731866.9499			
23	N. 1436216.9881	E. 731879.1179	48	N. 1436220.8607	E. 731873.7687	73	N. 1436248.9285	E. 731873.7266	98	N. 1436206.1277	E. 731870.8104	123	N. 1436234.4436	E. 731867.1267			
24	N. 1436216.0902	E. 731879.0567	49	N. 1436223.4547	E. 731873.9455	74	N. 1436248.0305	E. 731873.6654	99	N. 1436203.5337	E. 731870.6336	124	N. 1436235.3415	E. 731867.1879			
25	N. 1436213.4962	E. 731878.8799	50	N. 1436224.3526	E. 731874.0066	75	N. 1436245.4366	E. 731873.4887	100	N. 1436202.6358	E. 731870.5725	125	N. 1436237.9355	E. 731867.3646			

 <b>TESCO LTD. CONSULTING ENGINEERS</b> 21/11-14 SOI SUKHUMVIT 18 , BANGKOK 10110 TEL. 259-8573 (10 LINES AUTOMATIC) FAX 258-1313						 <b>บริษัท เอสบีวัน จำกัด</b> (สำนักงานใหญ่) 537/102 ถนนสายประดิษฐ์ แขวงจันทนาภิรมย์ เขตจันทนาภิรมย์ กรุงเทพมหานคร 10120						<table><tr><td>REV.</td><td>MARK</td><td>REVISION</td><td>DATE</td><td>APPR.</td></tr><tr><td>△</td><td>1</td><td>AS-BUILT</td><td>18/08/60</td><td>-</td></tr></table>		REV.	MARK	REVISION	DATE	APPR.	△	1	AS-BUILT	18/08/60	-	<table><tr><td colspan="2">APPROVAL</td></tr><tr><td>ISSUED FOR</td><td>CONSTRUCTION</td></tr><tr><td>DATE</td><td>-</td></tr><tr><td>APPROVED</td><td>-</td></tr><tr><td>ORDER NO.</td><td>-</td></tr><tr><td>CONTRACTOR</td><td>-</td></tr><tr><td>CONTRACT DATE</td><td>-</td></tr></table>		APPROVAL		ISSUED FOR	CONSTRUCTION	DATE	-	APPROVED	-	ORDER NO.	-	CONTRACTOR	-	CONTRACT DATE	-	<b>ESB ONE</b>		<b>ESB ONE CO.,LTD</b> 75 White Group Tower 2, 11 <sup>th</sup> Fl., Soi Rubin, Sukhumvit 42, Prakanong, Khlongtoey, Bangkok, Thailand						
REV.	MARK	REVISION	DATE	APPR.																																												
△	1	AS-BUILT	18/08/60	-																																												
APPROVAL																																																
ISSUED FOR	CONSTRUCTION																																															
DATE	-																																															
APPROVED	-																																															
ORDER NO.	-																																															
CONTRACTOR	-																																															
CONTRACT DATE	-																																															
<table><tr><td>DESIGN</td><td>NAME</td><td>SIGNATURE</td><td>DESIGN</td><td>NAME</td><td>SIGNATURE</td><td>DATE</td></tr><tr><td>ARCHITECT</td><td>NARAE T. ๕๓๑.1821</td><td></td><td>MECHANICAL ENGINEER</td><td>POTE L. ๕๓๑.2055</td><td></td><td rowspan="3">28/1/2014</td></tr><tr><td></td><td>PIYA S. ๖๓๑.9661</td><td></td><td></td><td>WICHAN T. ๓๓๑.14151</td><td></td></tr><tr><td>STRUCTURAL ENGINEER</td><td>YUTTANA C. ๕๓๑.6404</td><td></td><td>ELECTRICAL ENGINEER</td><td>TOSAPHON B. ๕๓๑.2341</td><td></td></tr><tr><td>CIVIL ENGINEER</td><td>PASIT T. ๕๓๑.2706</td><td></td><td>SANITARY ENGINEER</td><td>PASIT T. ๕๓๑.2706</td><td></td><td></td></tr></table>		DESIGN	NAME	SIGNATURE	DESIGN	NAME	SIGNATURE	DATE	ARCHITECT	NARAE T. ๕๓๑.1821		MECHANICAL ENGINEER	POTE L. ๕๓๑.2055		28/1/2014		PIYA S. ๖๓๑.9661			WICHAN T. ๓๓๑.14151		STRUCTURAL ENGINEER	YUTTANA C. ๕๓๑.6404		ELECTRICAL ENGINEER	TOSAPHON B. ๕๓๑.2341		CIVIL ENGINEER	PASIT T. ๕๓๑.2706		SANITARY ENGINEER	PASIT T. ๕๓๑.2706			<table><tr><td>PROJECT</td><td>LCH - PROJECT 1</td></tr><tr><td>CLIENTS ADDRESS</td><td>MAPYANGPHON PLUAK-DAENG RAYONG</td></tr><tr><td>DRAWING TITLE</td><td>PILING PLAN Building L</td></tr><tr><td>SCALE</td><td>1:100</td></tr><tr><td>DRAWING NO.</td><td>LCH1-T1L-ST-101</td></tr><tr><td>REV.</td><td>0</td></tr></table>		PROJECT	LCH - PROJECT 1	CLIENTS ADDRESS	MAPYANGPHON PLUAK-DAENG RAYONG	DRAWING TITLE	PILING PLAN Building L	SCALE	1:100	DRAWING NO.	LCH1-T1L-ST-101	REV.	0
DESIGN	NAME	SIGNATURE	DESIGN	NAME	SIGNATURE	DATE																																										
ARCHITECT	NARAE T. ๕๓๑.1821		MECHANICAL ENGINEER	POTE L. ๕๓๑.2055		28/1/2014																																										
	PIYA S. ๖๓๑.9661			WICHAN T. ๓๓๑.14151																																												
STRUCTURAL ENGINEER	YUTTANA C. ๕๓๑.6404		ELECTRICAL ENGINEER	TOSAPHON B. ๕๓๑.2341																																												
CIVIL ENGINEER	PASIT T. ๕๓๑.2706		SANITARY ENGINEER	PASIT T. ๕๓๑.2706																																												
PROJECT	LCH - PROJECT 1																																															
CLIENTS ADDRESS	MAPYANGPHON PLUAK-DAENG RAYONG																																															
DRAWING TITLE	PILING PLAN Building L																																															
SCALE	1:100																																															
DRAWING NO.	LCH1-T1L-ST-101																																															
REV.	0																																															



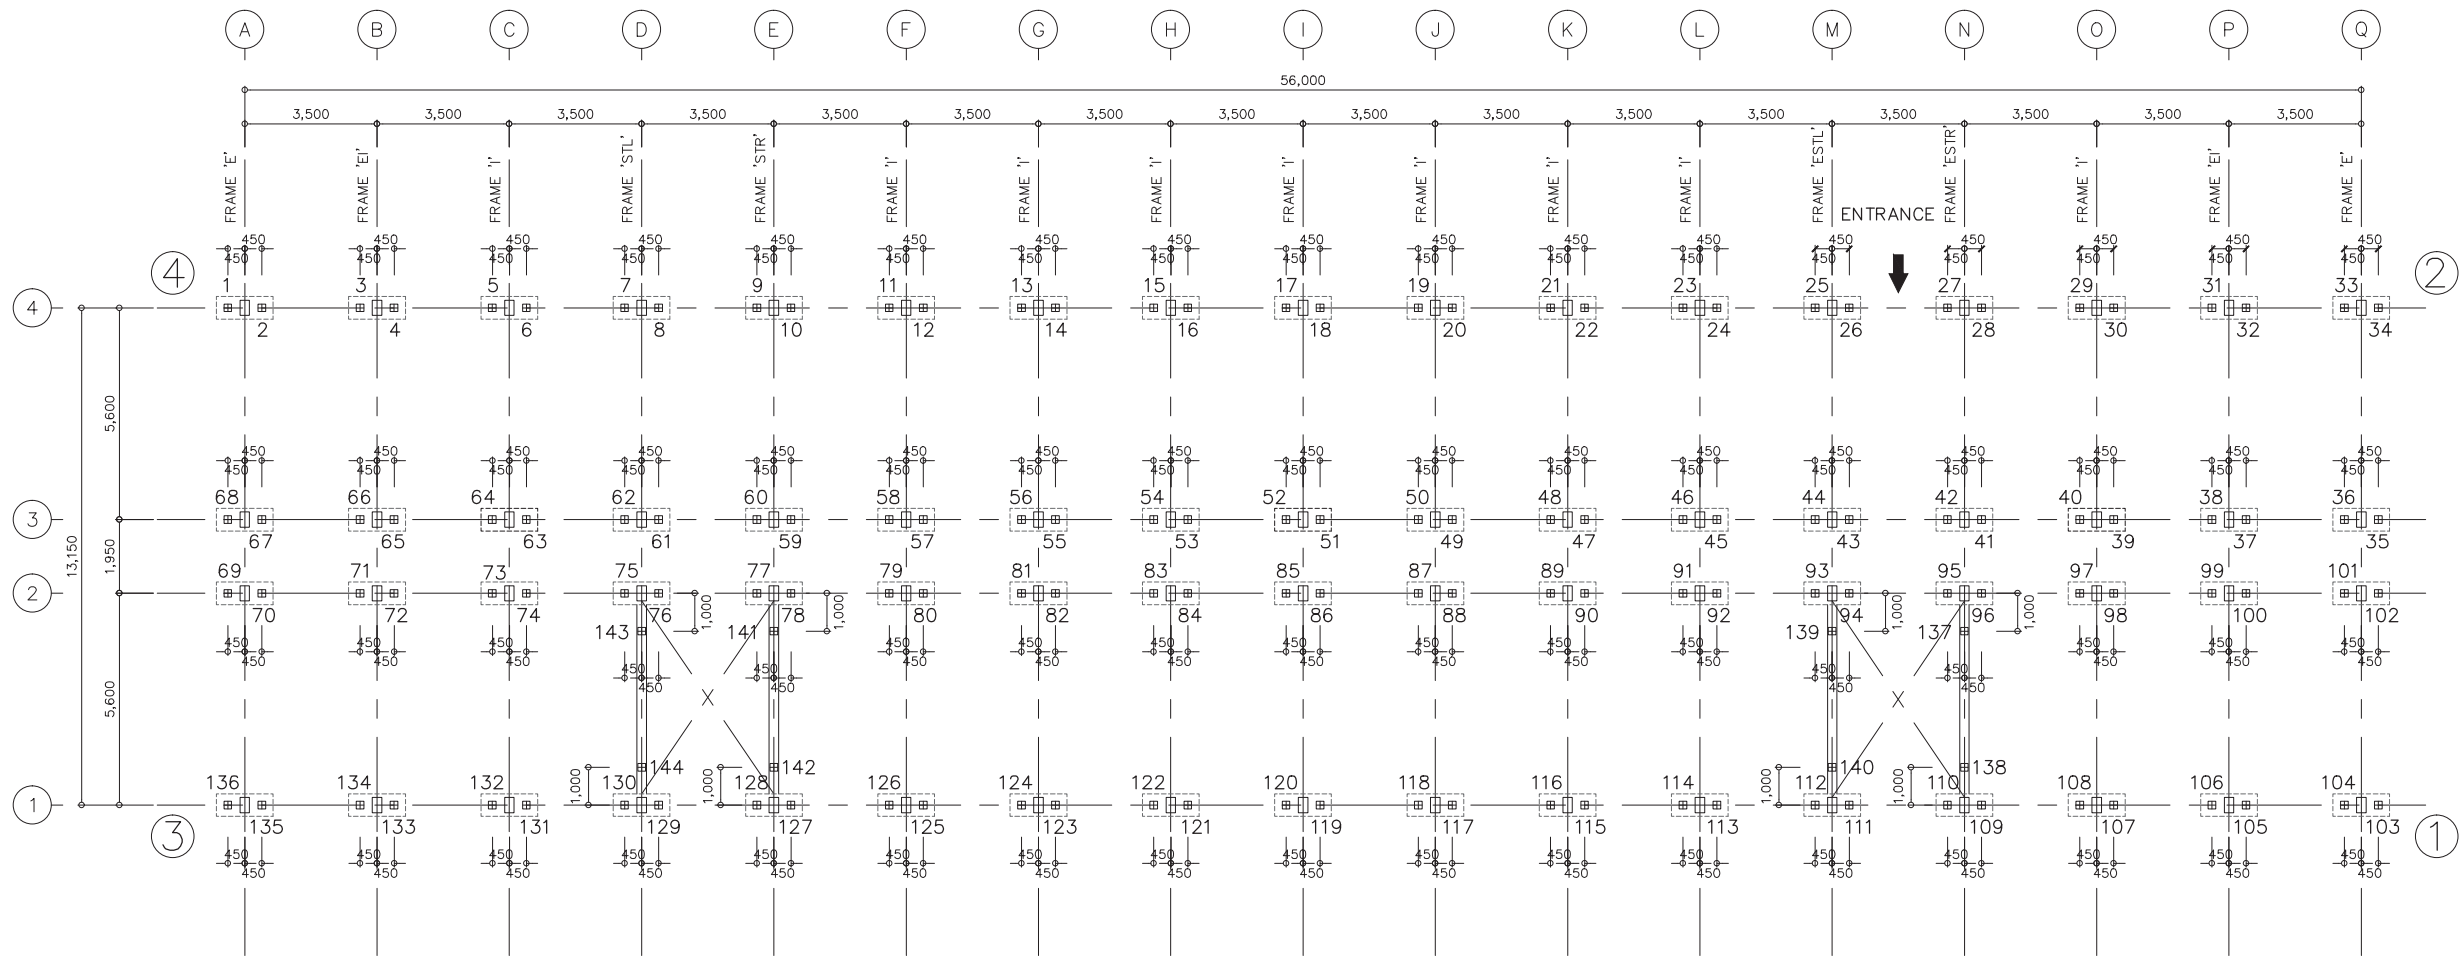










PILING PLAN (TYPE 1)  
SCALE 1:100

BUILDING N


PILE NO.	N	E	PILE NO.	N	E	PILE NO.	N	E	PILE NO.	N	E	PILE NO.	N	E	PILE NO.	N	E
1	N. 1436167.5889	E. 731917.5126	26	N. 1436170.5051	E. 731874.7118	51	N. 1436175.1405	E. 731889.0601	76	N. 1436175.8964	E. 731906.6522	101	N. 1436178.9281	E. 731862.1553	126	N. 1436181.8981	E. 731900.9469
2	N. 1436167.6501	E. 731916.6146	27	N. 1436170.6818	E. 731872.1178	52	N. 1436175.0793	E. 731889.9580	77	N. 1436176.0731	E. 731904.0582	102	N. 1436178.9893	E. 731861.2574	127	N. 1436181.7213	E. 731903.5409
3	N. 1436167.8268	E. 731914.0207	28	N. 1436170.7430	E. 731871.2199	53	N. 1436174.9025	E. 731892.5520	78	N. 1436176.1343	E. 731903.1602	103	N. 1436184.5763	E. 731861.6381	128	N. 1436181.6601	E. 731904.4388
4	N. 1436167.8880	E. 731913.1227	29	N. 1436170.9198	E. 731868.6259	54	N. 1436174.8414	E. 731893.4499	79	N. 1436176.3110	E. 731900.5663	104	N. 1436184.5152	E. 731862.5360	129	N. 1436181.4834	E. 731907.0328
5	N. 1436168.0647	E. 731910.5287	30	N. 1436170.9809	E. 731867.7280	55	N. 1436174.6646	E. 731896.0439	80	N. 1436176.3722	E. 731899.6683	105	N. 1436184.3384	E. 731865.1300	130	N. 1436181.4222	E. 731907.9307
6	N. 1436168.1259	E. 731909.6308	31	N. 1436171.1577	E. 731865.1340	56	N. 1436174.6034	E. 731896.9418	81	N. 1436176.5489	E. 731897.0744	106	N. 1436184.2773	E. 731866.0279	131	N. 1436181.2455	E. 731910.5247
7	N. 1436168.3026	E. 731907.0368	32	N. 1436171.2188	E. 731864.2361	57	N. 1436174.4267	E. 731899.5358	82	N. 1436176.6101	E. 731896.1764	107	N. 1436184.1005	E. 731868.6219	132	N. 1436181.1843	E. 731911.4226
8	N. 1436168.3638	E. 731906.1389	33	N. 1436171.3956	E. 731861.6421	58	N. 1436174.3655	E. 731900.4337	83	N. 1436176.7869	E. 731893.5825	108	N. 1436184.0393	E. 731869.5198	133	N. 1436181.0076	E. 731914.0166
9	N. 1436168.5406	E. 731903.5449	34	N. 1436171.4568	E. 731860.7442	59	N. 1436174.1888	E. 731903.0094	84	N. 1436176.8480	E. 731892.6845	109	N. 1436183.8626	E. 731872.1138	134	N. 1436180.9464	E. 731914.9145
10	N. 1436168.6017	E. 731902.6470	35	N. 1436177.0438	E. 731861.1248	60	N. 1436174.1276	E. 731903.9393	85	N. 1436177.0248	E. 731890.0905	110	N. 1436183.8014	E. 731873.0117	135	N. 1436180.7697	E. 731917.5085
11	N. 1436168.7785	E. 731900.0530	36	N. 1436176.9826	E. 731862.0228	61	N. 1436173.9509	E. 731906.5196	86	N. 1436177.0860	E. 731889.1926	111	N. 1436183.6247	E. 731875.6057	136	N. 1436180.7085	E. 731918.4065
12	N. 1436168.8397	E. 731899.1551	37	N. 1436176.8059	E. 731864.6167	62	N. 1436173.8897	E. 731907.4175	87	N. 1436177.2627	E. 731886.5986	112	N. 1436183.5635	E. 731876.5036	137	N. 1436179.2426	E. 731872.2500
13	N. 1436169.0164	E. 731896.5611	38	N. 1436176.7447	E. 731865.5147	63	N. 1436173.7130	E. 731910.0115	88	N. 1436177.3239	E. 731885.7007	113	N. 1436183.3868	E. 731879.0976	138	N. 1436182.8343	E. 731872.4948
14	N. 1436169.0776	E. 731895.6632	39	N. 1436176.5680	E. 731868.1086	64	N. 1436173.6518	E. 731910.9094	89	N. 1436177.5006	E. 731883.1067	114	N. 1436183.3256	E. 731879.9955	139	N. 1436179.0047	E. 731875.7419
15	N. 1436169.2543	E. 731893.0692	40	N. 1436176.5068	E. 731869.0066	65	N. 1436173.4750	E. 731913.5034	90	N. 1436177.5618	E. 731882.2088	115	N. 1436183.1488	E. 731882.5895	140	N. 1436182.5964	E. 731875.9867
16	N. 1436169.3155	E. 731892.1713	41	N. 1436176.3301	E. 731871.6006	66	N. 1436173.4139	E. 731914.4013	91	N. 1436177.7385	E. 731879.6148	116	N. 1436183.1104	E. 731883.4874	141	N. 1436177.1014	E. 731903.6772
17	N. 1436169.4922	E. 731889.5773	42	N. 1436176.2689	E. 731872.4985	67	N. 1436173.2371	E. 731916.9953	92	N. 1436177.7997	E. 731878.7169	117	N. 1436182.9109	E. 731886.0814	142	N. 1436180.6931	E. 731903.9219
18	N. 1436169.5534	E. 731888.6794	43	N. 1436173.1759	E. 731875.0925	68	N. 1436173.1759	E. 731917.8932	93	N. 1436177.9765	E. 731876.1229	118	N. 1436182.8497	E. 731886.9793	143	N. 1436176.8635	E. 731907.1691
19	N. 1436169.7302	E. 731886.0854	44	N. 1436176.0310	E. 731875.9904	69	N. 1436175.1214	E. 731918.0258	94	N. 1436178.0376	E. 731875.2250	119	N. 1436182.6730	E. 731889.5733	144	N. 1436180.4551	E. 731907.4138
20	N. 1436169.7913	E. 731885.1875	45	N. 1436175.8542	E. 731878.5844	70	N. 1436175.1826	E. 731917.1279	95	N. 1436178.2144	E. 731872.6310	120	N. 1436182.6118	E. 731890.4712			
21	N. 1436169.9681	E. 731882.5935	46	N. 1436175.7930	E. 731879.4823	71	N. 1436175.3593	E. 731914.5339	96	N. 1436178.2755	E. 731871.7331	121	N. 1436182.4351	E. 731893.0652			
22	N. 1436170.0293	E. 731881.6956	47	N. 1436175.6163	E. 731882.0763	72	N. 1436175.4205	E. 731913.6360	97	N. 1436178.4523	E. 731869.1391	122	N. 1436182.3739	E. 731893.9631			
23	N. 1436170.2060	E. 731879.1016	48	N. 1436175.5551	E. 731882.9742	73	N. 1436175.5973	E. 731911.0420	98	N. 1436178.5135	E. 731868.2412	123	N. 1436182.1972	E. 731896.5571			
24	N. 1436170.2672	E. 731878.2037	49	N. 1436175.3784	E. 731885.5682	74	N. 1436175.6584	E. 731910.1441	99	N. 1436178.6902	E. 731865.6472	124	N. 1436182.1360	E. 731897.4550			
25	N. 1436170.4439	E. 731875.6097	50	N. 1436175.3172	E. 731886.4661	75	N. 1436175.8352	E. 731907.5501	100	N. 1436178.7514	E. 731864.7493	125	N. 1436181.9592	E. 731900.0490			

 <b>TESCO LTD. CONSULTING ENGINEERS</b> 21/11-14 SOI SUKHUMVIT 18 , BANGKOK 10110 TEL. 259-8573 (10 LINES AUTOMATIC) FAX 258-1313					
DESIGN	NAME	SIGNATURE	DESIGN	NAME	SIGNATURE
ARCHITECT	NARAE T. สกต.1821		MECHANICAL ENGINEER	POTE L. สกต.2055	
	PIYA S. สกต.9661			WICHAN T. สกต.14151	
STRUCTURAL ENGINEER	YUTTANA C. สกต.6404		ELECTRICAL ENGINEER	TOSAPHON B. สกต.2341	
CIVIL ENGINEER	PASIT T. สกต.2706		SANITARY ENGINEER	PASIT T. สกต.2706	
					DATE 28/1/2014




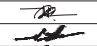




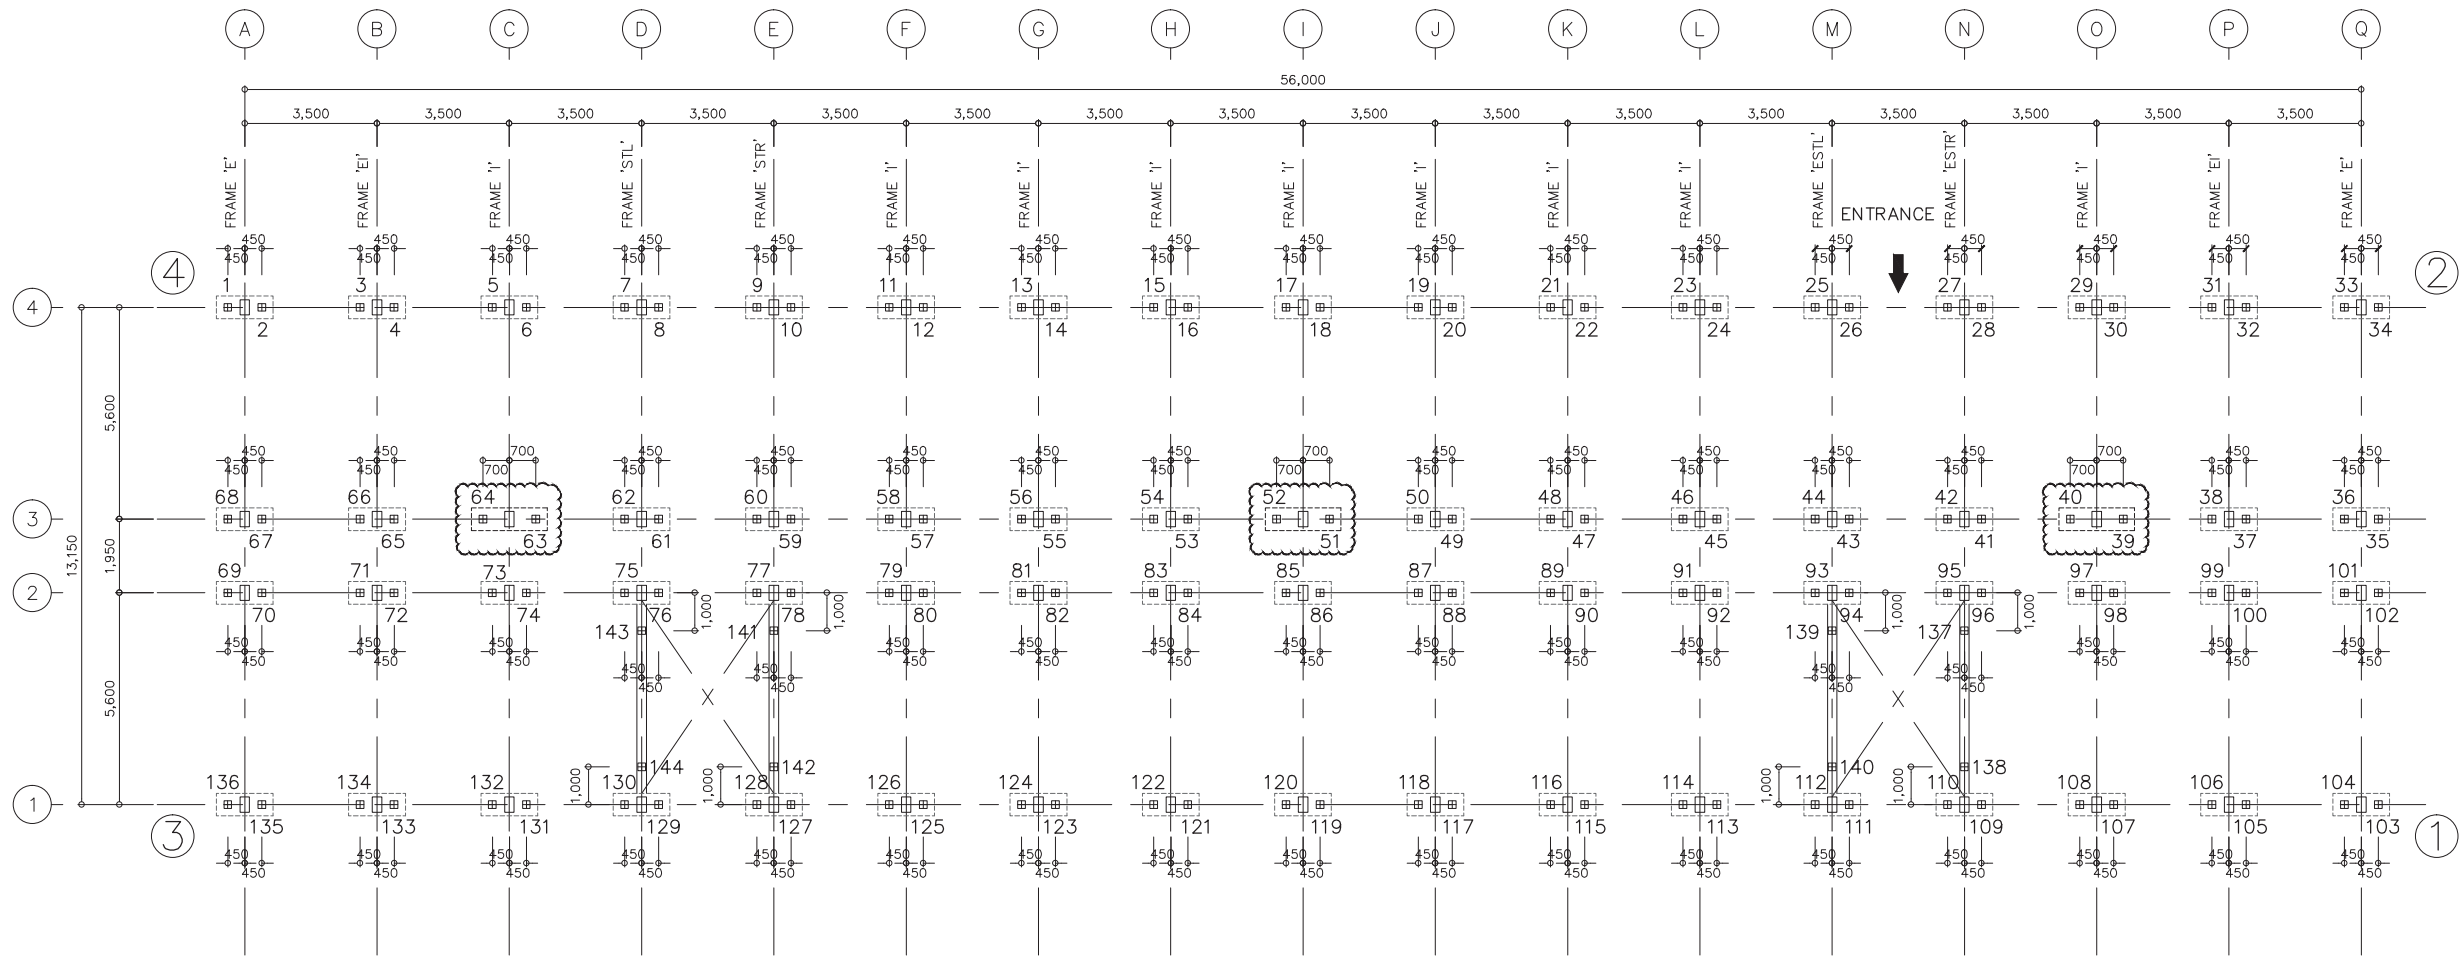


บริษัท เอสบีวัน จำกัด  
(สำนักงานใหญ่)  
537/102 ถนนสายประดิษฐ์ แขวงจันทนาภิรมย์  
เขตจันทนาภิรมย์ กรุงเทพมหานคร 10120

REV. MARK	REVISION	DATE	APPR.	APPROVAL		ESB ONE	ESB ONE CO.,LTD		
				ISSUED FOR			75 White Group Tower 2, 11 <sup>th</sup> Fl., Soi Rubin, Sukhumvit 42, Prakanong, Khlongtoey, Bangkok, Thailand	DRAWING NO.	REV.
△	—	—	—	CONSTRUCTION		PROJECT			
△	—	—	—	DATE			CLIENTS ADDRESS	MAPYANGPHON PLUAK—DAENG RAYONG	
△	—	—	—	APPROVED	—	DRAWING TITLE			PILING PLAN Building N
△	—	—	—	ORDER NO.	—				
△	—	—	—	CONTRACTOR	—	DRAWING NO.	LCH1— T1N—ST—101	REV.	0
△	AS—BUILT	18/08/60	—	CONTRACT DATE	—				



BUILDING Q  
PILING PLAN (TYPE 1)  
SCALE 1:100

PILE NO.	N	E	PILE NO.	N	E	PILE NO.	N	E	PILE NO.	N	E	PILE NO.	N	E	PILE NO.	N	E
1	N. 1436177.0878	E. 731790.5367	26	N. 1436189.4531	E. 731749.4574	51	N. 1436190.8522	E. 731764.2380	76	N. 1436187.6033	E. 731781.7967	101	N. 1436200.4585	E. 731739.0896	126	N. 1436194.7238	E. 731777.5697
2	N. 1436177.3472	E. 731789.6749	27	N. 1436190.2025	E. 731746.9678	52	N. 1436190.4487	E. 731765.5786	77	N. 1436188.3527	E. 731779.3178	102	N. 1436200.7179	E. 731738.2278	127	N. 1436193.9744	E. 731780.0594
3	N. 1436178.0966	E. 731787.1853	28	N. 1436190.4619	E. 731746.1060	53	N. 1436189.7713	E. 731767.8288	78	N. 1436188.6121	E. 731778.4453	103	N. 1436206.0803	E. 731739.8419	128	N. 1436193.7150	E. 731780.9212
4	N. 1436178.3561	E. 731786.3235	29	N. 1436191.2113	E. 731743.6163	54	N. 1436189.5119	E. 731768.6906	79	N. 1436189.3615	E. 731775.9556	104	N. 1436205.8209	E. 731740.7037	129	N. 1436192.9656	E. 731783.4108
5	N. 1436179.1055	E. 731783.8338	30	N. 1436191.4707	E. 731742.7545	55	N. 1436188.7625	E. 731771.1803	80	N. 1436189.6209	E. 731775.0938	105	N. 1436205.0715	E. 731743.1933	130	N. 1436192.7062	E. 731784.2727
6	N. 1436179.3649	E. 731782.9720	31	N. 1436192.2201	E. 731740.2649	56	N. 1436188.5031	E. 731772.0421	81	N. 1436190.3703	E. 731772.6042	106	N. 1436204.8121	E. 731744.0551	131	N. 1436191.9568	E. 731786.7623
7	N. 1436180.1143	E. 731780.4824	32	N. 1436192.4795	E. 731739.4031	57	N. 1436187.7537	E. 731774.5318	82	N. 1436190.6297	E. 731771.7424	107	N. 1436204.0626	E. 731746.5448	132	N. 1436191.6974	E. 731787.6241
8	N. 1436180.3737	E. 731779.6206	33	N. 1436193.2290	E. 731736.9134	58	N. 1436187.4943	E. 731775.3936	83	N. 1436191.3791	E. 731769.2527	108	N. 1436203.8032	E. 731747.4066	133	N. 1436190.9480	E. 731790.1138
9	N. 1436181.1231	E. 731777.1309	34	N. 1436193.4884	E. 731736.0516	59	N. 1436186.7449	E. 731777.8832	84	N. 1436191.6386	E. 731768.3909	109	N. 1436203.0538	E. 731749.8963	134	N. 1436190.6886	E. 731790.9756
10	N. 1436181.3825	E. 731776.2691	35	N. 1436198.8507	E. 731737.6657	60	N. 1436186.4854	E. 731778.7450	85	N. 1436192.3880	E. 731765.9012	110	N. 1436202.7944	E. 731750.7581	135	N. 1436189.9391	E. 731793.4652
11	N. 1436182.1319	E. 731773.7794	36	N. 1436198.5913	E. 731738.5275	61	N. 1436185.7360	E. 731781.2347	86	N. 1436192.6474	E. 731765.0394	111	N. 1436202.0450	E. 731753.2477	136	N. 1436189.6797	E. 731794.3270
12	N. 1436182.3913	E. 731772.9176	37	N. 1436197.8419	E. 731741.0172	62	N. 1436185.4766	E. 731782.0965	87	N. 1436193.3968	E. 731762.5498	112	N. 1436201.7856	E. 731754.1095	137	N. 1436198.5193	E. 731749.0013
13	N. 1436183.1407	E. 731770.4280	38	N. 1436197.5825	E. 731741.8790	63	N. 1436184.7993	E. 731784.3467	88	N. 1436193.6562	E. 731761.6880	113	N. 1436201.0362	E. 731756.5992	138	N. 1436201.9666	E. 731750.0389
14	N. 1436183.4002	E. 731769.5662	39	N. 1436196.9051	E. 731744.1292	64	N. 1436184.3957	E. 731785.6873	89	N. 1436194.4056	E. 731759.1983	114	N. 1436200.7768	E. 731757.4610	139	N. 1436197.5105	E. 731752.3527
15	N. 1436184.1496	E. 731767.0765	40	N. 1436196.5016	E. 731745.4698	65	N. 1436183.7184	E. 731787.9376	90	N. 1436194.6650	E. 731758.3365	115	N. 1436200.0274	E. 731759.9506	140	N. 1436200.9577	E. 731753.3904
16	N. 1436184.4090	E. 731766.2147	41	N. 1436195.8242	E. 731747.7201	66	N. 1436183.4590	E. 731788.7994	91	N. 1436195.4144	E. 731755.8469	116	N. 1436199.7679	E. 731760.8124	141	N. 1436189.4399	E. 731779.1644
17	N. 1436185.1584	E. 731763.7251	42	N. 1436195.5648	E. 731748.5819	67	N. 1436182.7096	E. 731791.2891	92	N. 1436195.6738	E. 731754.9851	117	N. 1436199.0185	E. 731763.3021	142	N. 1436192.8872	E. 731780.2021
18	N. 1436185.4178	E. 731762.8633	43	N. 1436194.8154	E. 731751.0715	68	N. 1436182.4502	E. 731792.1509	93	N. 1436196.4233	E. 731752.4954	118	N. 1436198.7591	E. 731764.1639	143	N. 1436188.4311	E. 731782.5159
19	N. 1436186.1672	E. 731760.3736	44	N. 1436194.5560	E. 731751.9333	69	N. 1436184.3174	E. 731792.7129	94	N. 1436196.6827	E. 731751.6336	119	N. 1436198.0097	E. 731766.6536	144	N. 1436191.8783	E. 731783.5535
20	N. 1436186.4266	E. 731759.5118	45	N. 1436193.8066	E. 731754.4230	70	N. 1436184.5768	E. 731791.8511	95	N. 1436197.4321	E. 731749.1439	120	N. 1436197.7503	E. 731767.5154			
21	N. 1436187.1760	E. 731757.0222	46	N. 1436193.5472	E. 731755.2848	71	N. 1436185.3262	E. 731789.3615	96	N. 1436197.6915	E. 731748.2821	121	N. 1436197.0009	E. 731770.0050			
22	N. 1436187.4354	E. 731756.1603	47	N. 1436192.7978	E. 731757.7745	72	N. 1436185.5856	E. 731788.5146	97	N. 1436198.4409	E. 731745.7925	122	N. 1436196.7415	E. 731770.8668			
23	N. 1436188.1849	E. 731753.6707	48	N. 1436192.5384	E. 731758.6363	73	N. 1436186.3350	E. 731786.0100	98	N. 1436198.7003	E. 731744.9307	123	N. 1436195.9921	E. 731773.3565			
24	N. 1436188.4443	E. 731752.8089	49	N. 1436191.7890	E. 731761.1259	74	N. 1436186.5945	E. 731785.1482	99	N. 1436199.4497	E. 731742.4410	124	N. 1436195.7327	E. 731774.2183			
25	N. 1436189.1937	E. 731750.3192	50	N. 1436191.5295	E. 731762.0016	75	N. 1436187.3439	E. 731782.6585	100	N. 1436199.7091	E. 731741.5792	125	N. 1436194.9832	E. 731776.7079			

 <b>TESCO LTD. CONSULTING ENGINEERS</b> 21/11-14 SOI SUKHUMVIT 18 , BANGKOK 10110 TEL. 259-8573 (10 LINES AUTOMATIC) FAX 258-1313					
DESIGN	NAME	SIGNATURE	DESIGN	NAME	SIGNATURE
ARCHITECT	NARAE T. สรณ.1821		MECHANICAL ENGINEER	POTE L. สรณ.2055	
	PIYA S. สรณ.9661			WICHAN T. สรณ.14151	
STRUCTURAL ENGINEER	YUTTANA C. สรณ.6404		ELECTRICAL ENGINEER	TOSAPHON B. สรณ.2341	
CIVIL ENGINEER	PASIT T. สรณ.2706		SANITARY ENGINEER	PASIT T. สรณ.2706	
DATE 28/1/2014					













บริษัท ทรอสต์ วิศวกรรม จำกัด  
(สำนักงานใหญ่)  
537/102 ถนนสายประดิษฐ์ แขวงจันทนาภิรมย์  
เขตจันทนาภิรมย์ กรุงเทพมหานคร 10120

REV. MARK	REVISION	DATE	APPR.	APPROVAL		ESB ONE	ESB ONE CO.,LTD			
△	—	—	—	ISSUED FOR			PROJECT	75 White Group Tower 2, 11 <sup>th</sup> Fl., Soi Rubin, Sukhumvit 42, Prakanong, Khlongtoey, Bangkok, Thailand		
△	—	—	—	CONSTRUCTION				CLIENTS ADDRESS	LCH — PROJECT 1	
△	—	—	—	DATE —					DRAWING TITLE	MAPYANGPHON PLUAK—DAENG RAYONG
△	—	—	—	APPROVED	—	SCALE				
△	—	—	—	ORDER NO.	—	1:100				
△	—	—	—	CONTRACTOR	—	PILING PLAN Building Q	DRAWING NO. LCH1— T1Q—ST—101	REV. 0		
△	AS—BUILT	18/08/60	—	CONTRACT DATE	—					





























PILE NO.	N	E	PILE NO.	N	E	PILE NO.	N	E	PILE NO.	N	E	PILE NO.	N	E	PILE NO.	N	E
1	N. 1436191.9800	E. 731613.9564	26	N. 1436232.0925	E. 731629.1683	51	N. 1436217.2502	E. 731629.5288	76	N. 1436199.9621	E. 731625.0581	101	N. 1436241.6641	E. 731640.8728	126	N. 1436203.6800	E. 731632.4572
2	N. 1436192.8215	E. 731614.2755	27	N. 1436234.5235	E. 731630.0902	52	N. 1436215.9412	E. 731629.0324	77	N. 1436202.3932	E. 731625.9800	102	N. 1436242.5056	E. 731641.1919	127	N. 1436201.2490	E. 731631.5353
3	N. 1436195.2526	E. 731615.1974	28	N. 1436235.3650	E. 731630.4093	53	N. 1436213.7439	E. 731628.1991	78	N. 1436203.2347	E. 731626.2992	103	N. 1436240.5199	E. 731646.4281	128	N. 1436200.4075	E. 731631.2162
4	N. 1436196.0941	E. 731615.5166	29	N. 1436237.7961	E. 731631.3313	54	N. 1436212.9024	E. 731627.8799	79	N. 1436205.6657	E. 731627.2211	104	N. 1436239.6784	E. 731646.1089	129	N. 1436197.9764	E. 731630.2942
5	N. 1436198.5252	E. 731616.4385	30	N. 1436238.6376	E. 731631.6504	55	N. 1436210.4713	E. 731626.9580	80	N. 1436206.5073	E. 731627.5402	105	N. 1436237.2473	E. 731645.1870	130	N. 1436197.1349	E. 731629.9751
6	N. 1436199.3667	E. 731616.7576	31	N. 1436241.0687	E. 731632.5723	56	N. 1436209.6298	E. 731626.6389	81	N. 1436208.9383	E. 731628.4622	106	N. 1436236.4058	E. 731644.8679	131	N. 1436194.7038	E. 731629.0532
7	N. 1436201.7977	E. 731617.6796	32	N. 1436241.9102	E. 731632.8915	57	N. 1436207.1987	E. 731625.7169	82	N. 1436209.7798	E. 731628.7813	107	N. 1436233.9748	E. 731643.9459	132	N. 1436193.8623	E. 731628.7340
8	N. 1436202.6393	E. 731617.9987	33	N. 1436244.3412	E. 731633.8134	58	N. 1436206.3572	E. 731625.3978	83	N. 1436212.2109	E. 731629.7032	108	N. 1436233.1332	E. 731643.6268	133	N. 1436191.4313	E. 731627.8121
9	N. 1436205.0703	E. 731618.9206	34	N. 1436245.1828	E. 731634.1325	59	N. 1436203.9261	E. 731624.4759	84	N. 1436213.0524	E. 731630.0224	109	N. 1436230.7022	E. 731642.7049	134	N. 1436190.5897	E. 731627.4930
10	N. 1436205.9118	E. 731619.2398	35	N. 1436243.1971	E. 731639.3687	60	N. 1436203.0846	E. 731624.1567	85	N. 1436215.4835	E. 731630.9443	110	N. 1436229.8607	E. 731642.3857	135	N. 1436188.1587	E. 731626.5710
11	N. 1436208.3429	E. 731620.1617	36	N. 1436242.3555	E. 731639.0495	61	N. 1436200.6536	E. 731623.2348	86	N. 1436216.3250	E. 731631.2634	111	N. 1436227.4296	E. 731641.4638	136	N. 1436187.3172	E. 731626.2519
12	N. 1436209.1844	E. 731620.4808	37	N. 1436239.9245	E. 731638.1276	62	N. 1436199.8120	E. 731622.9157	87	N. 1436218.7561	E. 731632.1854	112	N. 1436226.5881	E. 731641.1447	137	N. 1436231.9125	E. 731638.2442
13	N. 1436211.6155	E. 731621.4028	38	N. 1436239.0830	E. 731637.8085	63	N. 1436197.6147	E. 731622.0824	88	N. 1436219.5976	E. 731632.5045	113	N. 1436224.1570	E. 731640.2227	138	N. 1436230.6360	E. 731641.6103
14	N. 1436212.4570	E. 731621.7219	39	N. 1436236.8857	E. 731636.9752	64	N. 1436196.3057	E. 731621.5860	89	N. 1436222.0286	E. 731633.4264	114	N. 1436223.3155	E. 731639.9036	139	N. 1436228.6400	E. 731637.0031
15	N. 1436214.8881	E. 731622.6438	40	N. 1436235.5766	E. 731636.4787	65	N. 1436194.1084	E. 731620.7527	90	N. 1436222.8702	E. 731633.7592	115	N. 1436220.8844	E. 731638.9			


 <b>TESCO LTD. CONSULTING ENGINEERS</b> 21/11-14 SOI SUKHUMVIT 18 , BANGKOK 10110 TEL. 259-6573 (10 LINES AUTOMATIC) FAX 258-1313							 <p>บริษัท ทอส์ อีริคเกอร์ จำกัด (สำนักงานใหญ่)</p> <p>537/102 ถนนสาธุประดิษฐ์ แขวงคลองจั่น เขตยานนาวา กรุงเทพมหานคร 10120</p>		REV.	REVISION	DATE	APPR.	APPROVAL		ESB ONE	ESB ONE CO.,LTD	
DESIGN	NAME	SIGNATURE	DESIGN	NAME	SIGNATURE	DATE				ISSUED FOR CONSTRUCTION							
ARCHITECT	NARAE T. ชื่อ 1821		MECHANICAL ENGINEER	POTE L. ชื่อ 2055		28/1/2014			DATE	-	PROJECT	LCH - PROJECT 1					
	PYA S. ชื่อ 9661			WICHAN T. ชื่อ 14151					APPROVED	-	Clients ADDRESS	MAYNAPHONG PLUAK-DAENG RAYONG	SCALE	1:100			
STRUCTURAL ENGINEER	YUTTANA C. ชื่อ 6404		ELECTRICAL ENGINEER	TOSAPHON B. ชื่อ 2341					ORDER NO.	-	DRAWING TITLE	PILING PLAN					
	PASIT T. ชื่อ 2706		SANITARY ENGINEER	PASIT T. ชื่อ 2706					CONTRACTOR	-		Building R	DRAWING NO.	LCH1-TIR-ST-101			
CIVIL ENGINEER									CONTRACT DATE	-			REV.	0			
								AS-BUILT		18/08/60							






- 1.) ALL REBAR LAP TO F.T.L. TYP UNO
- 2.) REFER TO DWG. NO. S1-00 FOR RECOMMENDED PREBORING DEPTH.
- 3.) MECHANICAL LAP SHALL BE USED
- 4.) FOR FOOTING DETAILS REFER TO DRAWING S1-00
- 5.) BUILDING SETOUT DIMENSIONS & LEVEL TO ARCH. DWG.


<div></div> <div>TESCO LTD. CONSULTING ENGINEERS</div> <div>21/11-14 SOI SUKHUMVIT 18 , BANGKOK 10110</div> <div>TEL. 259-6573 (10 LINES AUTOMATIC) FAX 258-1313</div>						<div></div> <div>วิศวกร วิศวกรก่อสร้าง จำกัด</div> <div>(สำนักงานใหญ่)</div> <div>537/102 ถนนสาธุประดิษฐ์ แขวงจันทนาภิรมย์</div> <div>เขตยานนาวา กรุงเทพมหานคร 10120</div>		<table><tr><th>REV.</th><th>REVISION</th><th>DATE</th><th>APPR.</th><th colspan="2">APPROVAL</th></tr><tr><th>MARK</th><th></th><th></th><th></th><th colspan="2">ISSUED FOR</th></tr><tr><td>—</td><td>—</td><td>—</td><td>—</td><td colspan="2">CONSTRUCTION</td></tr><tr><td>△</td><td>—</td><td>—</td><td>—</td><td colspan="2">DATE</td></tr><tr><td>△</td><td>—</td><td>—</td><td>—</td><td colspan="2">APPROVED</td></tr><tr><td>△</td><td>—</td><td>—</td><td>—</td><td colspan="2">ORDER NO.</td></tr><tr><td>△</td><td>—</td><td>—</td><td>—</td><td colspan="2">CONTRACTOR</td></tr><tr><td>△</td><td>AS-BUILT</td><td>18/08/60</td><td>—</td><td colspan="2">CONTRACT DATE</td></tr></table>		REV.	REVISION	DATE	APPR.	APPROVAL		MARK				ISSUED FOR		—	—	—	—	CONSTRUCTION		△	—	—	—	DATE		△	—	—	—	APPROVED		△	—	—	—	ORDER NO.		△	—	—	—	CONTRACTOR		△	AS-BUILT	18/08/60	—	CONTRACT DATE		<table><tr><td colspan="2">ESB ONE</td><td colspan="2">ESB ONE CO.,LTD</td></tr><tr><td colspan="2"></td><td colspan="2">75 White Group Tower 2, 11<sup>th</sup> Fl., Soi Rubie, Sukhumvit 42, Prakanong, Khlongtoey, Bangkok, Thailand</td></tr><tr><td>PROJECT</td><td colspan="2">LCH — PROJECT 1</td><td>SCALE</td></tr><tr><td>CLIENTS ADDRESS</td><td colspan="2">MAPYANGPHON PLUAK—DAENG RAYONG</td><td>A1=1:15, A3=1:30</td></tr><tr><td>DRAWING TITLE</td><td colspan="2">F2 FOUNDATION DETAILS</td><td>DRAWING NO. LCH-T1-ST-111</td></tr><tr><td></td><td></td><td></td><td>REV. 0</td></tr></table>				ESB ONE		ESB ONE CO.,LTD				75 White Group Tower 2, 11 <sup>th</sup> Fl., Soi Rubie, Sukhumvit 42, Prakanong, Khlongtoey, Bangkok, Thailand		PROJECT	LCH — PROJECT 1		SCALE	CLIENTS ADDRESS	MAPYANGPHON PLUAK—DAENG RAYONG		A1=1:15, A3=1:30	DRAWING TITLE	F2 FOUNDATION DETAILS		DRAWING NO. LCH-T1-ST-111				REV. 0
REV.	REVISION	DATE	APPR.	APPROVAL																																																																																	
MARK				ISSUED FOR																																																																																	
—	—	—	—	CONSTRUCTION																																																																																	
△	—	—	—	DATE																																																																																	
△	—	—	—	APPROVED																																																																																	
△	—	—	—	ORDER NO.																																																																																	
△	—	—	—	CONTRACTOR																																																																																	
△	AS-BUILT	18/08/60	—	CONTRACT DATE																																																																																	
ESB ONE		ESB ONE CO.,LTD																																																																																			
		75 White Group Tower 2, 11 <sup>th</sup> Fl., Soi Rubie, Sukhumvit 42, Prakanong, Khlongtoey, Bangkok, Thailand																																																																																			
PROJECT	LCH — PROJECT 1		SCALE																																																																																		
CLIENTS ADDRESS	MAPYANGPHON PLUAK—DAENG RAYONG		A1=1:15, A3=1:30																																																																																		
DRAWING TITLE	F2 FOUNDATION DETAILS		DRAWING NO. LCH-T1-ST-111																																																																																		
			REV. 0																																																																																		
<table><tr><th>DESIGN</th><th>NAME</th><th>SIGNATURE</th><th>DESIGN</th><th>NAME</th><th>SIGNATURE</th><th>DATE</th></tr><tr><td>ARCHITECT</td><td>NARAEI T. ๙๙๙.1821</td><td></td><td>MECHANICAL ENGINEER</td><td>POTE L. ๙๙๙.2055</td><td></td><td rowspan="4">28/1/2014</td></tr><tr><td></td><td>PIYA S. ๙๙๙.9661</td><td></td><td></td><td>WICHIAN T. ๙๙๙.14151</td><td></td></tr><tr><td>STRUCTURAL ENGINEER</td><td>YUTTANA C. ๙๙๙.6404</td><td></td><td>ELECTRICAL ENGINEER</td><td>TOSAPHON B. ๙๙๙.2341</td><td></td></tr><tr><td>CIVIL ENGINEER</td><td>PASIT T. ๙๙๙.2706</td><td></td><td>SANITARY ENGINEER</td><td>PASIT T. ๙๙๙.2706</td><td></td></tr></table>	DESIGN	NAME	SIGNATURE	DESIGN	NAME	SIGNATURE	DATE	ARCHITECT	NARAEI T. ๙๙๙.1821		MECHANICAL ENGINEER	POTE L. ๙๙๙.2055		28/1/2014		PIYA S. ๙๙๙.9661			WICHIAN T. ๙๙๙.14151		STRUCTURAL ENGINEER	YUTTANA C. ๙๙๙.6404		ELECTRICAL ENGINEER	TOSAPHON B. ๙๙๙.2341		CIVIL ENGINEER	PASIT T. ๙๙๙.2706		SANITARY ENGINEER	PASIT T. ๙๙๙.2706																																																						
DESIGN	NAME	SIGNATURE	DESIGN	NAME	SIGNATURE	DATE																																																																															
ARCHITECT	NARAEI T. ๙๙๙.1821		MECHANICAL ENGINEER	POTE L. ๙๙๙.2055		28/1/2014																																																																															
	PIYA S. ๙๙๙.9661			WICHIAN T. ๙๙๙.14151																																																																																	
STRUCTURAL ENGINEER	YUTTANA C. ๙๙๙.6404		ELECTRICAL ENGINEER	TOSAPHON B. ๙๙๙.2341																																																																																	
CIVIL ENGINEER	PASIT T. ๙๙๙.2706		SANITARY ENGINEER	PASIT T. ๙๙๙.2706																																																																																	

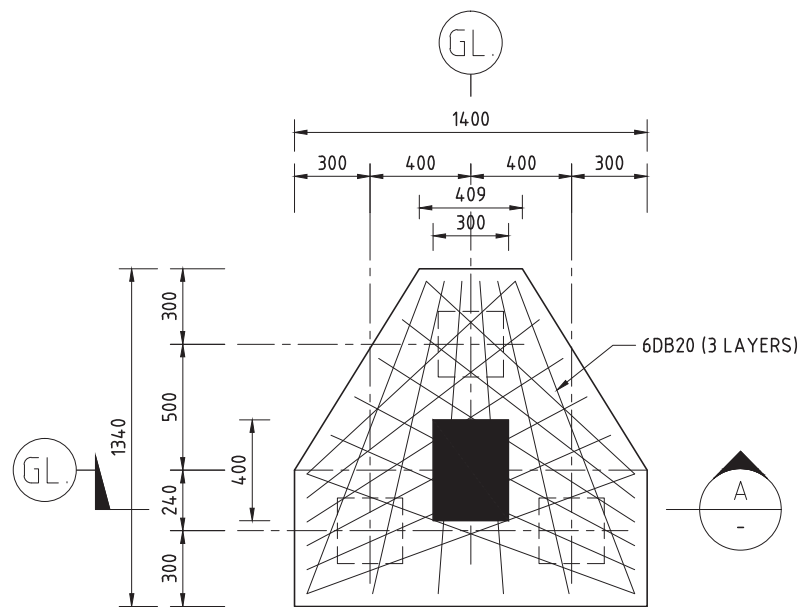


F3 DETAIL  
SCALE 1:15

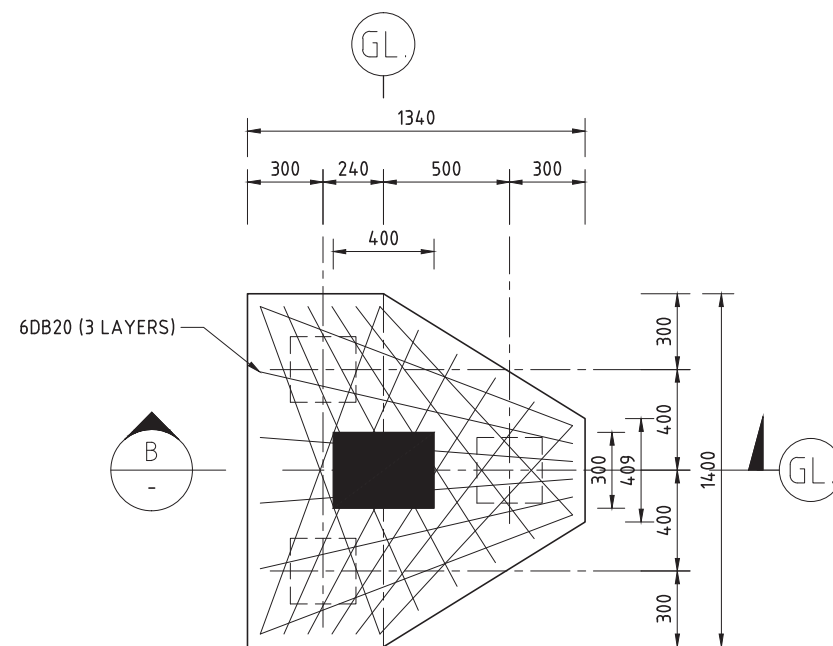

F3 DETAIL  
SCALE 1:15

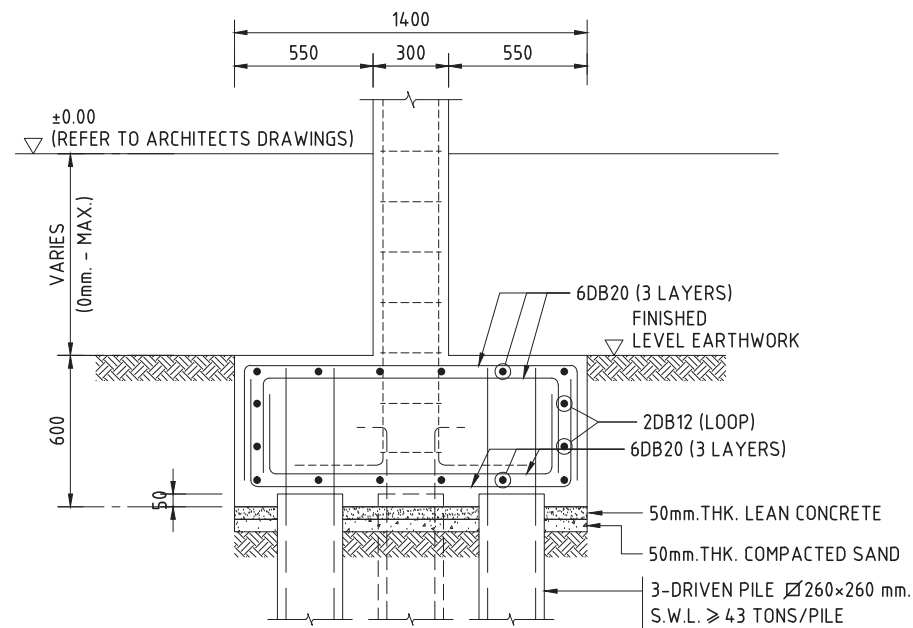



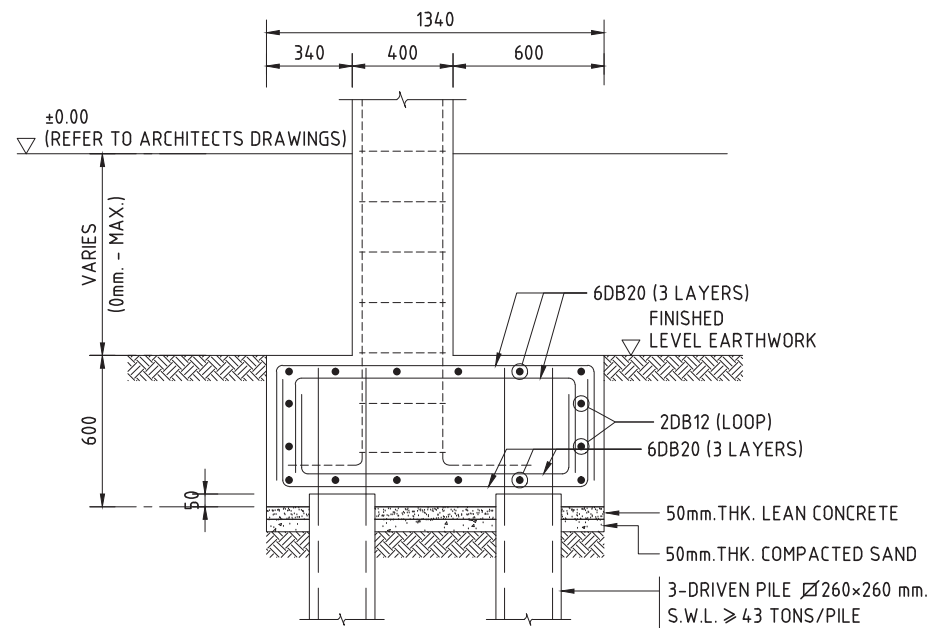






SECTION A  
SCALE 1:15



SECTION B  
SCALE 1:15

NOTE :

- 1.) ALL REBAR LAP TO F.T.L. TYP UNO
- 2.) REFER TO DWG. NO. S1-00 FOR RECOMMENDED PREBORING DEPTH.
- 3.) MECHANICAL LAP SHALL BE USED
- 4.) FOR FOOTING DETAILS REFER TO DRAWING S1-00
- 5.) BUILDING SETOUT DIMENSIONS & LEVEL TO ARCH. DWG.

 <b>TESCO LTD. CONSULTING ENGINEERS</b> 21/11-14 SOI SUKHUMVIT 18 , BANGKOK 10110 TEL. 259-8573 (10 LINES AUTOMATIC) FAX 258-1313					
DESIGN	NAME	SIGNATURE	DESIGN	NAME	SIGNATURE
ARCHITECT	NARAET T. ๙๙๑.1821		MECHANICAL ENGINEER	POTE L. ๙๙๑.2055	
	PIYA S. ๙๙๑.9661			WICHAN T. ๙๙๑.14151	
STRUCTURAL ENGINEER	YUTTANA C. ๙๙๑.6404		ELECTRICAL ENGINEER	TOSAPHON B. ๙๙๑.2341	
CIVIL ENGINEER	PASIT T. ๙๙๑.2706		SANITARY ENGINEER	PASIT T. ๙๙๑.2706	
DATE 28/1/2014					




บริษัท เอสบีวัน จำกัด  
(สำนักงานใหญ่)  
537/102 ถนนสาธุประดิษฐ์ แขวงคลองจั่น  
เขตยานนาวา กรุงเทพมหานคร 10120

REV. MARK	REVISION	DATE	APPR.	APPROVAL		ESB ONE	ESB ONE CO.,LTD		
				ISSUED FOR			75 White Group Tower 2, 11 <sup>th</sup> Fl., Soi Rubin, Sukhumvit 42, Prakanong, Khlongtoey, Bangkok, Thailand		
△	—	—	—	CONSTRUCTION		PROJECT	LCH — PROJECT 1		
△	—	—	—	DATE		CLIENTS ADDRESS	MAPYANGPHON PLUAK—DAENG RAYONG		
△	—	—	—	APPROVED	—	DRAWING TITLE	F3 FOUNDATION DETAILS		
△	—	—	—	ORDER NO.	—				
△	—	—	—	CONTRACTOR	—				
△	—	—	—	CONTRACT DATE	—				
△	AS—BUILT	18/05/60	—			SCALE		1:15	
						DRAWING NO.		LCHI-T1-ST-111-1	REV. 0







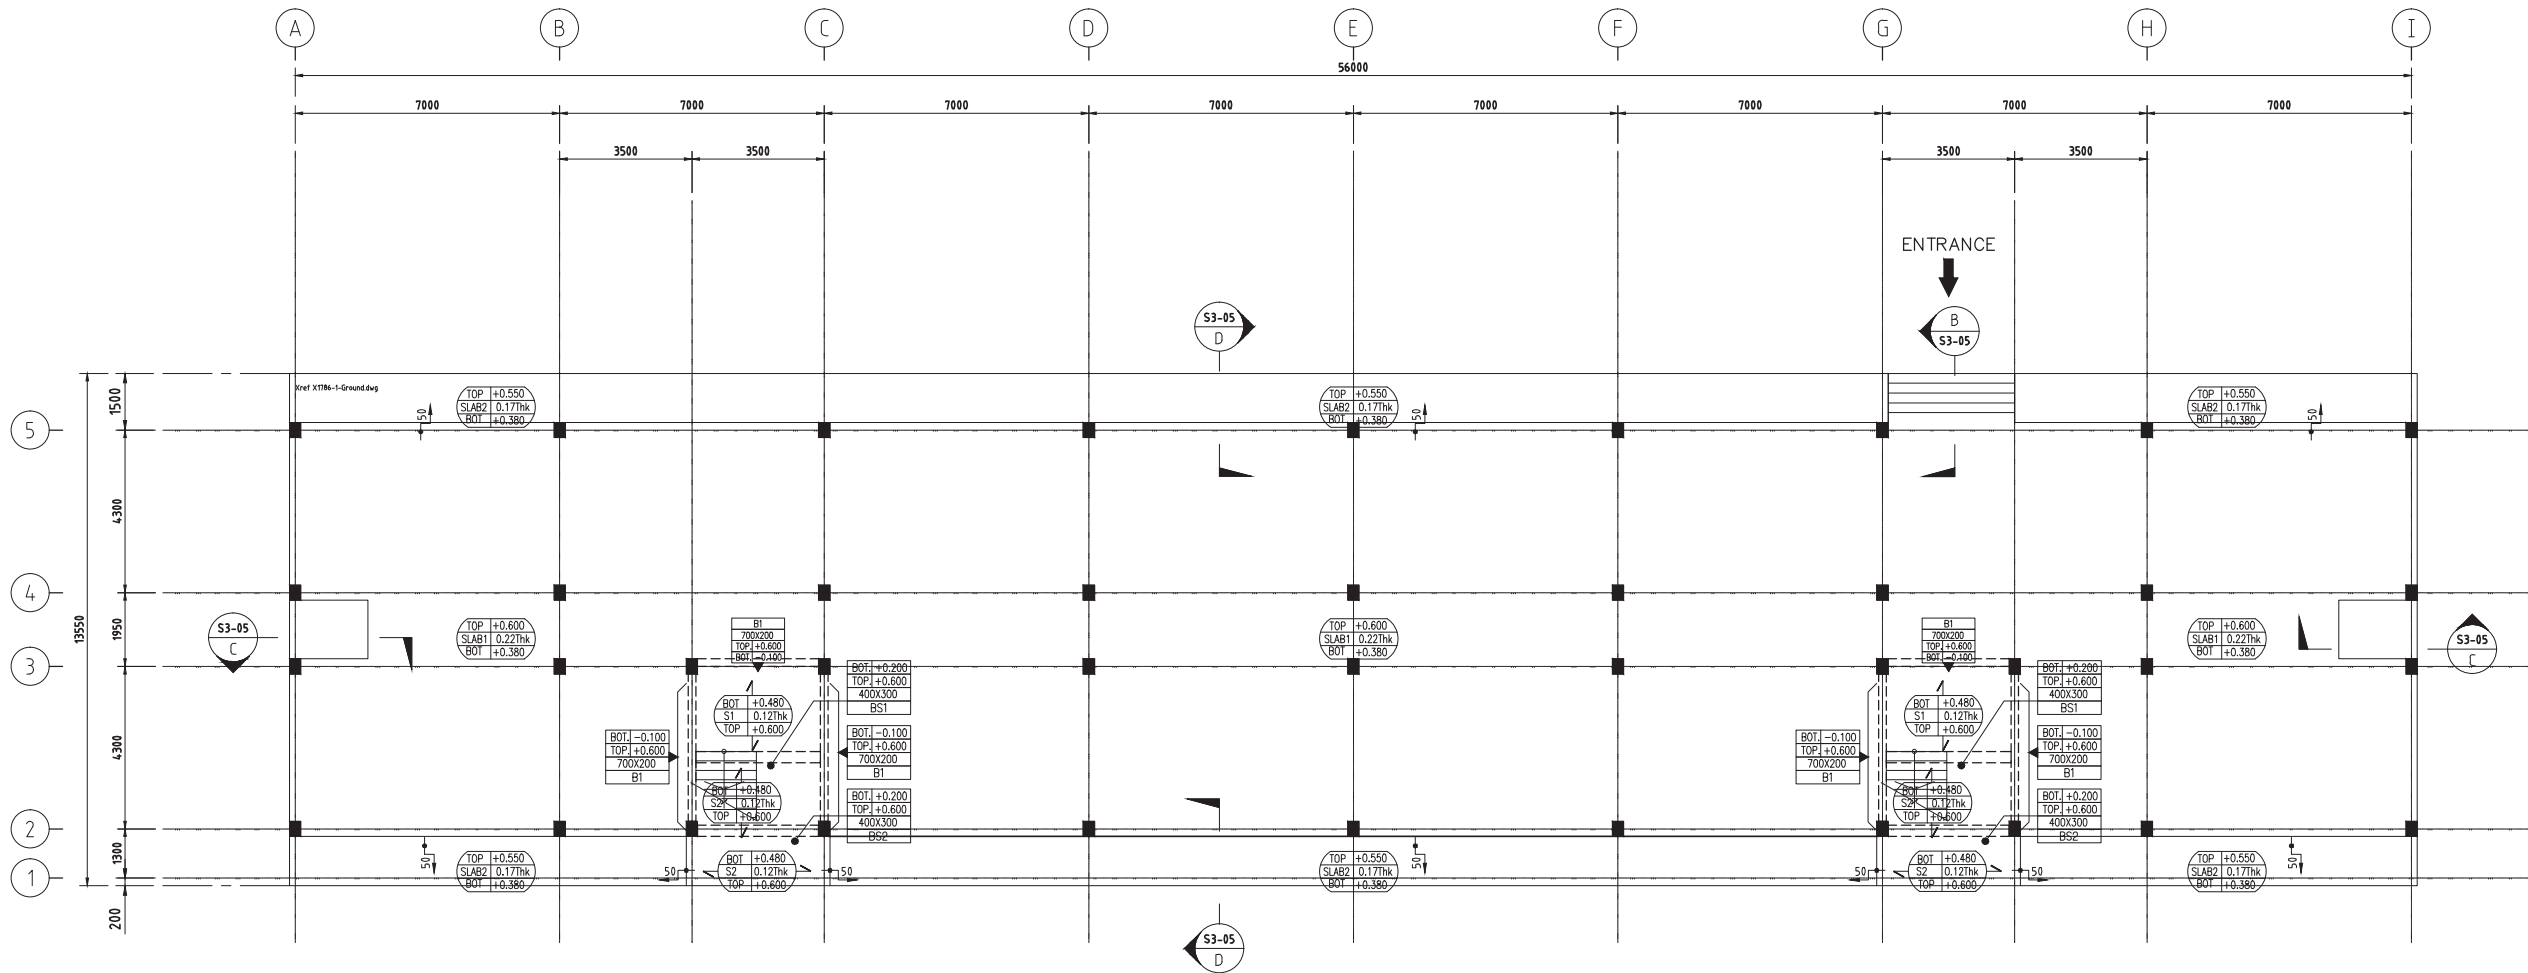

1st FLOOR FRAMING PLAN  
SCALE 1:100

ALLOWABLE SUPERIMPOSED LOAD (Kg/m<sup>2</sup>)


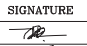







FUNCTION AREA	DEAD LOAD	LIVE LOAD
CORRIDOR / STAIR	- FLOOR FINISHING	300
	- SERVICES + CEILING	
ROOM	- FLOOR FINISHING	200
	- SERVICES + CEILING	
	- WALL PARTITIONS	

NOTES

1.TOP CERAMIC BUILDING B EL.+69.42  
2.TOP SLAB GROUND FLOOR BUILDING B EL.+69.405

NOTES:

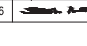- 1) ALL SYMBOLS AND ABBREVIATIONS REPRESENT ;
- DENOTES SLAB THICKNESS (mm.).
  - DENOTES COLUMN ABOVE ONLY.
  - ⊙ DENOTES COLUMN BELOW ONLY.
  - W / B/ DENOTES WALL BELOW ONLY.
  - ↕ DENOTES DIFFERENT SLAB LEVEL (STEP).
  - ↕ DENOTES TWO-WAY SLAB SYSTEM.
- 2.) FOR SLAB REINFORCEMENT ;  
REFER TO DRAWING NO. S3-01 TO S3-05
- 3.) ALL BEAM SIZE ARE TO BE ;  
REFER TO DRAWING NO. S4-01
- 4.) ALL COLUMN SIZES ARE TO BE ;  
REFER TO DRAWING NO. S5-01
- 5.) FOR SLAB FINISHING DETAIL, FINISHED LEVEL AND STRUCTURAL SLAB LEVEL,  
REFER TO ARCHITECTURAL DRAWING
- 6.) ALL TYPICAL DETAILS APPLY


<div><b>TESCO LTD. CONSULTING ENGINEERS</b> 21/11-14 SOI SUKHUMVIT 18 , BANGKOK 10110 TEL. 259-8573 (10 LINES AUTOMATIC) FAX 258-1313</div>					
DESIGN	NAME	SIGNATURE	DESIGN	NAME	SIGNATURE
ARCHITECT	NARAET T. สร.1821		MECHANICAL ENGINEER	POTE L. สร.2055	
	PIYA S. สร.1961			WICHAN T. สร.14151	
STRUCTURAL ENGINEER	YUTTANA C. สร.6404		ELECTRICAL ENGINEER	TOSAPHON B. สร.12341	
CIVIL ENGINEER	PASIT T. สร.2706		SANITARY ENGINEER	PASIT T. สร.2706	
DATE 17/11/2014					



บริษัท เอสบีวัน จำกัด  
(สำนักงานใหญ่)  
537/102 ถนนสาธุประดิษฐ์ แขวงคลองจั่น  
เขตยานนาวา กรุงเทพมหานคร 10120

REV. MARK	REVISION	DATE	APPR.	APPROVAL	
				ISSUED FOR	CONSTRUCTION
△	-	-	-	DATE	-
△	-	-	-	APPROVED	-
△	-	-	-	ORDER NO.	-
△	-	-	-	CONTRACTOR	-
△	-	-	-	CONTRACT DATE	-
△	AS-BUILT	18/08/60	-		

ESB ONE		ESB ONE CO.,LTD	
		75 White Group Tower 2, 11 <sup>th</sup> Fl., Soi Rubin, Sukhumvit 42, Prakanong, Khlongtoey, Bangkok, Thailand	
PROJECT	LCH - PROJECT 1	CLIENTS ADDRESS	MAPYANGPHON PLUAK-DAENG RAYONG
DRAWING TITLE	TYPICAL 1st FLOOR FRAMING PLAN		
SCALE	A1=1:100, A3=1:200	DRAWING NO.	LCH1-T1-ST-201
REV.	0		

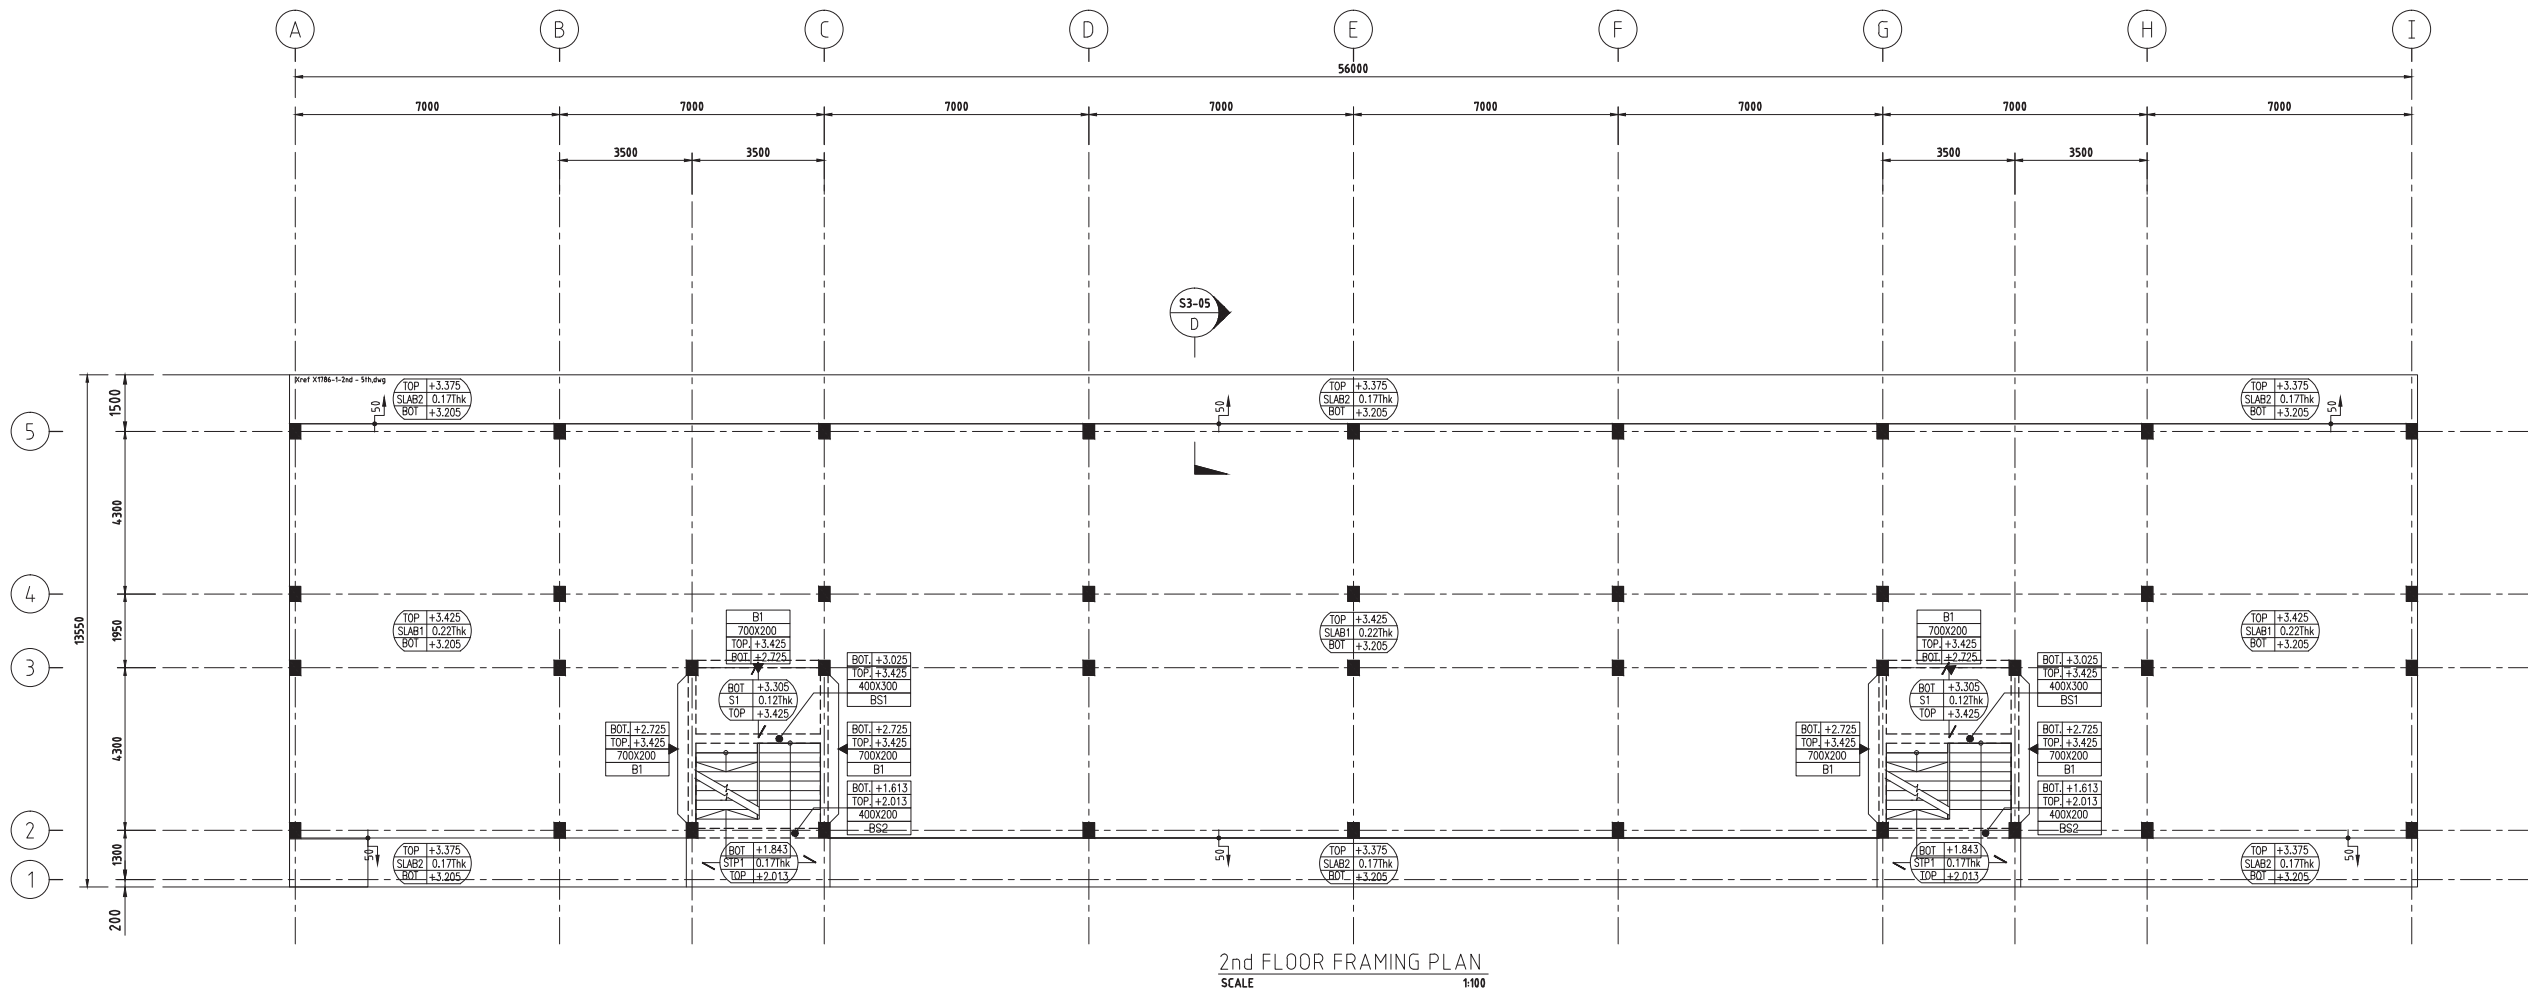


ALLOWABLE SUPERIMPOSED LOAD (Kg/m.<sup>2</sup>)

FUNCTION AREA	DEAD LOAD		LIVE LOAD
CORRIDOR / STAIR	- FLOOR FINISHING	70	300
	- SERVICES + CEILING	20	
ROOM	- FLOOR FINISHING	70	200
	- SERVICES + CEILING	20	
	- WALL PARTITIONS	110	

NOTES :


- 1) ALL SYMBOLS AND ABBREVIATIONS REPRESENT ;
  - DENOTES SLAB THICKNESS (mm).
  - DENOTES COLUMN ABOVE ONLY.
  - DENOTES COLUMN BELOW ONLY.
  - DENOTES DIFFERENT SLAB LEVEL (STEP).
- 2) FOR SLAB REINFORCEMENT ;  
REFER TO DRAWING NO. S3-01 TO S3-05
- 3) ALL BEAM SIZE ARE TO BE ;  
REFER TO DRAWING NO. S4-01
- 4) ALL COLUMN SIZES ARE TO BE ;  
REFER TO DRAWING NO. S5-01
- 5) FOR SLAB FINISHING DETAIL, FINISHED LEVEL AND STRUCTURAL SLAB LEVEL,  
REFER TO ARCHITECTURAL DRAWING
- 6) ALL TYPICAL DETAILS APPLY

<div><b>TESCO LTD. CONSULTING ENGINEERS</b> 21/11-14 SOI SUKHUMVIT 18 , BANGKOK 10110 TEL. 259-8573 (10 LINES AUTOMATIC) FAX 258-1313</div>						DATE 17/11/2014
DESIGN	NAME	SIGNATURE	DESIGN	NAME	SIGNATURE	
ARCHITECT	NARAET T.	ชื่อ.1821	MECHANICAL ENGINEER	POTE L.	ชื่อ.2055	
	PIYA S.	ชื่อ.9661		WICHAN T.	ชื่อ.14151	
STRUCTURAL ENGINEER	YUTTANA C.	ชื่อ.6404	ELECTRICAL ENGINEER	TOSAPHON B.	ชื่อ.12341	
CIVIL ENGINEER	PASIT T.	ชื่อ.2706	SANITARY ENGINEER	PASIT T.	ชื่อ.2706	



บริษัท เอสบีวัน จำกัด  
(สำนักงานใหญ่)  
537/102 ถนนสาธุประดิษฐ์ แขวงคลองจั่น  
เขตยานนาวา กรุงเทพมหานคร 10120

REV. MARK	REVISION	DATE	APPR.	APPROVAL		ESB ONE	ESB ONE CO.,LTD			
				ISSUED FOR			75 White Group Tower 2, 11 <sup>th</sup> Fl, Soi Rubia, Sukhumvit 42, Prakanong, Khlongtoey, Bangkok, Thailand			
△	—	—	—	CONSTRUCTION		PROJECT	LCH — PROJECT 1		SCALE A1=1:100, A3=1:200	REV. 0
△	—	—	—	DATE —		CLIENTS ADDRESS	MAPYANGPHON PLUAK-DAENG RAYONG			
△	—	—	—	APPROVED	—	DRAWING TITLE	TYPICAL 2nd–5th FLOOR FRAMING PLAN			
△	—	—	—	ORDER NO.	—					
△	—	—	—	CONTRACTOR	—					
△	AS–BUILT	18/08/60	—	CONTRACT DATE		—		DRAWING NO. LCHI-T1-ST-203		

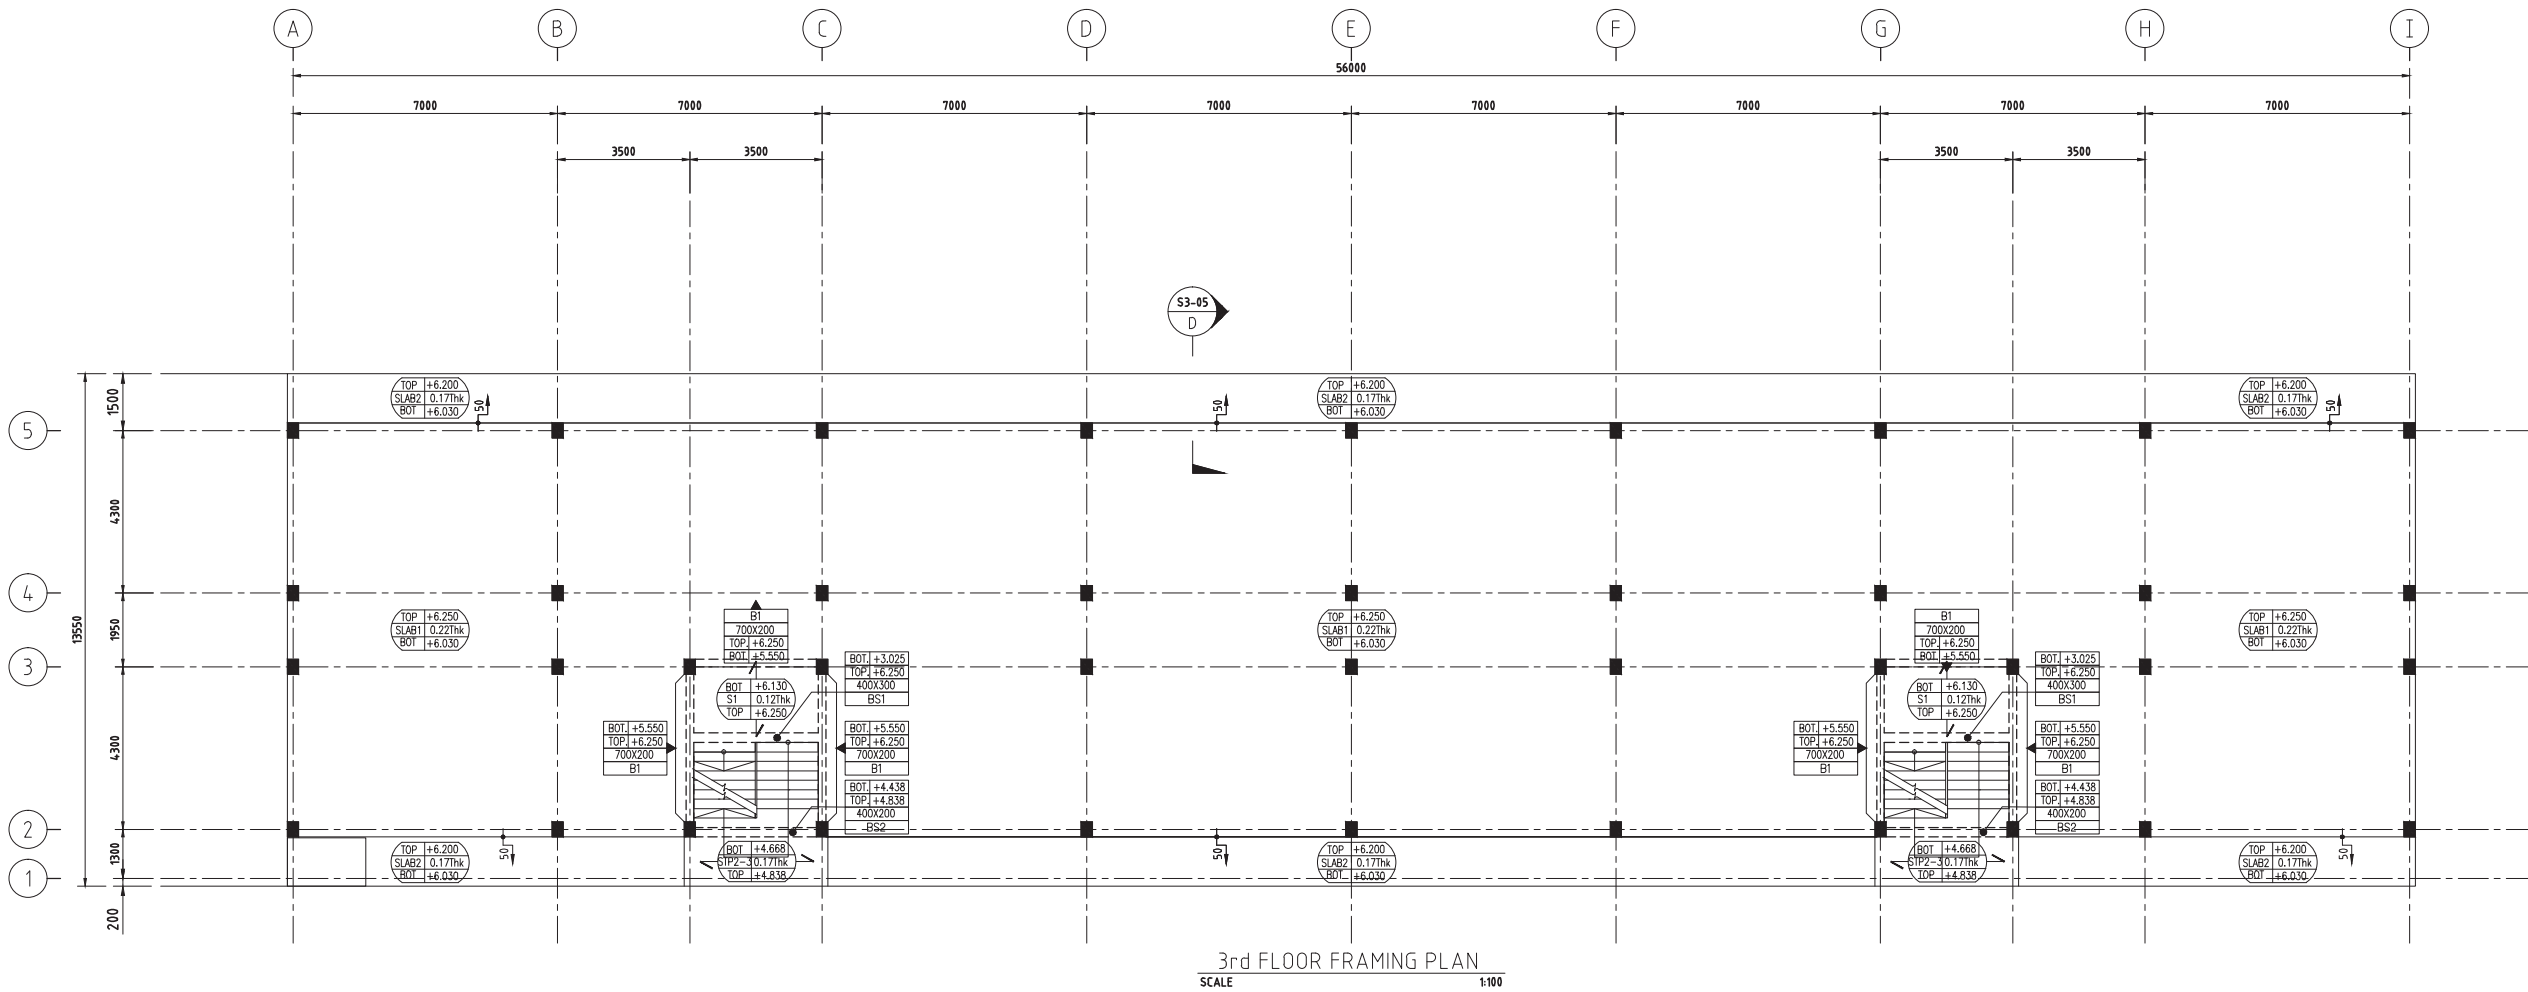
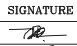



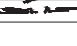





ALLOWABLE SUPERIMPOSED LOAD (Kg/m<sup>2</sup>)

FUNCTION AREA	DEAD LOAD	LIVE LOAD
CORRIDOR / STAIR	- FLOOR FINISHING	70
	- SERVICES + CEILING	20
ROOM	- FLOOR FINISHING	70
	- SERVICES + CEILING	20
	- WALL PARTITIONS	110

NOTES :



- ALL SYMBOLS AND ABBREVIATIONS REPRESENT ;
  - DENOTES SLAB THICKNESS (mm.).
  - DENOTES COLUMN ABOVE ONLY.
  - DENOTES COLUMN BELOW ONLY.
  - DENOTES DIFFERENT SLAB LEVEL (STEP).
- FOR SLAB REINFORCEMENT ;  
REFER TO DRAWING NO. S3-01 TO S3-05
- ALL BEAM SIZE ARE TO BE ;  
REFER TO DRAWING NO. S4-01
- ALL COLUMN SIZES ARE TO BE ;  
REFER TO DRAWING NO. S5-01
- FOR SLAB FINISHING DETAIL, FINISHED LEVEL AND STRUCTURAL SLAB LEVEL,  
REFER TO ARCHITECTURAL DRAWING
- ALL TYPICAL DETAILS APPLY


<div><div><div>TESCO LTD. CONSULTING ENGINEERS</div><div>21/11-14 SOI SUKHUMVIT 18 , BANGKOK 10110</div><div>TEL. 259-8573 (10 LINES AUTOMATIC) FAX 258-1313</div></div></div>					
DESIGN	NAME	SIGNATURE	DESIGN	NAME	SIGNATURE
ARCHITECT	NARAET T. สร.1821		MECHANICAL ENGINEER	POTE L. สร.2055	
	PIYA S. สร.19661			WICHAN T. สร.14151	
STRUCTURAL ENGINEER	YUTTANA C. สร.6404		ELECTRICAL ENGINEER	TOSAPHON B. สร.12341	
CIVIL ENGINEER	PASIT T. สร.2706		SANITARY ENGINEER	PASIT T. สร.2706	
DATE			17/11/2014		



บริษัท เอสบี หนึ่ง จำกัด  
(สำนักงานใหญ่)  
537/102 ถนนสาธุประดิษฐ์ แขวงคลองจั่น  
เขตยานนาวา กรุงเทพมหานคร 10120

REV. MARK	REVISION	DATE	APPR.	APPROVAL
△	-	-	-	ISSUED FOR CONSTRUCTION
	-	-	-	DATE -
	-	-	-	APPROVED -
	-	-	-	ORDER NO. -
	-	-	-	CONTRACTOR -
△	AS-BUILT	18/08/60	-	CONTRACT DATE -
ESB ONE				ESB ONE CO.,LTD
PROJECT				75 White Group Tower 2, 11 <sup>th</sup> Fl., Soi Rubin, Sukhumvit 42, Prakanong, Khlongtoey, Bangkok, Thailand
CLIENTS ADDRESS				LCH - PROJECT 1
DRAWING TITLE				TYPICAL 3rd FLOOR FRAMING PLAN
SCALE				1:100
DRAWING NO.				LCHI-T1-S1-203-1
REV.				0

 <b>TESCO LTD. CONSULTING ENGINEERS</b> 21/11-14 SOI SUKHUMVIT 18 , BANGKOK 10110 TEL. 258-6573 (10 LINES AUTOMATIC) FAX 258-1313								1711/11-14 (สำหรับงานวิศวกรรม) 537/102 ถนนสาธุประดิษฐ์ แขวงคลองจั่น เขตบางนา กรุงเทพฯ 10120		REV. MARK 1 2 3 773 
--	--	--	--	--	--	--	---	--	--	---

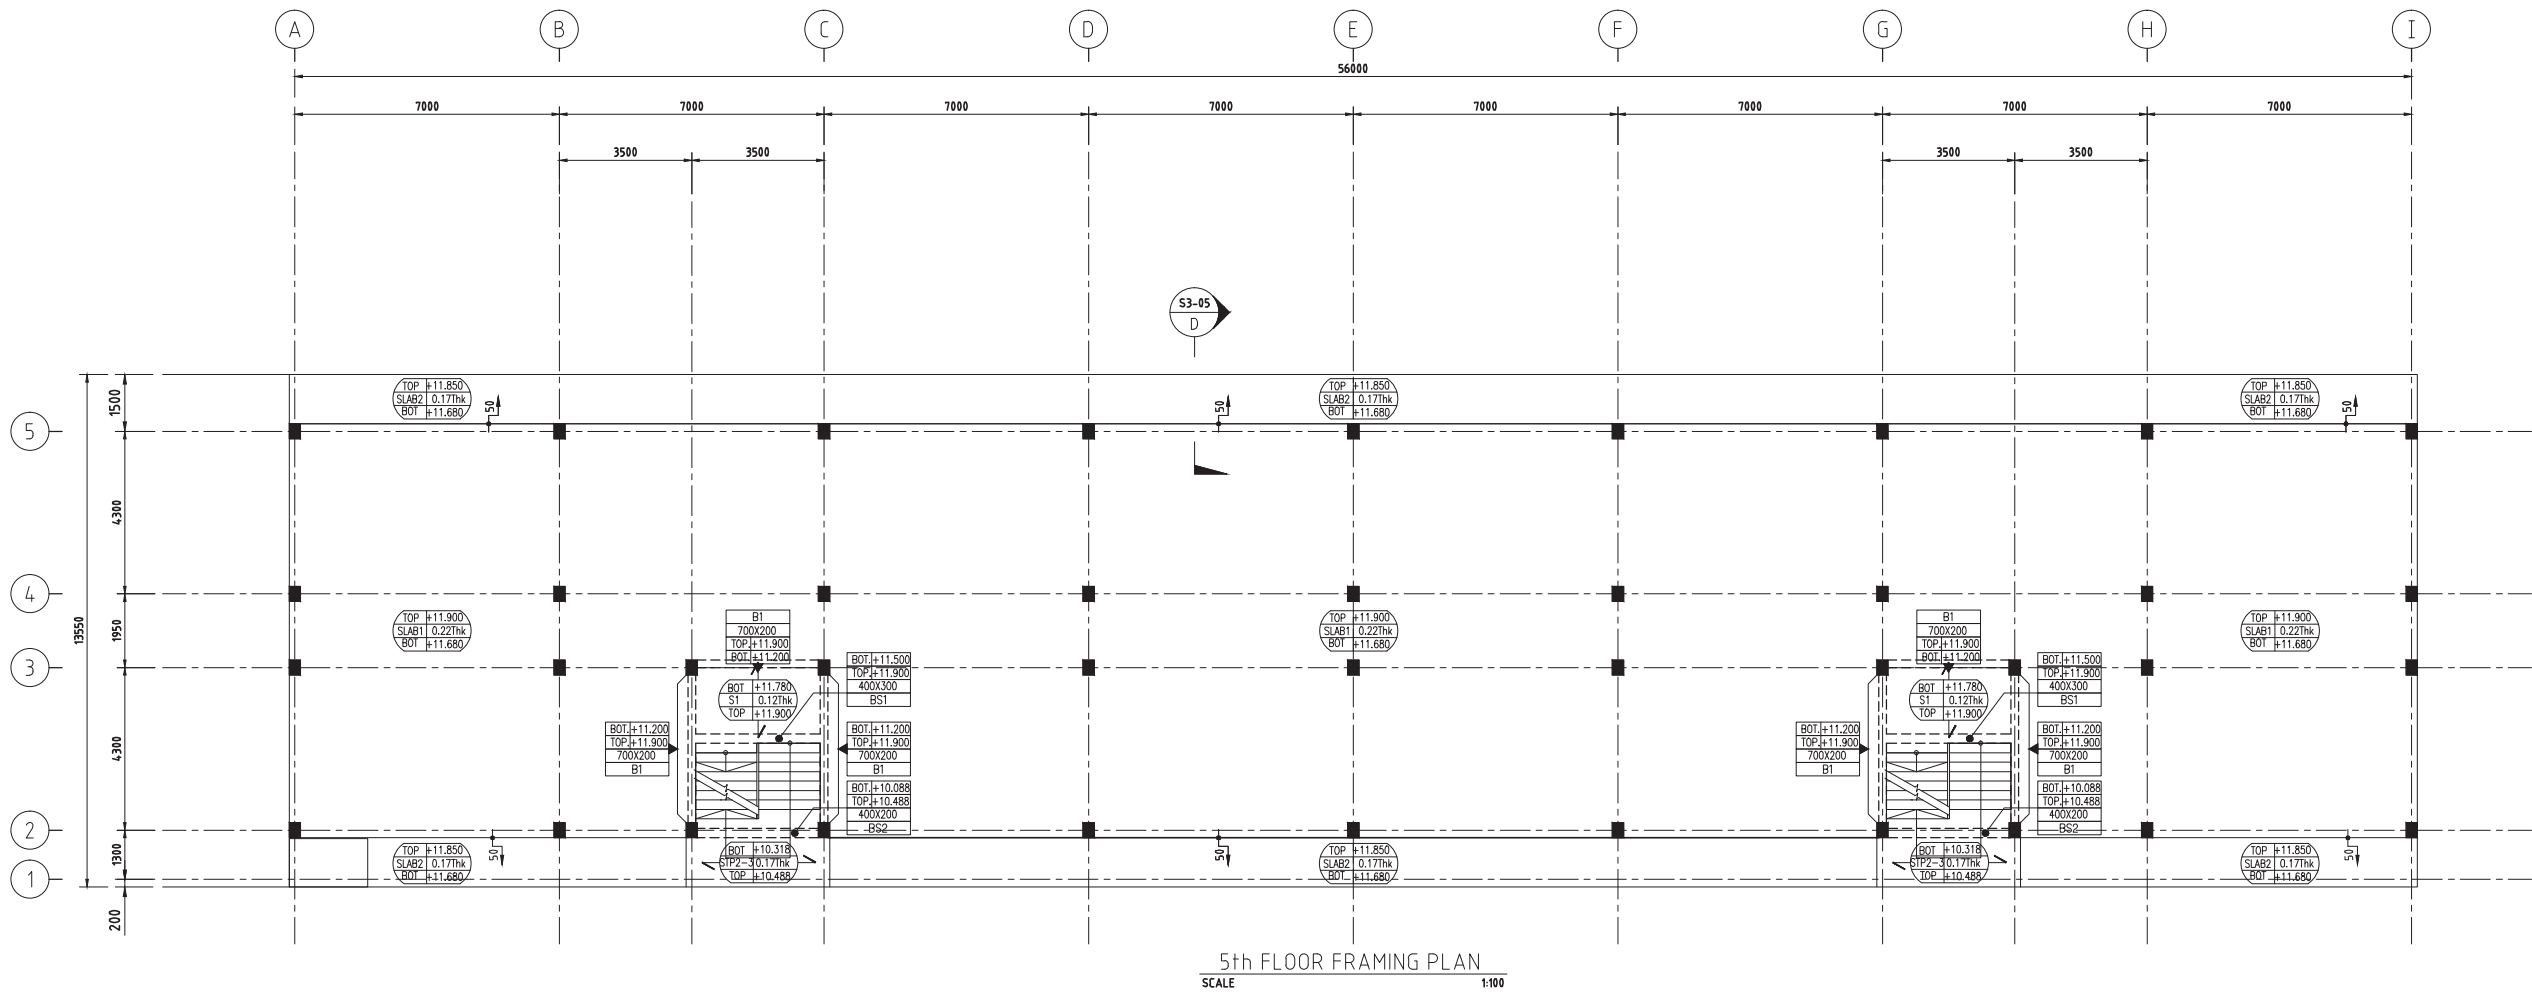
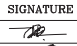
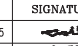








ALLOWABLE SUPERIMPOSED LOAD (Kg/m<sup>2</sup>)

FUNCTION AREA	DEAD LOAD		LIVE LOAD
CORRIDOR / STAIR	- FLOOR FINISHING	70	300
	- SERVICES + CEILING	20	
ROOM	- FLOOR FINISHING	70	200
	- SERVICES + CEILING	20	
	- WALL PARTITIONS	110	

NOTES :

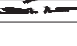- ALL SYMBOLS AND ABBREVIATIONS REPRESENT ;
  - DENOTES SLAB THICKNESS (mm).
  - DENOTES COLUMN ABOVE ONLY.
  - DENOTES COLUMN BELOW ONLY.
  - DENOTES DIFFERENT SLAB LEVEL (STEP).
- FOR SLAB REINFORCEMENT ;  
REFER TO DRAWING NO. S3-01 TO S3-05
- ALL BEAM SIZE ARE TO BE ;  
REFER TO DRAWING NO. S4-01
- ALL COLUMN SIZES ARE TO BE ;  
REFER TO DRAWING NO. S5-01
- FOR SLAB FINISHING DETAIL, FINISHED LEVEL AND STRUCTURAL SLAB LEVEL,  
REFER TO ARCHITECTURAL DRAWING
- ALL TYPICAL DETAILS APPLY


<div><div><div>TESCO LTD. CONSULTING ENGINEERS</div><div>21/11-14 SOI SUKHUMVIT 18 , BANGKOK 10110</div><div>TEL. 259-8573 (10 LINES AUTOMATIC) FAX 258-1313</div></div></div>					
DESIGN	NAME	SIGNATURE	DESIGN	NAME	SIGNATURE
ARCHITECT	NARAET T. สรณ.1821		MECHANICAL ENGINEER	POTE L. สรณ.2055	
	PIYA S. สรณ.9661			WICHAN T. สรณ.14151	
STRUCTURAL ENGINEER	YUTTANA C. สรณ.6404		ELECTRICAL ENGINEER	TOSAPHON B. สรณ.2341	
CIVIL ENGINEER	PASIT T. สรณ.2706		SANITARY ENGINEER	PASIT T. สรณ.2706	
					DATE 17/11/2014



บริษัท เอสบีวัน จำกัด  
(สำนักงานใหญ่)  
537/102 ถนนสาธุประดิษฐ์ แขวงคลองจั่น  
เขตยานนาวา กรุงเทพมหานคร 10120

REV. MARK	REVISION	DATE	APPR.	APPROVAL		ESB ONE	ESB ONE CO.,LTD		
				ISSUED FOR			75 White Group Tower 2, 11 <sup>th</sup> Fl., Soi Rubin, Sukhumvit 42, Prakanong, Khlongtoey, Bangkok, Thailand	PROJECT	LCH - PROJECT 1
CONSTRUCTION						CLIENTS ADDRESS			
DATE				-			APPROVED		ORDER NO.
CONTRACTOR						CONTRACT DATE			
△	-	-	-						
△	-	-	-						
△	AS-BUILT	18/08/60	1						



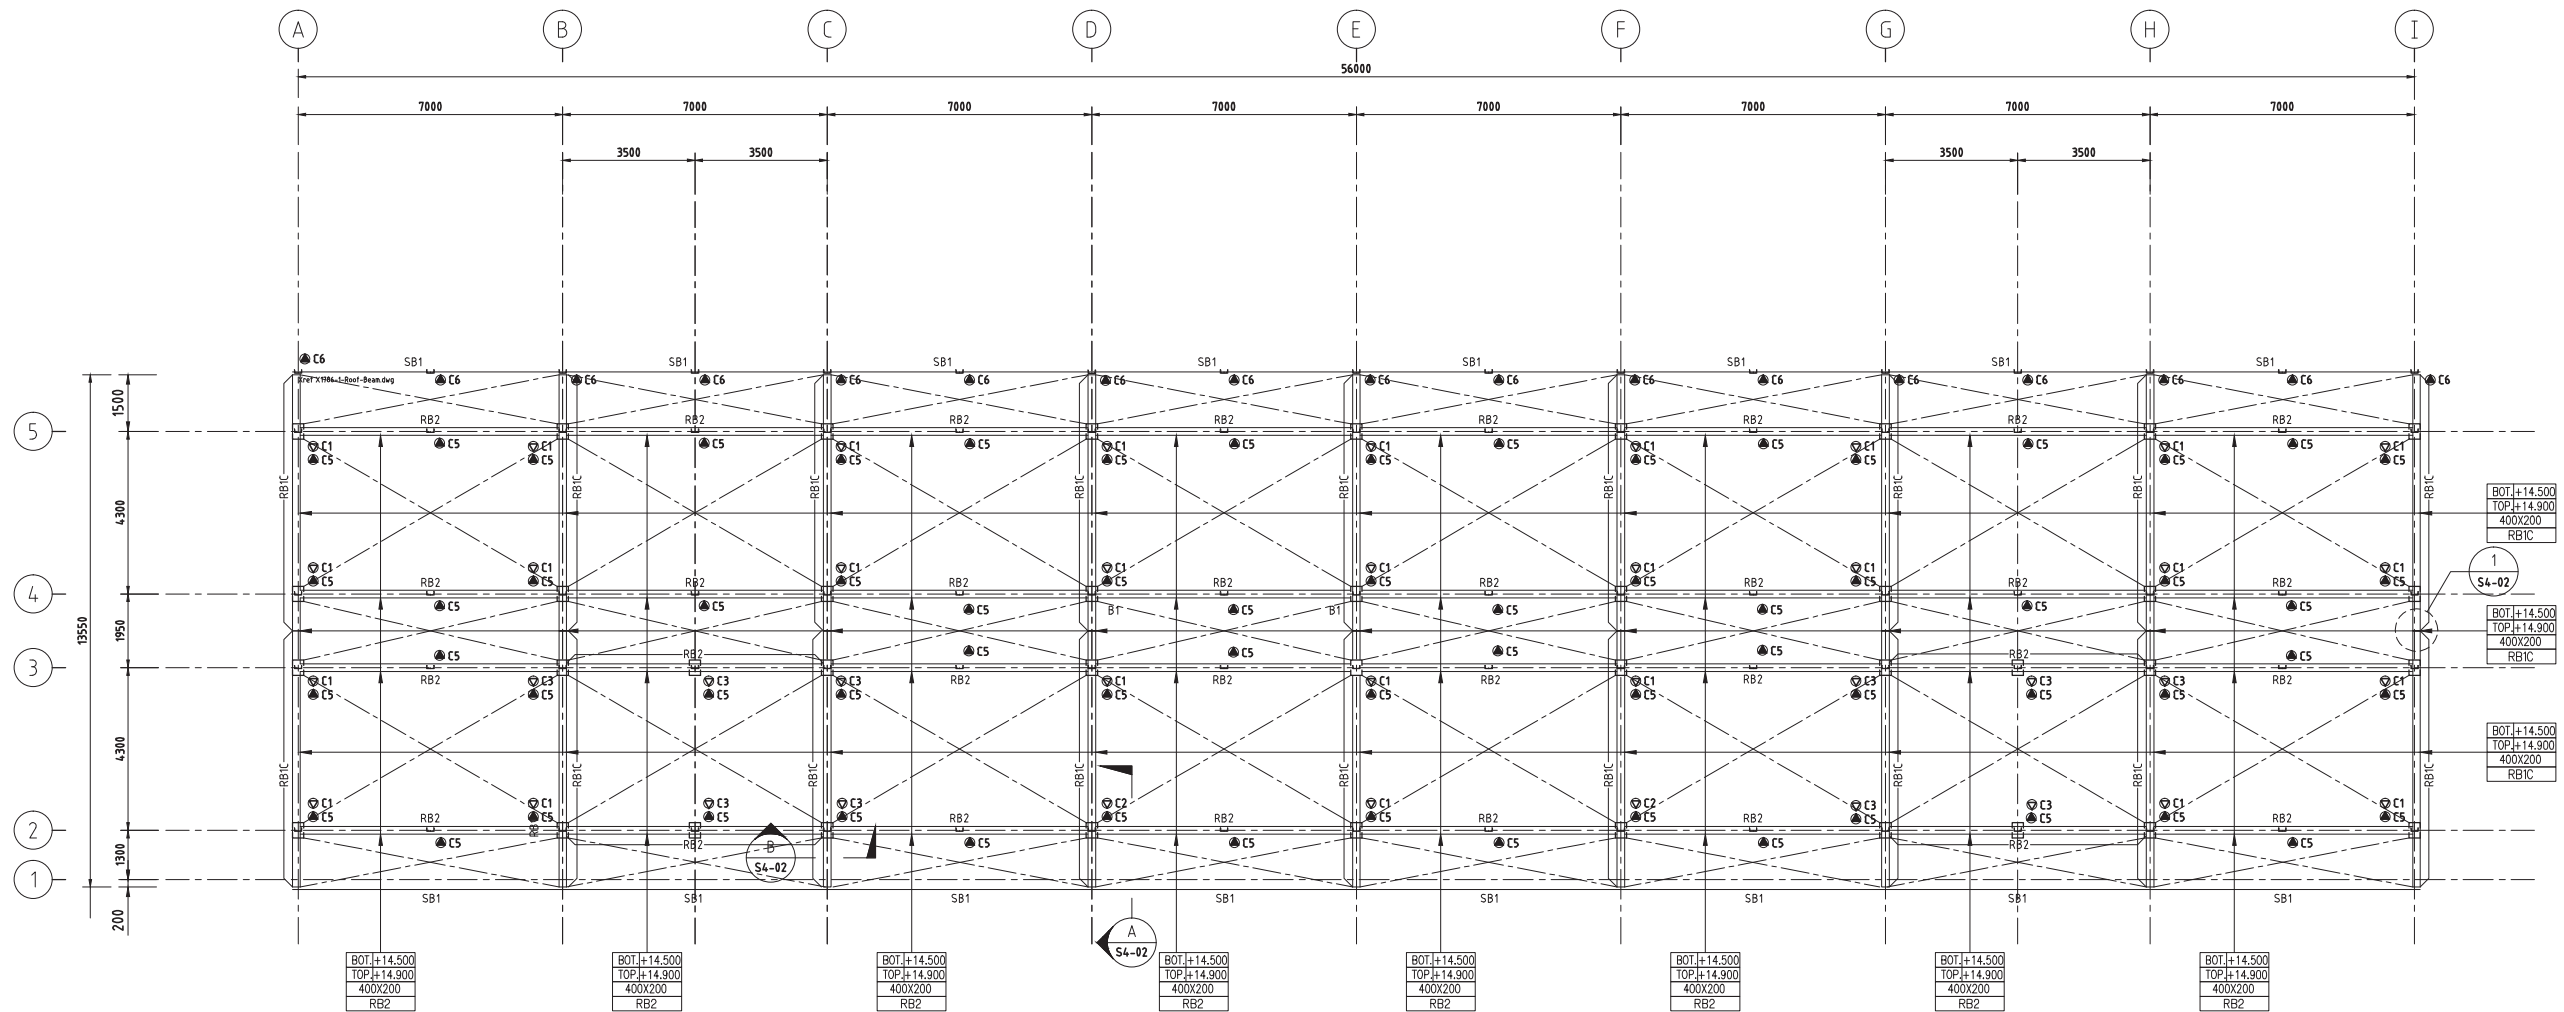

ALLOWABLE SUPERIMPOSED LOAD (Kg/m<sup>2</sup>)

FUNCTION AREA	DEAD LOAD		LIVE LOAD
ROOF	- SERVICES + CEILING	35	30
	- ROOFING + BUILD UP	15	

LOWER ROOF FRAMING PLAN

SCALE 1:100

NOTES :

- 1) ALL SYMBOLS AND ABBREVIATIONS REPRESENT ;
  - DENOTES COLUMN ABOVE ONLY.
  - ⊙ DENOTES COLUMN BELOW ONLY.
  - W (B) DENOTES WALL BELOW ONLY.
- 2) ALL BEAM SIZE ARE TO BE ;  
SB1= RHS 150x100x6mmx217 kg/m.  
REFER TO DRAWING NO. S4-01
- 3) ALL COLUMN SIZES ARE TO BE ;  
C5 = □ 100x100x3.2mm. (STEEL COLUMN)  
C6 = C 100x50x3.2mm. (STEEL SUPPORT)  
REFER TO DRAWING NO. S5-01
- 4) FOR SLAB FINISHING DETAIL, FINISHED LEVEL AND STRUCTURAL SLAB LEVEL,  
TO ARCHITECTURAL DRAWING
- 5) ALL TYPICAL DETAILS APPLY



TESCO LTD. CONSULTING ENGINEERS  
21/11-14 SOI SUKHUMVIT 18 , BANGKOK 10110  
TEL. 259-6573 (10 LINES AUTOMATIC) FAX 258-1313

DESIGN	NAME	SIGNATURE	DESIGN	NAME	SIGNATURE	DATE
ARCHITECT	NARAE T. สร.1821		MECHANICAL ENGINEER	POTE L. สร.2055		17/11/2014
	PIYA S. สร.19661			WICHAN T. สร.14151		
STRUCTURAL ENGINEER	YUTTANA C. สร.6404		ELECTRICAL ENGINEER	TOSAPHON B. สร.12341		
CIVIL ENGINEER	PASIT T. สร.2706		SANITARY ENGINEER	PASIT T. สร.2706		




บริษัท เอสบีวัน จำกัด  
(สำนักงานใหญ่)  
537/102 ถนนสาธุประดิษฐ์ แขวงคลองจั่น  
เขตยานนาวา กรุงเทพมหานคร 10120

REV.	REVISION		DATE	APPR.	APPROVAL		ESB ONE	ESB ONE CO.,LTD	
MARK					ISSUED FOR				
REV	ISSUED	DATE	APPROVED		CONSTRUCTION				75 White Group Tower 2, 11 <sup>th</sup> Fl., Soi Rubia, Sukhumvit 42, Prakanong, Khlongtoey, Bangkok, Thailand
REV	ISSUED	DATE	APPROVED	DATE	DATE			PROJECT	LCH – PROJECT 1
REV	ISSUED	DATE	APPROVED	APPROVED	APPROVED		CLIENTS ADDRESS	MAPYANGPHON PLUAK–DAENG RAYONG	SCALE
REV	ISSUED	DATE	APPROVED	ORDER NO.	ORDER		DRAWING TITLE	ARCHITECTURAL	SCALE
REV	ISSUED	DATE	APPROVED	CONTRACTOR	CONTRACTOR			TITLE	DRAWING NO.
REV	ISSUED	DATE	APPROVED	CONTRACT DATE	DATE			TITLE	DRAWING
REV	ISSUED	DATE	APPROVED						REV.





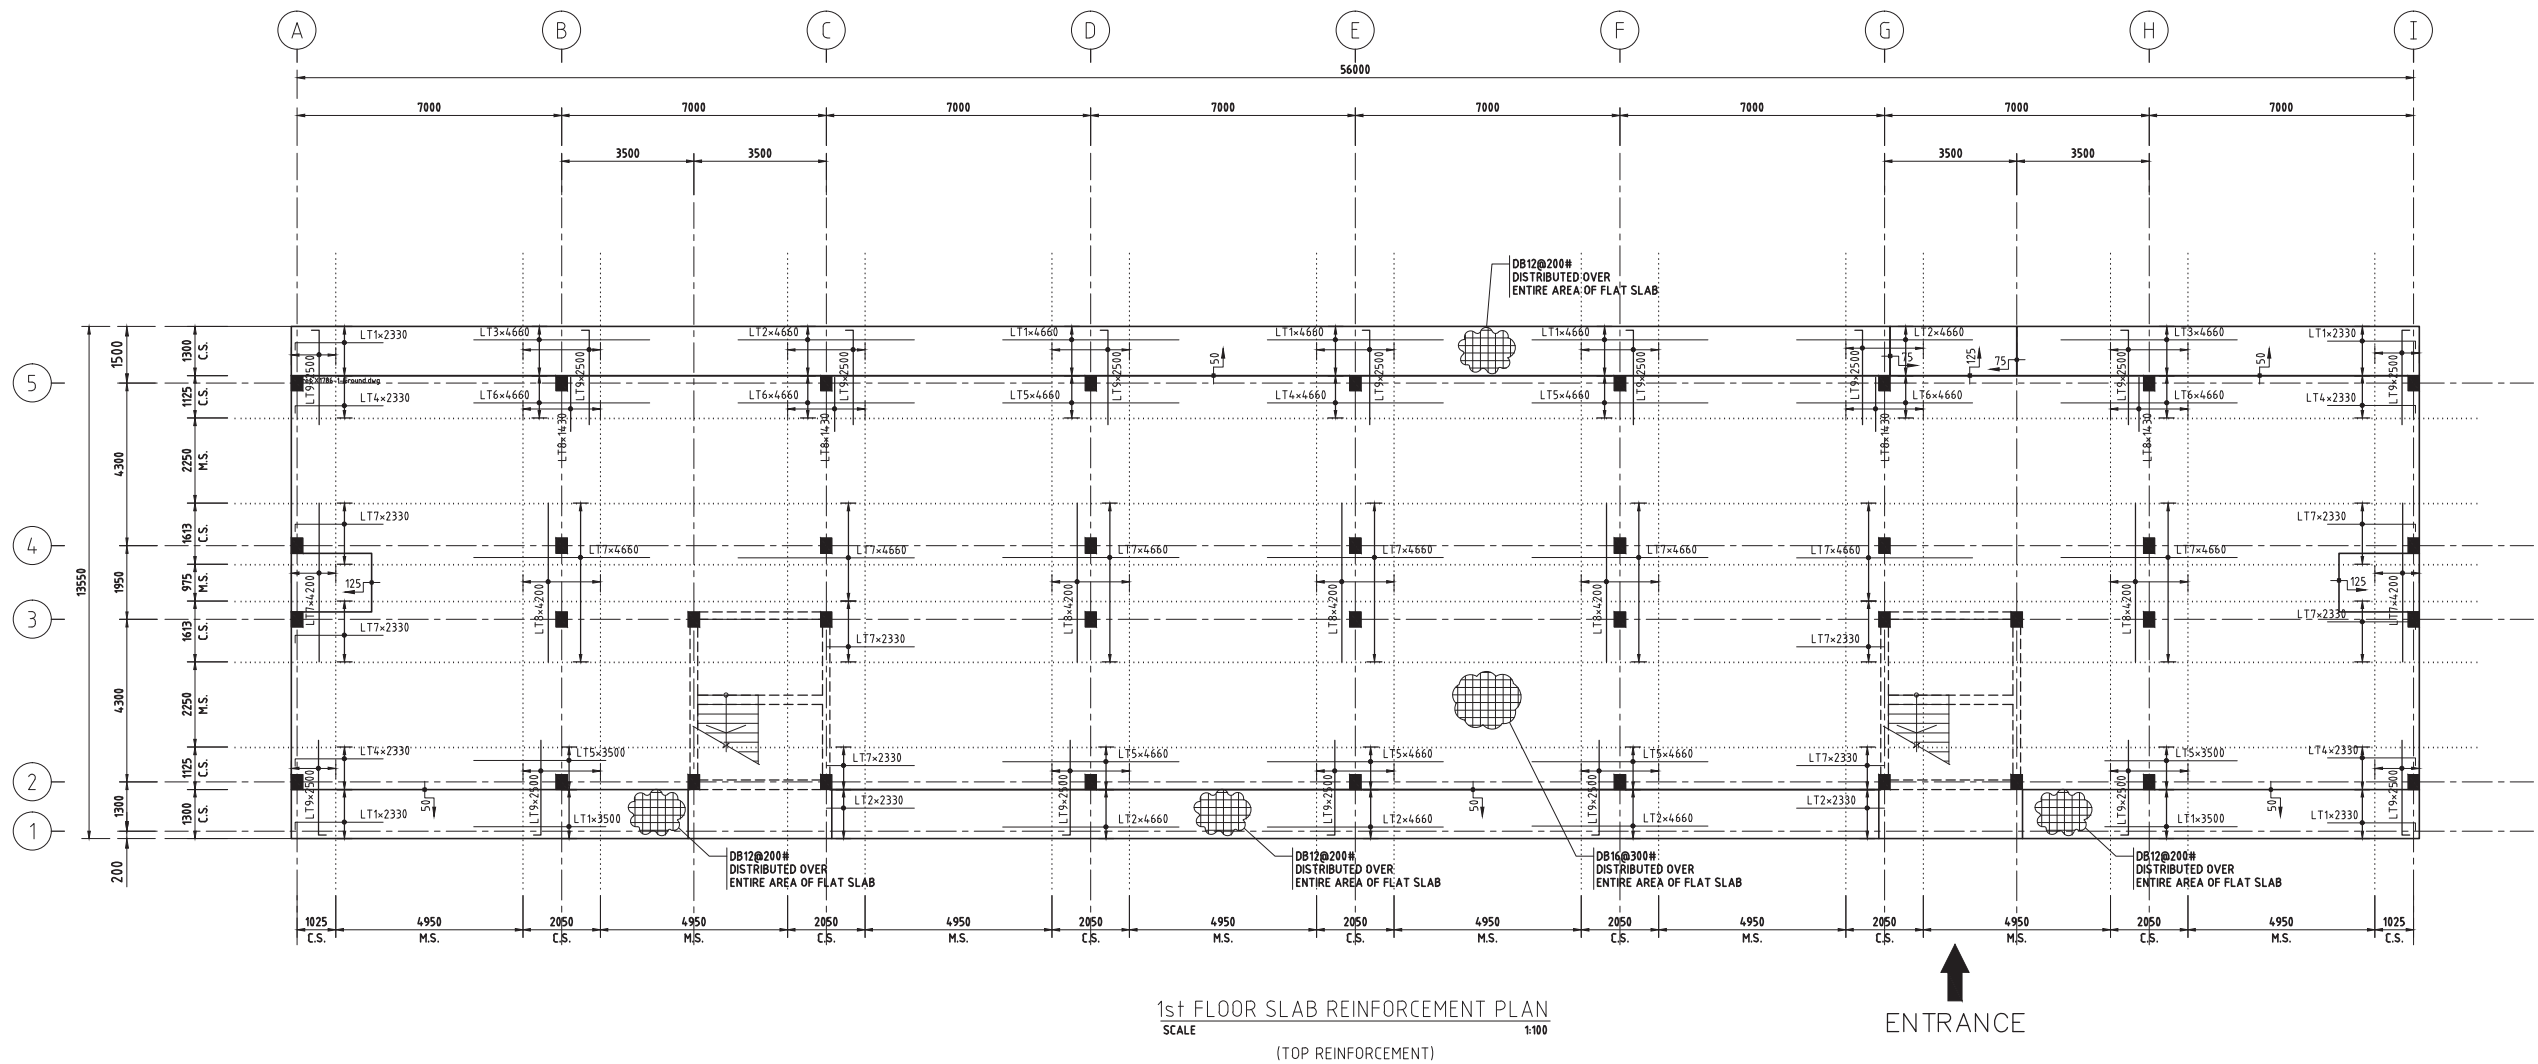


<div><div><div><div></div><div></div></div><div>TESCO LTD. CONSULTING ENGINEERS</div><div>21/11-14 SOI SUKHUMVIT 18 , BANGKOK 10110</div><div>TEL. 259-8573 (10 LINES AUTOMATIC) FAX 258-1313</div></div></div>					
DESIGN	NAME	SIGNATURE	DESIGN	NAME	SIGNATURE
ARCHITECT	NARAET T. <div>ชื่อ.1821</div>		MECHANICAL ENGINEER	POTE L. <div>ชื่อ.2055</div>	
	PIYA S. <div>ชื่อ.9661</div>			WICHAN T. <div>ชื่อ.14151</div>	
STRUCTURAL ENGINEER	YUTTANA C. <div>ชื่อ.6404</div>		ELECTRICAL ENGINEER	TOSAPHON B. <div>ชื่อ.2341</div>	
CIVIL ENGINEER	PASIT T. <div>ชื่อ.2706</div>		SANITARY ENGINEER	PASIT T. <div>ชื่อ.2706</div>	
DATE 17/11/2014					



บริษัท เอสบีวัน จำกัด  
(สำนักงานใหญ่)  
537/102 ถนนสาธุประดิษฐ์ แขวงคลองจั่น  
เขตยานนาวา กรุงเทพมหานคร 10120


REV. MARK	REVISION	DATE	APPR.	APPROVAL	
				ISSUED FOR	
△	-	-	-	CONSTRUCTION	
△	-	-	-	DATE	-
△	-	-	-	APPROVED	-
△	-	-	-	ORDER NO.	-
△	-	-	-	CONTRACTOR	-
△	-	-	-	CONTRACT DATE	-
△	AS-BUILT	18/08/60	-		



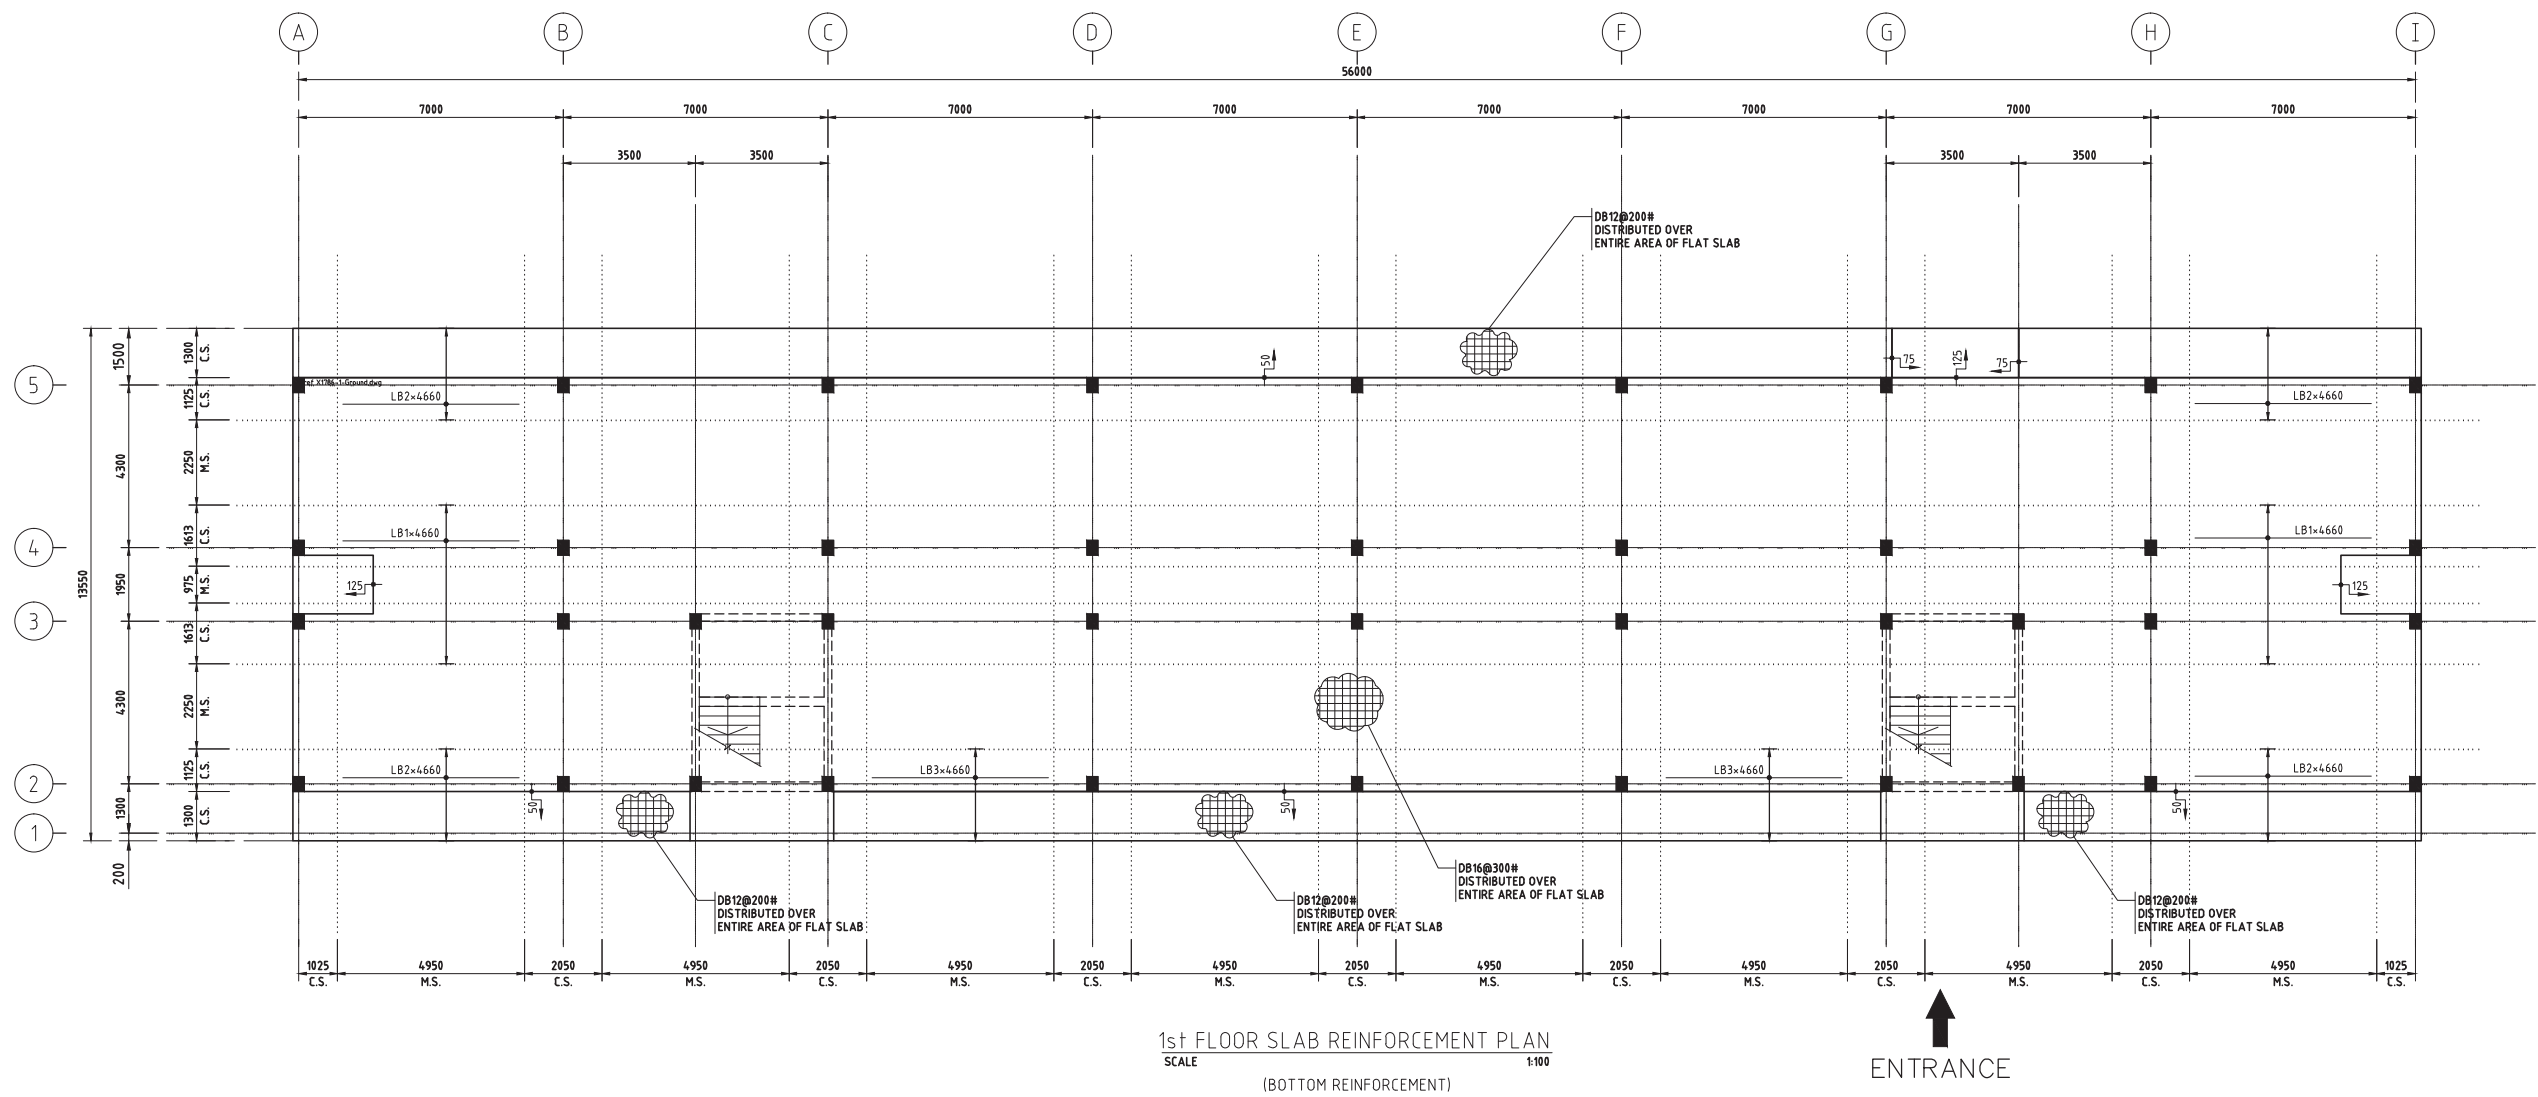



 


ESB ONE		ESB ONE CO.,LTD	
PROJECT		75 White Group Tower 2, 11 <sup>th</sup> Fl., Soi Rubin, Sukhumvit 42, Prakanong, Khlongtoey, Bangkok, Thailand	
CLIENTS ADDRESS		MAPYANGPHON PLUAK-DAENG RAYONG	
DRAWING TITLE		1st FLOOR SLAB REINFORCEMENT PLAN (TOP REINFORCEMENT)	
SCALE		A1=1:100, A3=1:200	
DRAWING NO.		LCH1-T1-ST-301	
REV.		0	

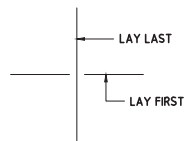

- NOTES :
- 1) ALL SYMBOLS AND ABBREVIATIONS REPRESENT :  
DENOTES DIFFERENT SLAB LEVEL (STEP).
  - 2) C.S. DENOTES COLUMN STRIP EXTENT.  
M.S. DENOTES MIDDLE STRIP EXTENT.
  - 3) ALL BAR LAPPING TO BE F.T.L TYP., UNO.
  - 4) AT SLAB EDGE TO BEAM LOCATION, THE SLAB'S REINFORCEMENT TO BE HOOKED INTO THE BEAM WITH A MINIMUM LENGTH OF S.H.A.
  - 5) AT SLAB EDGE TO WALL LOCATION, THE SLAB'S REINFORCEMENT TO BE HOOKED INTO THE WALL WITH A MINIMUM LENGTH OF F.T.A.
  - 6) FOR REINFORCEMENTS WHICH RUN PASS THROUGH OPENING, SEE TYPICAL REINFORCING AT SLAB OPENING.
  - 7) UNLESS NOTED OTHERWISE, REINFORCEMENT IN SLAB TO MEET REQUIREMENTS FOR MINIMUM REINFORCEMENT IN TWO-WAY SPANNING SLABS CLAUSE 7.12.2.1(B) ACI 318 AT ALL LOCATIONS.
  - 8) ALL TYPICAL DETAILS APPLY

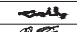ADDITIONAL REINFORCEMENT SCHEDULE	
MARK	REINFORCEMENT
LB1	DB16@400
LB2	DB16@300
LB3	DB12@400




 <b>TESCO LTD. CONSULTING ENGINEERS</b> 21/11-14 SOI SUKHUMVIT 18 , BANGKOK 10110 TEL. 258-8573 (10 LINES AUTOMATIC) FAX 258-1313					
DESIGN	NAME	SIGNATURE	DESIGN	NAME	SIGNATURE
ARCHITECT	NARAE T. สร.1821		MECHANICAL ENGINEER	POTE L. สร.2055	
	PIYA S. สร.19661			WICHAN T. สร.14151	
STRUCTURAL ENGINEER	YUTTANA C. สร.6404		ELECTRICAL ENGINEER	TOSAPHON B. สร.12341	
CIVIL ENGINEER	PASIT T. สร.2706		SANITARY ENGINEER	PASIT T. สร.2706	
					DATE 17/11/2014



บริษัท เอสบีวัน จำกัด  
(สำนักงานใหญ่)  
537/102 ถนนสาธุประดิษฐ์ แขวงคลองจั่น  
เขตยานนาวา กรุงเทพมหานคร 10120

REV. MARK	REVISION	DATE	APPR.	APPROVAL	
				ISSUED FOR	CONSTRUCTION
1	-	-	-	DATE	-
2	-	-	-	APPROVED	-
3	-	-	-	ORDER NO.	-
4	-	-	-	CONTRACTOR	-
5	-	-	-	CONTRACT DATE	-
6	AS-BUILT	18/08/60	-		


ESB ONE		ESB ONE CO.,LTD	
PROJECT		75 White Group Tower 2, 11 <sup>th</sup> Fl., Soi Rubin, Sukhumvit 42, Prakanong, Khlongtoey, Bangkok, Thailand	
CLIENTS ADDRESS		MAPYANGPHON PLUAK-DAENG RAYONG	
DRAWING TITLE		1st FLOOR SLAB REINFORCEMENT PLAN (BOTTOM REINFORMENT)	
SCALE		A1=1:100, A3=1:200	
DRAWING NO.		LCH1-T1-ST-302	
REV.		0	

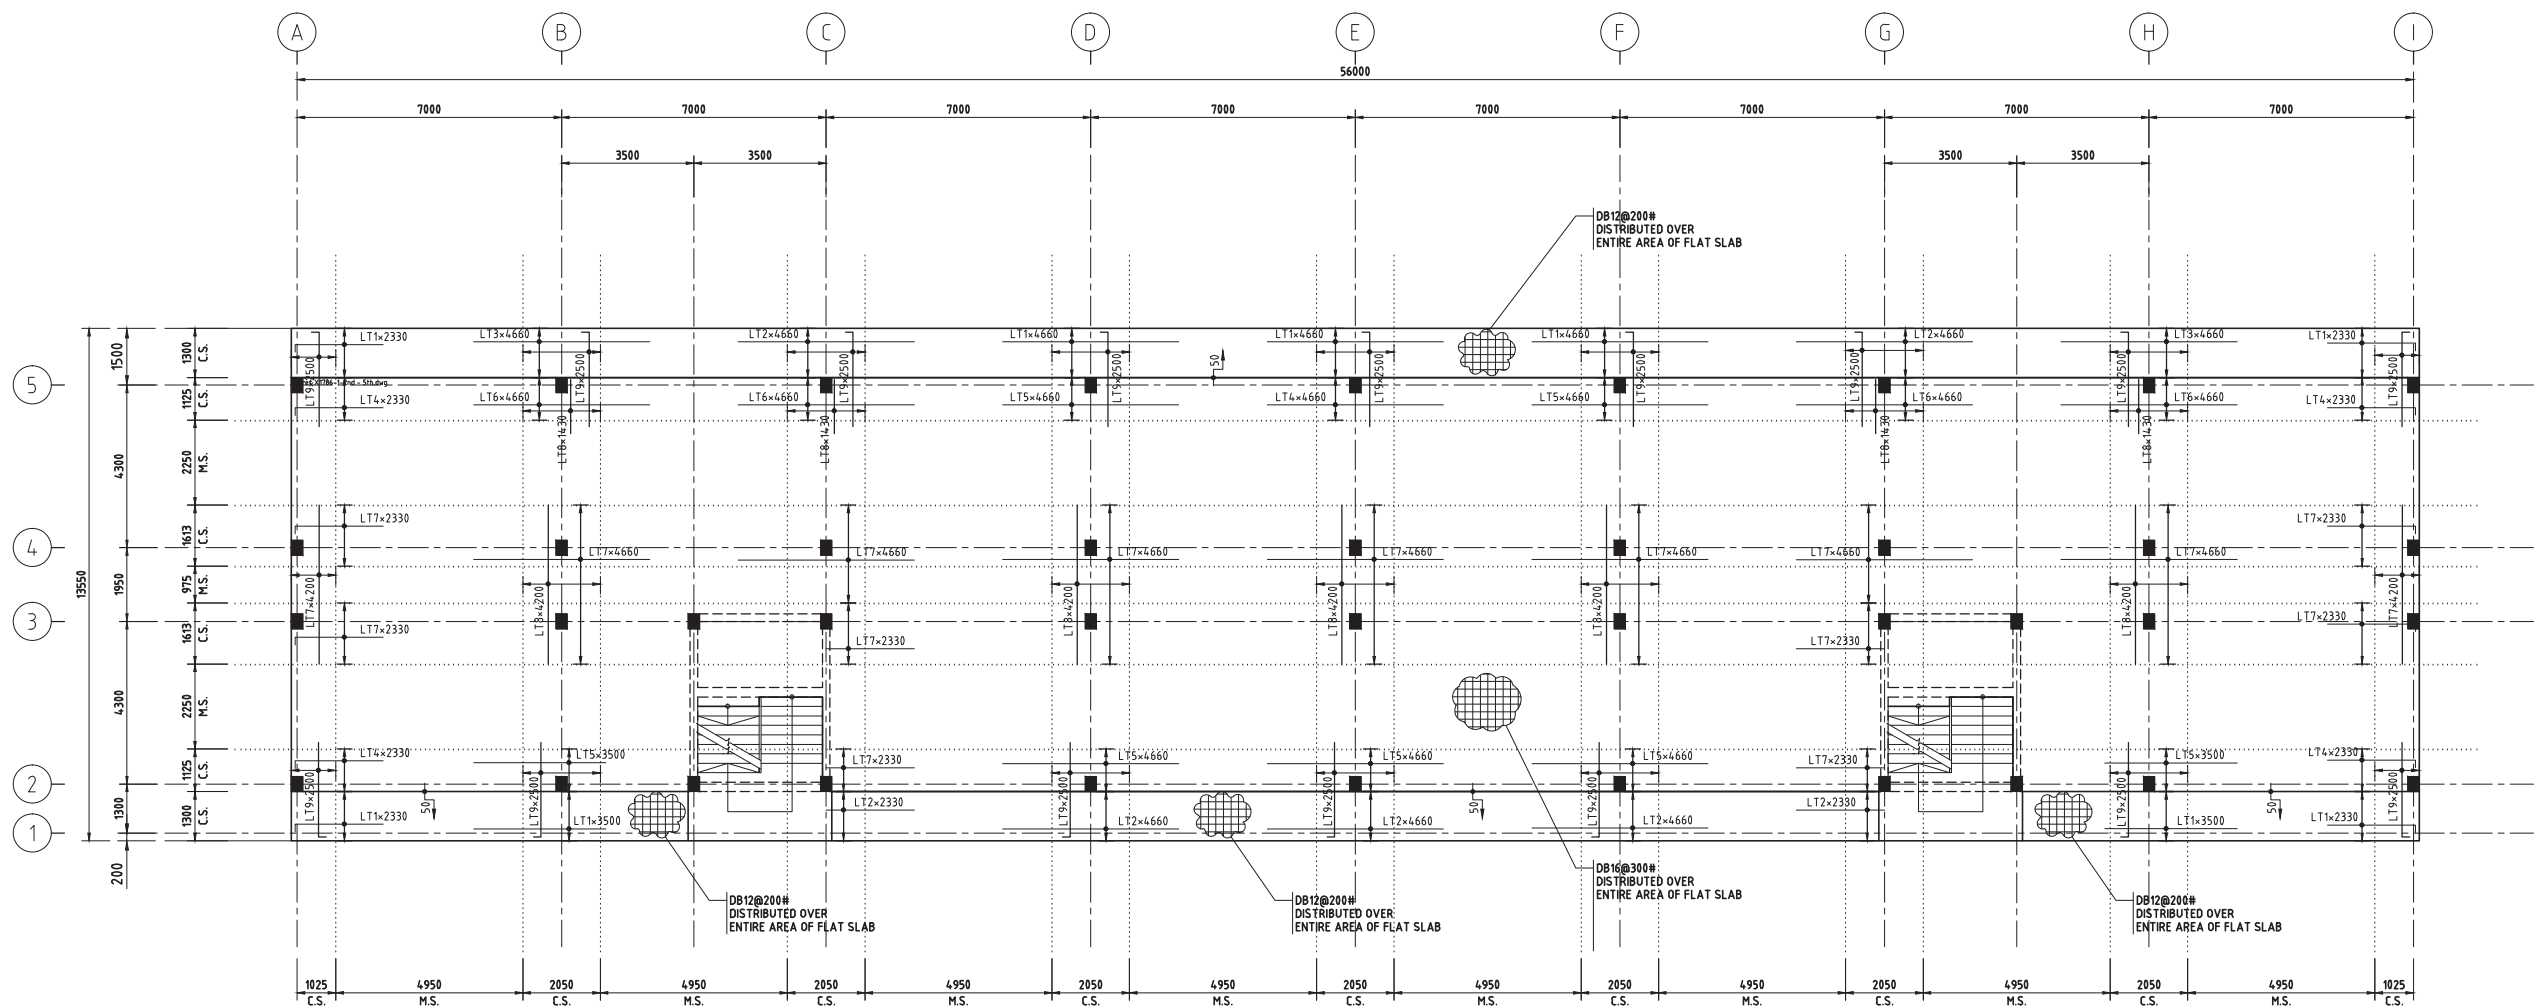

2nd-5thFLOOR SLAB REINFORCEMENT PLAN  
SCALE 1:100  
(TOP REINFORCEMENT)

- NOTES :
- 1) ALL SYMBOLS AND ABBREVIATIONS REPRESENT ;  
└─┬─┘ DENOTES DIFFERENT SLAB LEVEL (STEP).
  - 2) C.S. DENOTES COLUMN STRIP EXTENT.  
M.S. DENOTES MIDDLE STRIP EXTENT.
  - 3) ALL BAR LAPPING TO BE F.T.L TYP., UNO.
  - 4) AT SLAB EDGE TO BEAM LOCATION, THE SLAB'S REINFORCEMENT TO BE HOOKED INTO THE BEAM WITH A MINIMUM LENGTH OF S.H.A.
  - 5) AT SLAB EDGE TO WALL LOCATION, THE SLAB'S REINFORCEMENT TO BE HOOKED INTO THE WALL WITH A MINIMUM LENGTH OF F.T.A.
  - 6) FOR REINFORCEMENTS WHICH RUN PASS THROUGH OPENING, SEE TYPICAL REINFORCING AT SLAB OPENING.
  - 7) UNLESS NOTED OTHERWISE, REINFORCEMENT IN SLAB TO MEET REQUIREMENTS FOR MINIMUM REINFORCEMENT IN TWO-WAY SPANNING SLABS CLAUSE 7.12.2.1(B) ACI 318 AT ALL LOCATIONS.
  - 8) ALL TYPICAL DETAILS APPLY

ADDITIONAL REINFORCEMENT SCHEDULE	
MARK	REINFORCEMENT
LT1	DB12@300
LT2	DB12@250
LT3	DB12@150
LT4	DB16@250
LT5	DB16@150
LT6	DB16@125
LT7	DB16@300
LT8	DB16@400
LT9	DB12@300

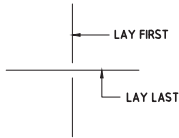


TESCO LTD. CONSULTING ENGINEERS					
21/11-14 SOI SUKHUMVIT 18 , BANGKOK 10110					
TEL. 259-8573 (10 LINES AUTOMATIC) FAX 258-1313					
DESIGN	NAME	SIGNATURE	DESIGN	NAME	SIGNATURE
ARCHITECT	NARAE T. สร.1821		MECHANICAL ENGINEER	POTE L. สร.2055	
	PIYA S. สร.19661			WICHAN T. สร.14151	
STRUCTURAL ENGINEER	YUTTANA C. สร.6404		ELECTRICAL ENGINEER	TOSAPHON B. สร.12341	
CIVIL ENGINEER	PASIT T. สร.2706		SANITARY ENGINEER	PASIT T. สร.2706	
DATE 17/11/2014					



บริษัท ทอส์ วิศวกรรม จำกัด  
(สำนักงานใหญ่)  
537/102 ถนนสาธุประดิษฐ์ แขวงคลองจั่น  
เขตยานนาวา กรุงเทพมหานคร 10120

REV. MARK	REVISION	DATE	APPR.	APPROVAL	
				ISSUED FOR	CONSTRUCTION
△	—	—	—	DATE	—
△	—	—	—	APPROVED	—
△	—	—	—	ORDER NO.	—
△	—	—	—	CONTRACTOR	—
△	—	—	—	CONTRACT DATE	—
△	AS-BUILT	18/08/60	—		

ESB ONE		ESB ONE CO.,LTD	
		75 White Group Tower 2, 11 <sup>th</sup> Fl., Soi Rubin, Sukhumvit 42, Prakanong, Khlongtoey, Bangkok, Thailand	
PROJECT		LCH - PROJECT 1	
CLIENTS ADDRESS		MAPYANGPHON PLUAK-DAENG RAYONG	
DRAWING TITLE		2nd-5th FLOOR SLAB REINFORCEMENT PLAN (TOP REINFORCEMENT)	
		SCALE	A1=1:100, A3=1:200
		DRAWING NO.	LCH1-T1-ST-303
		REV.	0

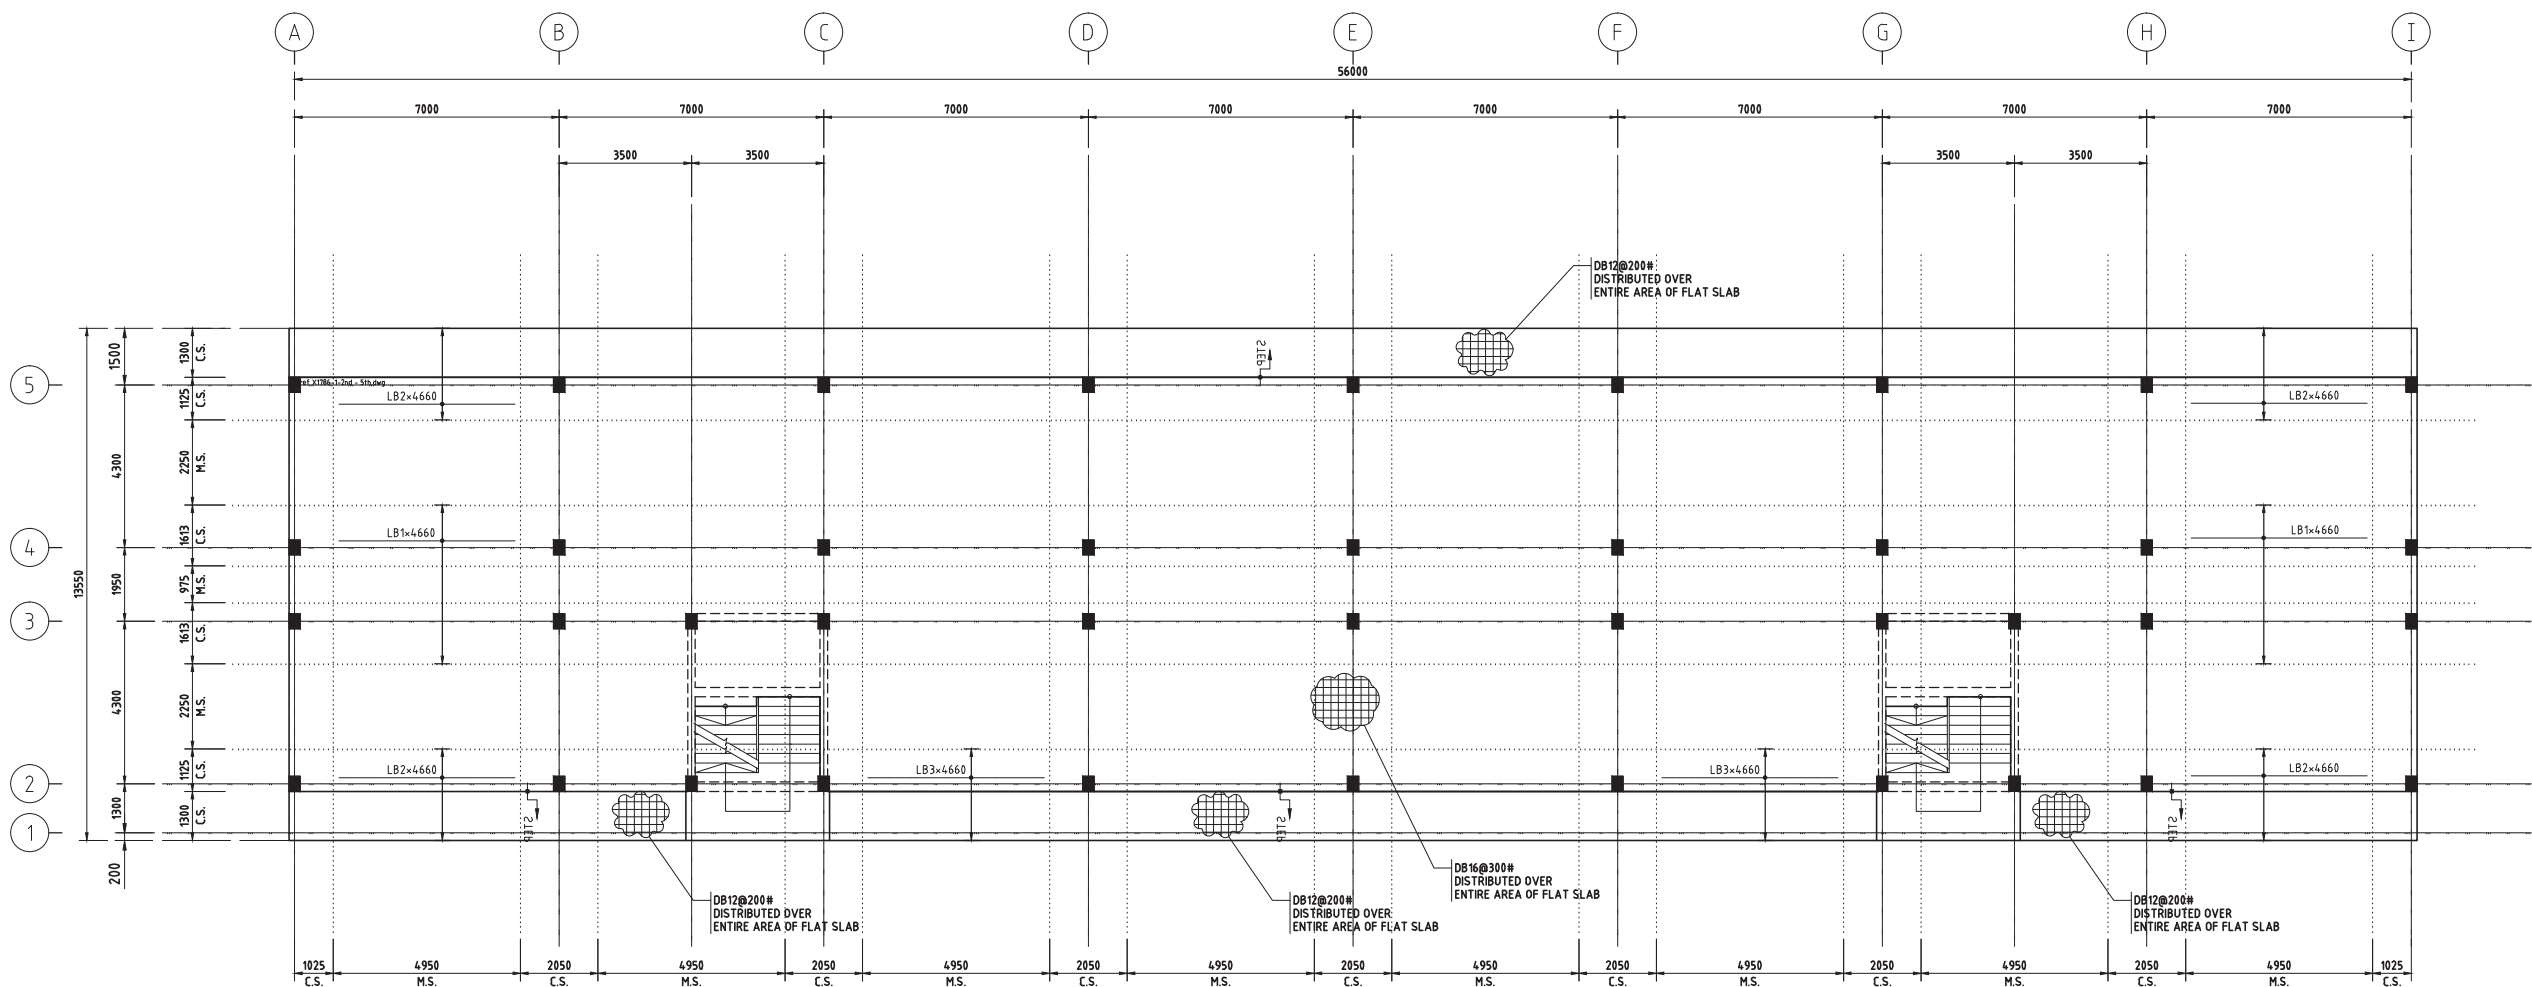


2nd-5th FLOOR SLAB REINFORCEMENT PLAN  
SCALE 1:100  
(BOTTOM REINFORCEMENT)

- NOTES :
- 1.) ALL SYMBOLS AND ABBREVIATIONS REPRESENT ;  
→ DENOTES DIFFERENT SLAB LEVEL (STEP).
  - 2.) C.S. DENOTES COLUMN STRIP EXTENT.  
M.S. DENOTES MIDDLE STRIP EXTENT.
  - 3.) ALL BAR LAPPING TO BE F.T.L TYP., UNO.
  - 4.) AT SLAB EDGE TO BEAM LOCATION, THE SLAB'S REINFORCEMENT TO BE HOOKED INTO THE BEAM WITH A MINIMUM LENGTH OF S.H.A.
  - 5.) AT SLAB EDGE TO WALL LOCATION, THE SLAB'S REINFORCEMENT TO BE HOOKED INTO THE WALL WITH A MINIMUM LENGTH OF F.T.A.
  - 6.) FOR REINFORCEMENTS WHICH RUN PASS THROUGH OPENING, SEE TYPICAL REINFORCING AT SLAB OPENING.
  - 7.) UNLESS NOTED OTHERWISE, REINFORCEMENT IN SLAB TO MEET REQUIREMENTS FOR MINIMUM REINFORCEMENT IN TWO-WAY SPANNING SLABS CLAUSE 7.12.2.1(B) ACI 318 AT ALL LOCATIONS.
  - 8.) ALL TYPICAL DETAILS APPLY

ADDITIONAL REINFORCEMENT SCHEDULE

MARK	REINFORCEMENT
LB1	DB16@400
LB2	DB16@300
LB3	DB12@400






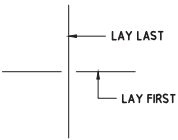








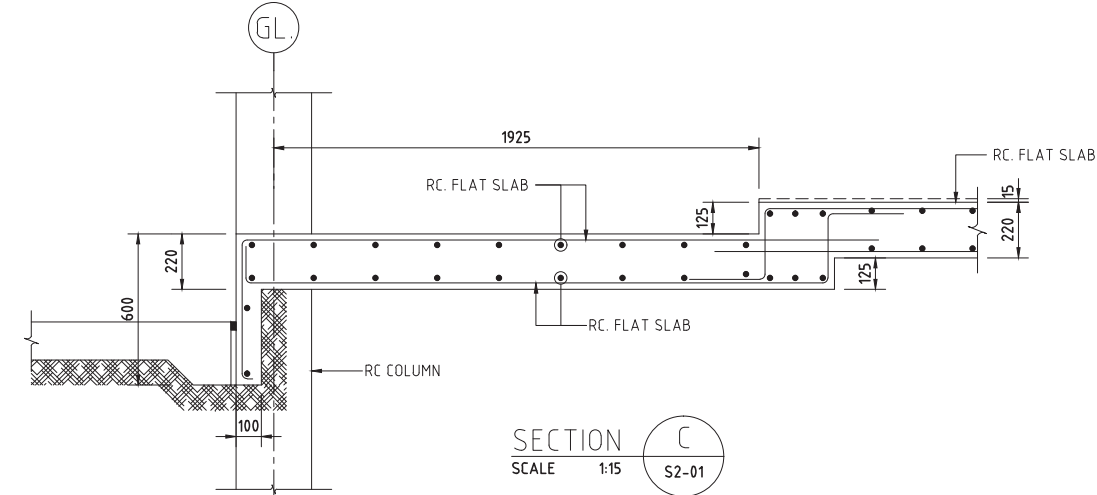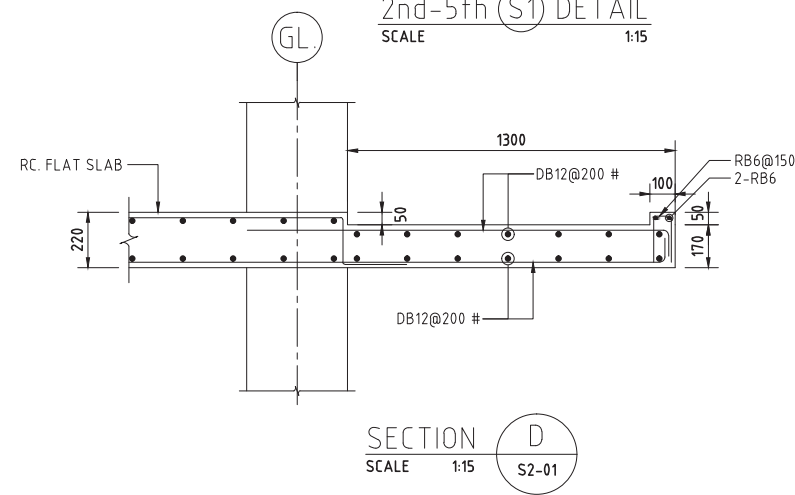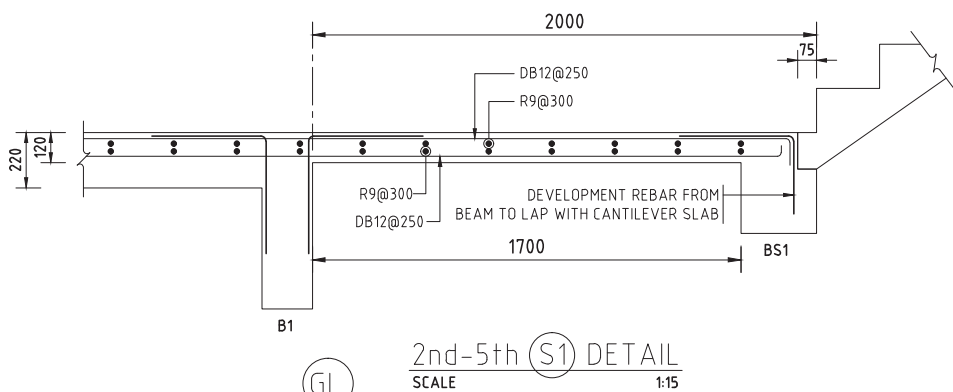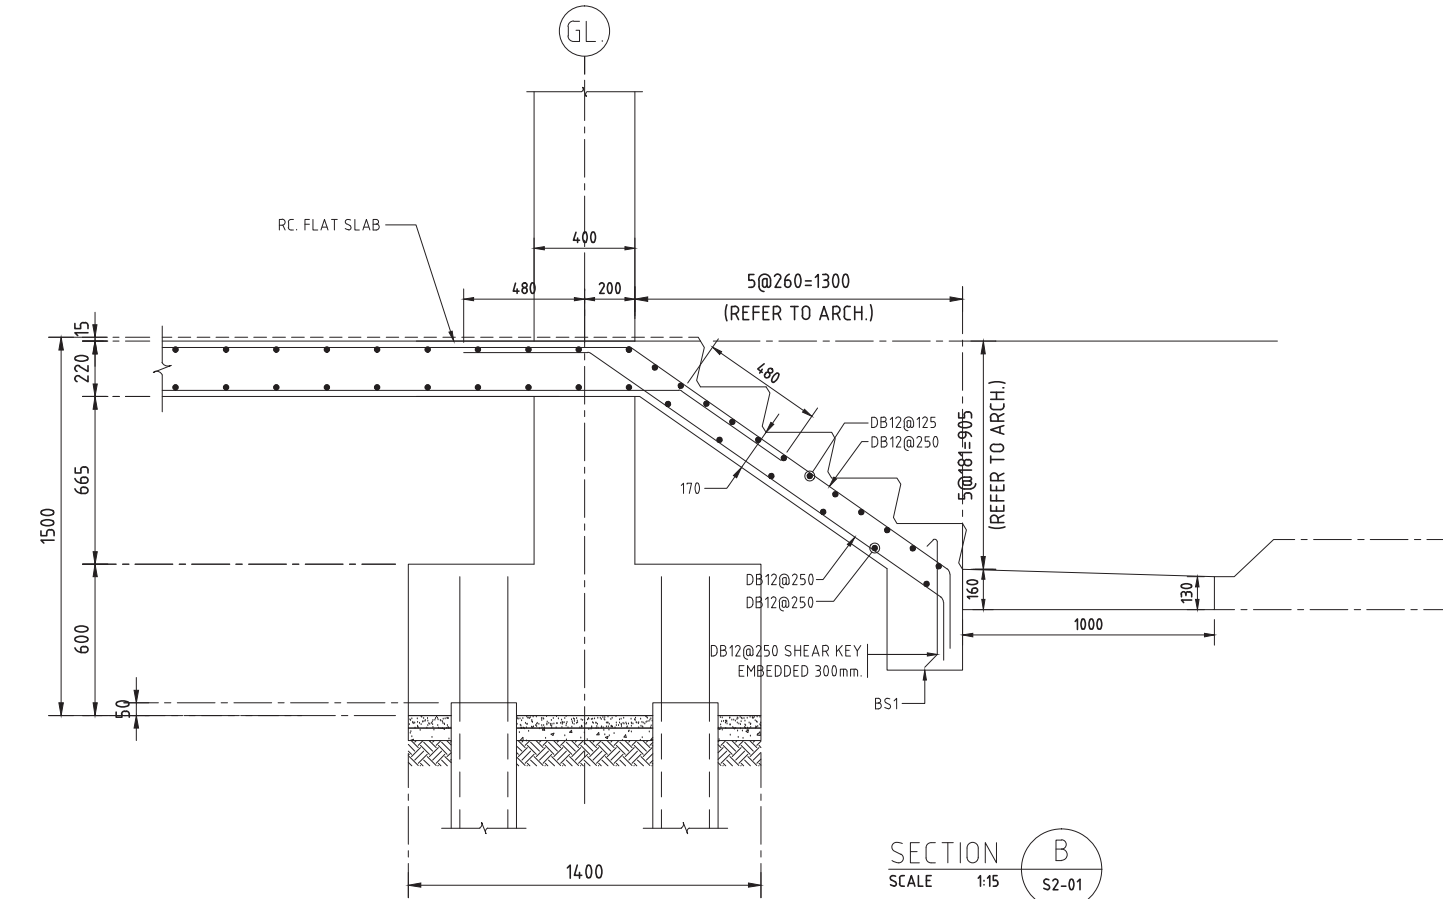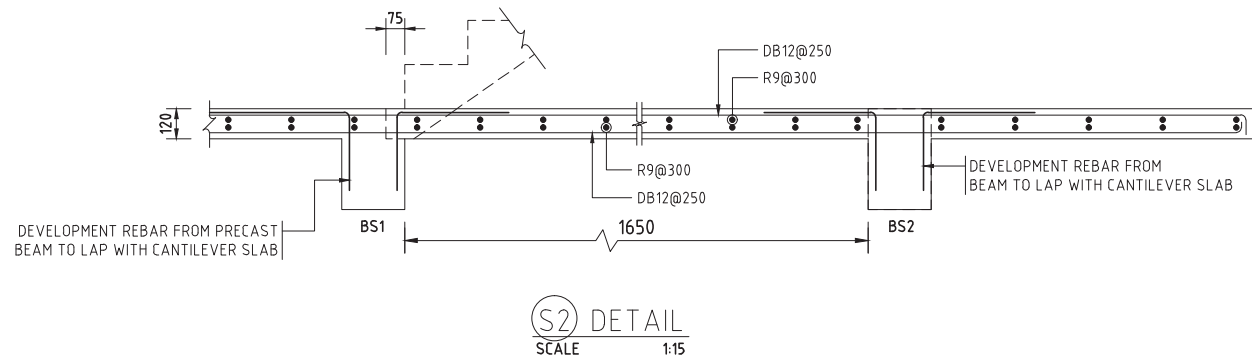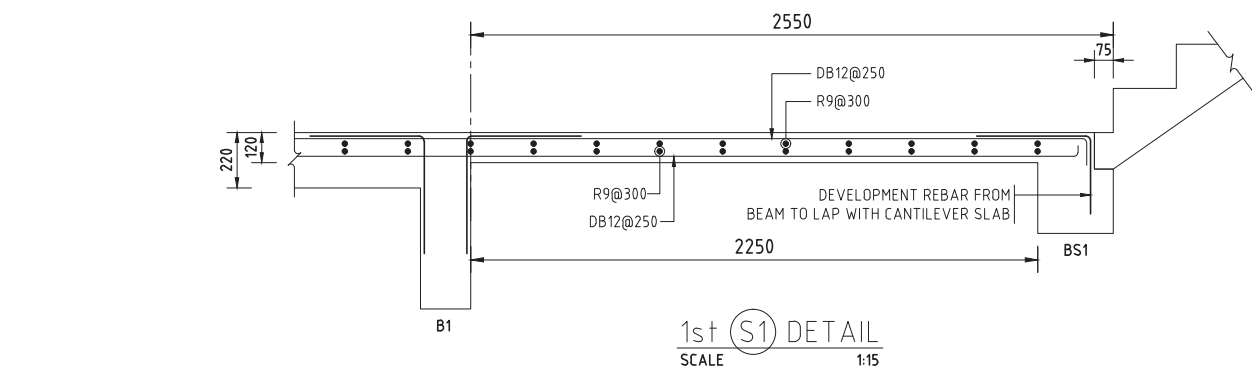


 TESCO LTD. CONSULTING ENGINEERS 21/11-14 SOI SUKHUMVIT 18 , BANGKOK 10110 TEL. 259-8573 (10 LINES AUTOMATIC) FAX 258-1313					
DESIGN	NAME	SIGNATURE	DESIGN	NAME	SIGNATURE
ARCHITECT	NARAE T. สร.1821		MECHANICAL ENGINEER	POTE L. สร.2055	
	PIYA S. สร.19661			WICHAN T. สร.14151	
STRUCTURAL ENGINEER	YUTTANA C. สร.6404		ELECTRICAL ENGINEER	TOSAPHON B. สร.12341	
CIVIL ENGINEER	PASIT T. สร.2706		SANITARY ENGINEER	PASIT T. สร.2706	
					DATE 17/11/2014



บริษัท เอสบี หนึ่ง จำกัด  
(สำนักงานใหญ่)  
537/102 ถนนสาธุประดิษฐ์ แขวงคลองจั่น  
เขตยานนาวา กรุงเทพมหานคร 10120

REV. MARK	REVISION	DATE	APPR.	APPROVAL	
△	-	-	-	ISSUED FOR	CONSTRUCTION
△	-	-	-	DATE	-
△	-	-	-	APPROVED	-
△	-	-	-	ORDER NO.	-
△	-	-	-	CONTRACTOR	-
△	AS-BUILT	18/08/60	-	CONTRACT DATE	-
				ESB ONE	ESB ONE CO.,LTD
				PROJECT	75 White Group Tower 2, 11 <sup>th</sup> Fl., Soi Rubin, Sukhumvit 42, Prakanong, Khlongtoey, Bangkok, Thailand
				CLIENTS ADDRESS	MAPYANGPHON PLUAK-DAENG RAYONG
				DRAWING TITLE	2nd-5th FLOOR SLAB REINFORCEMENT PLAN (BOTTOM REINFORMENT)
				SCALE	A1=1:100, A3=1:200
				DRAWING NO.	LCH1-T1-ST-304
				REV.	0




 <b>TESCO LTD. CONSULTING ENGINEERS</b> 21/11-14 SOI SUKHUMVIT 18, BANGKOK 10110 TEL. 259-8573 (10 LINES AUTOMATIC) FAX 258-1313					
DESIGN	NAME	SIGNATURE	DESIGN	NAME	SIGNATURE
ARCHITECT	NARAET T. ๙๙๑.1821		MECHANICAL ENGINEER	POTE L. ๙๙๑.2055	
	PIYA S. ๙๙๑.9661			WICHAN T. ๙๙๑.14151	
STRUCTURAL ENGINEER	YUTTANA C. ๙๙๑.6404		ELECTRICAL ENGINEER	TOSAPHON B. ๙๙๑.2341	
CIVIL ENGINEER	PASIT T. ๙๙๑.2706		SANITARY ENGINEER	PASIT T. ๙๙๑.2706	
		DATE			
		17/11/2014			





บริษัท เอสบีวัน จำกัด  
(สำนักงานใหญ่)  
537/102 ถนนสาธุประดิษฐ์ แขวงคลองจั่น  
เขตยานนาวา กรุงเทพมหานคร 10120









REV. MARK	REVISION	DATE	APPR.	APPROVAL		ESB ONE	ESB ONE CO.,LTD		
				ISSUED FOR			75 White Group Tower 2, 11 <sup>th</sup> Fl., Soi Rubin, Sukhumvit 42, Prakanong, Khlongtoey, Bangkok, Thailand		
△	-	-	-	CONSTRUCTION		PROJECT	LCH - PROJECT 1		
△	-	-	-	DATE		CLIENTS ADDRESS	MAPYANGPHON PLUAK-DAENG RAYONG		
△	-	-	-	APPROVED	-	DRAWING TITLE	SLAB & STAIR DETAILS SECTION BUILDING		
△	-	-	-	ORDER NO.	-				
△	-	-	-	CONTRACTOR	-				
△	-	-	-	CONTRACT DATE	-				
△	AS-BUILT	18/08/60	-				SCALE	A1=1:10, A3=1:20	
							DRAWING NO.	LCHI-T1-ST-305	
							REV.	0	

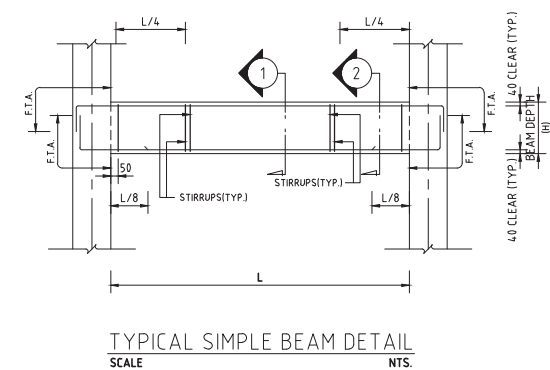







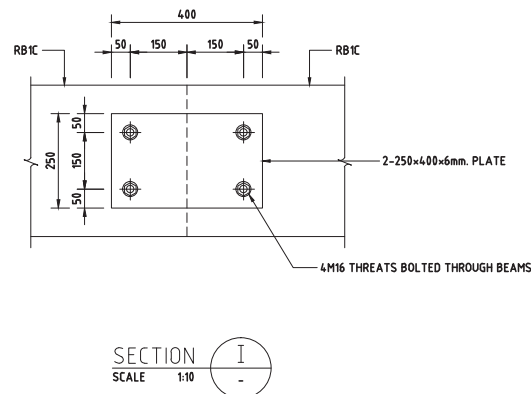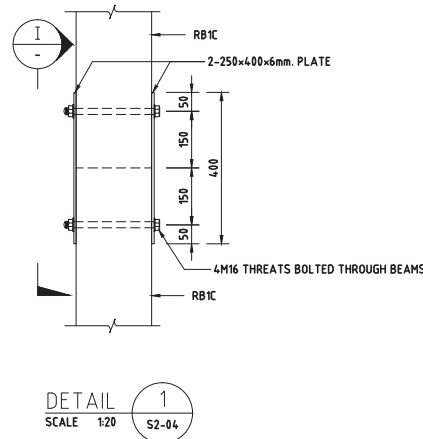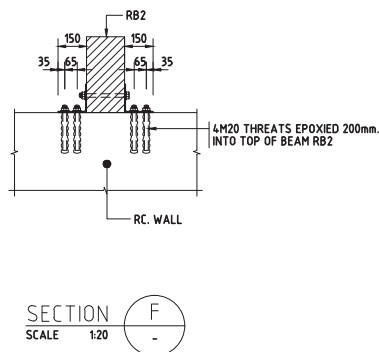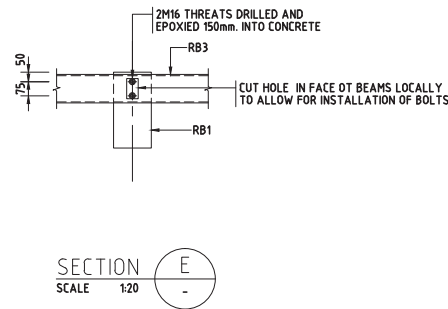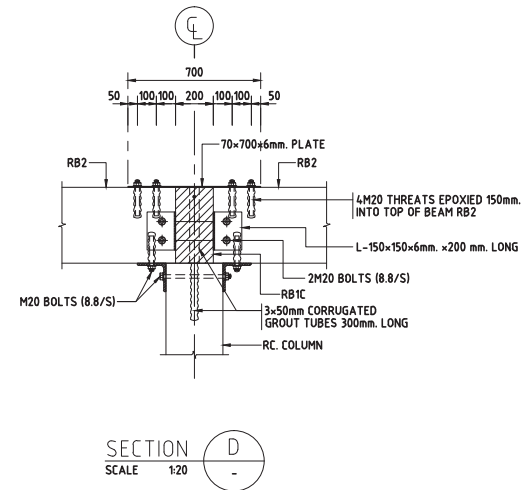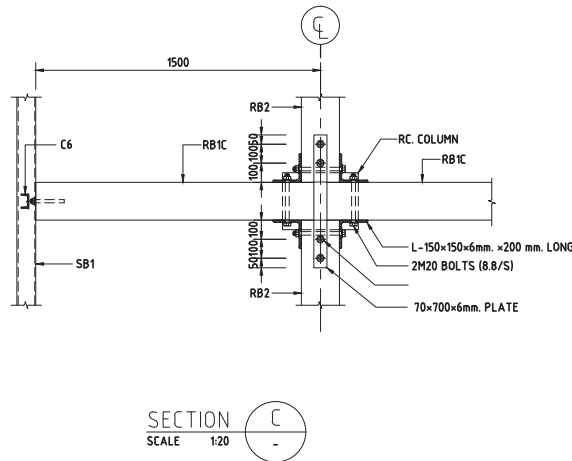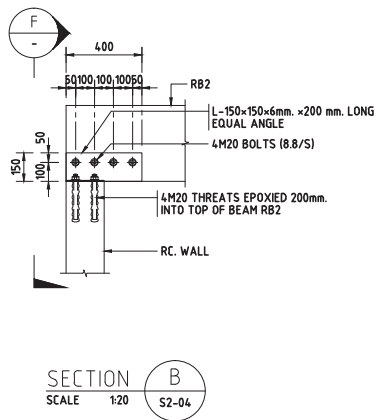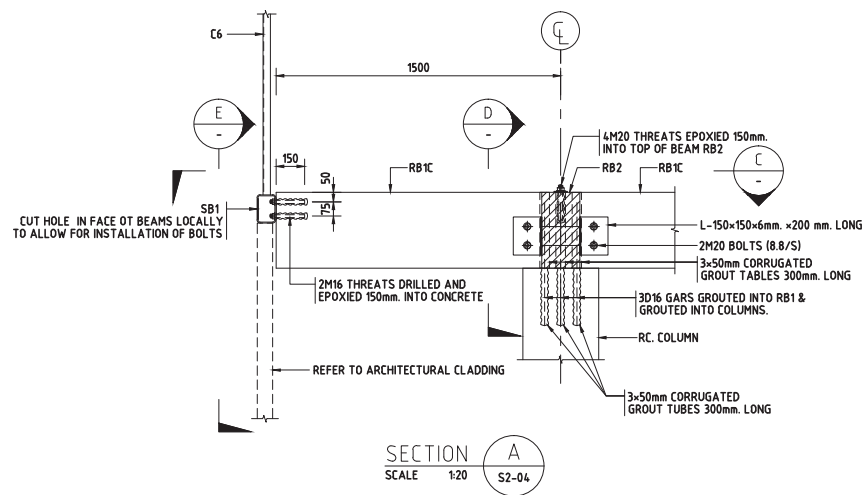




SECTION No. BEAM No.	SECTION 1	SECTION 2	SECTION 3	SECTION 4	REMARK
B1			_____	_____	SIMPLE BEAM
BS1			_____	_____	SIMPLE BEAM
BS2			_____	_____	SIMPLE BEAM
RB1C					PRECAST BEAM / CONTINUOUS BEAM / CANTILEVER BEAM
RB2				_____	PRECAST BEAM / CONTINUOUS BEAM

 <b>TESCO LTD. CONSULTING ENGINEERS</b> 21/11-14 SOI SUKHUMVIT 18 , BANGKOK 10110 TEL. 250-6573 (10 LINES AUTOMATIC) FAX 256-1313							 บริษัท ทESCO วิศวกรรม จำกัด (สำนักงานใหญ่) 537/102 ถนนสาธุประดิษฐ์ แขวงคลองจั่น เขตยานนาวา กรุงเทพมหานคร 10120		<table border="1"> <thead> <tr> <th>REV.</th> <th>REVISION</th> <th>DATE</th> <th>APPR.</th> <th colspan="2">APPROVAL</th> </tr> </thead> <tbody> <tr> <td>MARK</td> <td></td> <td></td> <td></td> <td colspan="2">ISSUED FOR</td> </tr> <tr> <td>△</td> <td>-</td> <td>-</td> <td>-</td> <td colspan="2">CONSTRUCTION</td> </tr> <tr> <td>△</td> <td>-</td> <td>-</td> <td>-</td> <td colspan="2">-</td> </tr> <tr> <td>△</td> <td>-</td> <td>-</td> <td>-</td> <td>APPROVED</td> <td>-</td> </tr> <tr> <td>△</td> <td>-</td> <td>-</td> <td>-</td> <td>ORDER NO.</td> <td>-</td> </tr> <tr> <td>△</td> <td>-</td> <td>-</td> <td>-</td> <td>CONTRACTOR</td> <td>-</td> </tr> <tr> <td>△</td> <td>AS-BUILT</td> <td>18/08/60</td> <td>-</td> <td>CONTRACT DATE</td> <td>-</td> </tr> </tbody> </table>				REV.	REVISION	DATE	APPR.	APPROVAL		MARK				ISSUED FOR		△	-	-	-	CONSTRUCTION		△	-	-	-	-		△	-	-	-	APPROVED	-	△	-	-	-	ORDER NO.	-	△	-	-	-	CONTRACTOR	-	△	AS-BUILT	18/08/60	-	CONTRACT DATE	-
REV.	REVISION	DATE	APPR.	APPROVAL																																																								
MARK				ISSUED FOR																																																								
△	-	-	-	CONSTRUCTION																																																								
△	-	-	-	-																																																								
△	-	-	-	APPROVED	-																																																							
△	-	-	-	ORDER NO.	-																																																							
△	-	-	-	CONTRACTOR	-																																																							
△	AS-BUILT	18/08/60	-	CONTRACT DATE	-																																																							
DESIGN		NAME	SIGNATURE	DESIGN	NAME	SIGNATURE	DATE	ESB ONE		ESB ONE CO.,LTD																																																		
ARCHITECT	NARAI T.	ชื่อ:1821		MECHANICAL ENGINEER	POTE L.	ชื่อ:2055			PROJECT		LCH - PROJECT 1																																																	
	PIYA S.	ชื่อ:9661			WICHAN T.	ชื่อ:14151			CLIENTS ADDRESS		MAPYANGNON PLUAK-DANG RAYONG		SCALE A1=1:25, A3=1:50																																															
STRUCTURAL ENGINEER	YUTANA C.	ชื่อ:6404		ELECTRICAL ENGINEER	TOSAPHON B.	ชื่อ:2341			DRAWING TITLE		-		DRAWING NO. LCH1-TT-ST-401																																															
CIVIL ENGINEER	PASIT T.	ชื่อ:2706		SANITARY ENGINEER	PASIT T.	ชื่อ:2706				BEAM DETAILS (SHEET 1)		REV. 0																																																



 <b>TESCO LTD. CONSULTING ENGINEERS</b> 21/11-14 SOI SUKHUMVIT 18, BANGKOK 10110 TEL. 259-8573 (10 LINES AUTOMATIC) FAX 258-1313					
DESIGN	NAME	SIGNATURE	DESIGN	NAME	SIGNATURE
ARCHITECT	NARAET T. สร.1821		MECHANICAL ENGINEER	POTE L. สร.2055	
	PIYA S. สร.19661			WICHAN T. สร.14151	
STRUCTURAL ENGINEER	YUTTANA C. สร.6404		ELECTRICAL ENGINEER	TOSAPHON B. สร.12341	
CIVIL ENGINEER	PASIT T. สร.2706		SANITARY ENGINEER	PASIT T. สร.2706	
					DATE 17/11/2014



บริษัท เทสโก้ วิศวกรรม จำกัด  
(สำนักงานใหญ่)  
537/102 ถนนสาธุประดิษฐ์ แขวงคลองจั่น  
เขตยานนาวา กรุงเทพมหานคร 10120

REV. MARK	REVISION	DATE	APPR.	APPROVAL	
				ISSUED FOR	CONSTRUCTION
△	-	-	-	DATE	-
△	-	-	-	APPROVED	-
△	-	-	-	ORDER NO.	-
△	-	-	-	CONTRACTOR	-
△	-	-	-	CONTRACT DATE	-
△	AS-BUILT	18/08/60	-		

ESB ONE		ESB ONE CO.,LTD	
		75 White Group Tower 2, 11 <sup>th</sup> Fl., Soi Rubin, Sukhumvit 42, Prakanong, Khlongtoey, Bangkok, Thailand	
PROJECT		LCH - PROJECT 1	
CLIENTS ADDRESS		MAPYANGPHON PLUAK-DAENG RAYONG	
DRAWING TITLE		BEAM DETAILS (SHEET 2)	
		SCALE AS SHOWN	
		DRAWING NO. LCH1-T1-ST-402	
		REV. 0	




<div><div><div><div><div><div></div></div></div><div><div><div></div></div></div></div><div>TESCO LTD. CONSULTING ENGINEERS</div><div>21/11-14 SOI SUKUMVIT 18 , BANGKOK 10110</div><div>TEL. 259-8573 (10 LINES AUTOMATIC) FAX 258-1313</div></div></div>					
DESIGN	NAME	SIGNATURE	DESIGN	NAME	SIGNATURE
ARCHITECT	NARAET T.	ชื่อ.1821	MECHANICAL ENGINEER	POTE L.	ชื่อ.2055
	PIYA S.	ชื่อ.9661		WICHAN T.	ชื่อ.14151
STRUCTURAL ENGINEER	YUTTANA C.	ชื่อ.6404	ELECTRICAL ENGINEER	TOSAPHON B.	ชื่อ.2341
CIVIL ENGINEER	PASIT T.	ชื่อ.2706	SANITARY ENGINEER	PASIT T.	ชื่อ.2706
DATE			17/11/2014		



บริษัท เอสบี หนึ่ง จำกัด  
(สำนักงานใหญ่)  
537/102 ถนนสาธุประดิษฐ์ แขวงคลองจั่น  
เขตยานนาวา กรุงเทพมหานคร 10120

REV.	MARK	REVISION	DATE	APPR.	APPROVAL	
	△	-	-	-	ISSUED FOR	
	△	-	-	-	CONSTRUCTION	
	△	-	-	-	DATE	-
	△	-	-	-	APPROVED	-
	△	-	-	-	ORDER NO.	-
	△	-	-	-	CONTRACTOR	-
	△	AS-BUILT	18/08/60	-	CONTRACT DATE	-

ESB ONE		ESB ONE CO.,LTD	
		75 White Group Tower 2, 11 <sup>th</sup> Fl., Soi Rubin, Sukhumvit 42, Prakanong, Khlongtoey, Bangkok, Thailand	
PROJECT		LCH - PROJECT 1	
CLIENTS ADDRESS		MAPYANGPHON PLUAK-DAENG RAYONG	
DRAWING TITLE		COLUMN SCHEDULE	
		SCALE	A1=1:25, A3=1:50
		DRAWING NO.	LCH1-T1-ST-501
		REV.	0

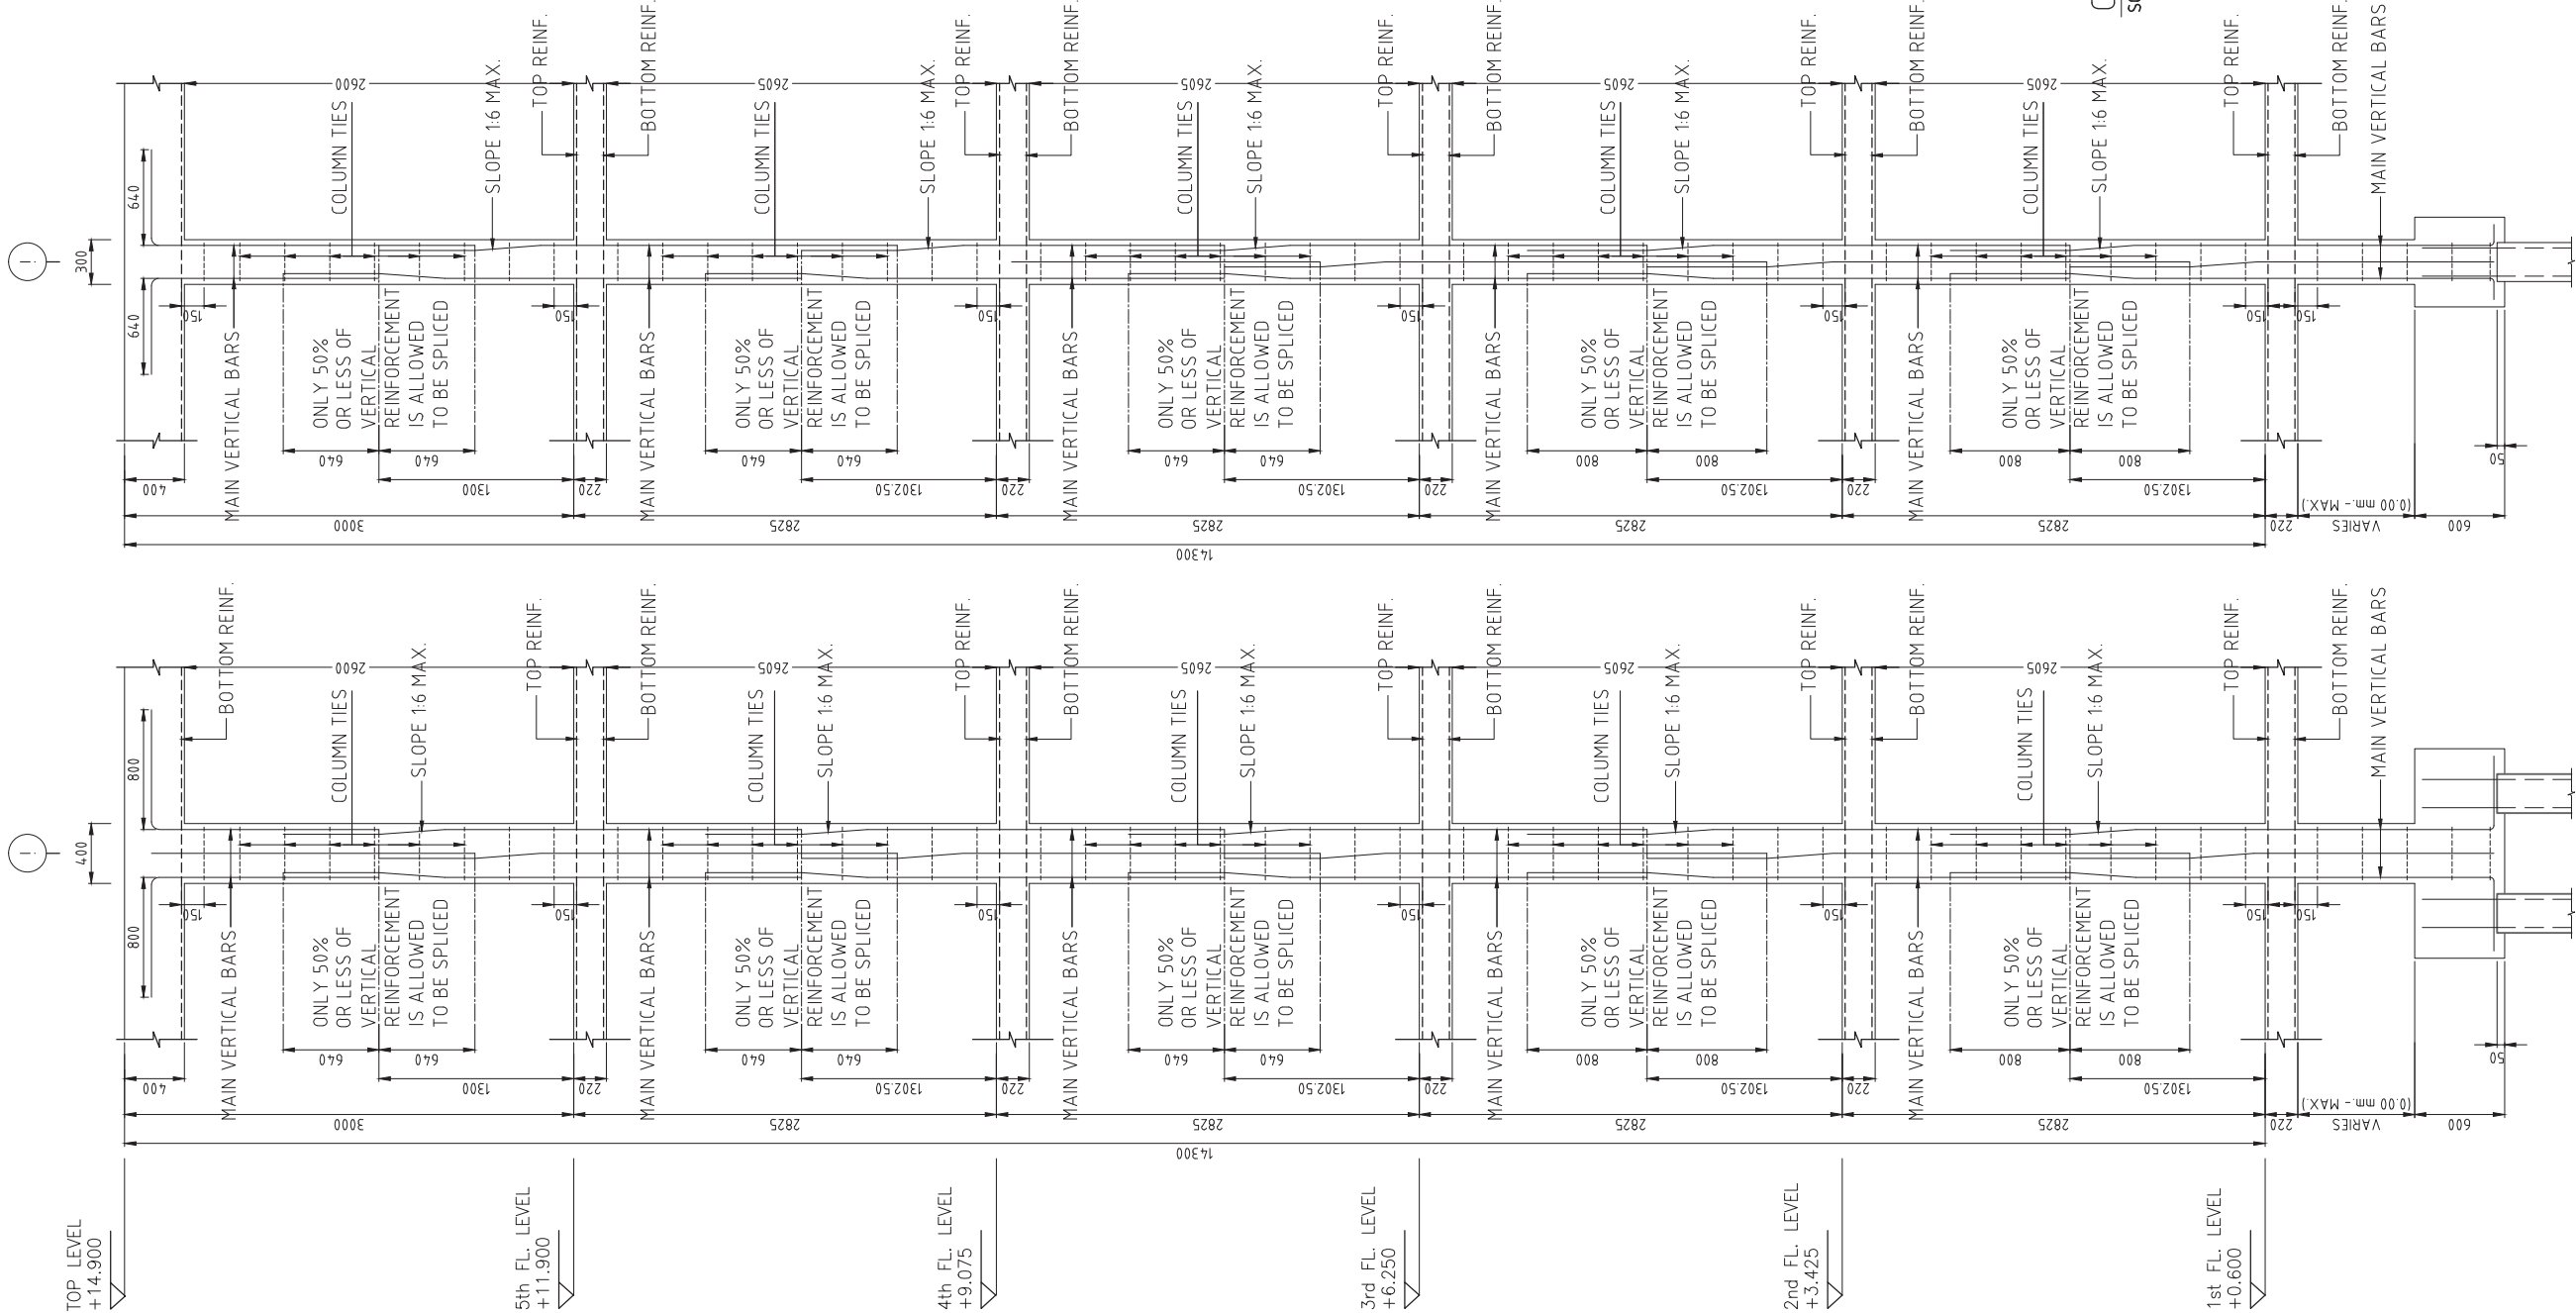

LOWER ROOF	<div>SIZE : 300x400 6DB16 MAIN 2DB10@300 TIES</div>
5th FLOOR	<div>SIZE : 300x400 6DB16 MAIN 2DB10@300 TIES</div>
5th FLOOR	<div>SIZE : 300x400 6DB16 MAIN 2DB10@300 TIES</div>
4th FLOOR	<div>SIZE : 300x400 6DB16 MAIN 2DB10@300 TIES</div>
4th FLOOR	<div>SIZE : 300x400 6DB16 MAIN 2DB10@300 TIES</div>
3rd FLOOR	<div>SIZE : 300x400 6DB16 MAIN 2DB10@300 TIES</div>
3rd FLOOR	<div>SIZE : 300x400 6DB16 MAIN 2DB10@300 TIES</div>
2nd FLOOR	<div>SIZE : 300x400 6DB16 MAIN 2DB10@300 TIES</div>
2nd FLOOR	<div>SIZE : 300x400 6DB16 MAIN 2DB10@300 TIES</div>
1st FLOOR	<div>SIZE : 300x400 6DB16 MAIN 2DB10@300 TIES</div>
1st FLOOR	<div>SIZE : 300x400 6DB16 MAIN 2DB10@300 TIES</div>
FOUNDATION	<div>SIZE : 300x400 6DB16 MAIN 2DB10@300 TIES</div>
LEVEL/FLOOR	COLUMN No.

COLUMN REINFORCEMENT DETAILS


SCALE 1:25

NOTES:


- 1) VERTICAL REINFORCEMENT CAN BE SPLICED ONLY AT MID-HEIGHT OF COLUMN.
- 2) MINIMUM SPLICED LENGTH FOR VERTICAL REINFORCEMENT IS TO BE EQUAL TO FULL COMPRESSION LAP (IF C.L.) LENGTH FOR NON-SEISMIC COLUMNS AND FULL TENSION LAP (IF T.L.) LENGTH FOR SEISMIC COLUMNS
- 3) VERTICAL REBARS CAN BE SPLICED BY USING MECHANICAL DEVICE (COUPLER). THE FOLLOWING REQUIREMENTS OF THE COUPLER HAVE TO BE SATISFIED:
  - A MECHANICAL CONNECTION SHALL DEVELOP IN TENSION OR COMPRESSION, AS REQUIRED, AT LEAST 125 PERCENT OF SPECIFIED YIELD STRENGTH OF REBAR. THE TEST IS TO BE CARRIED OUT AT THE 75% OF TOTAL THREAD LENGTH ENGAGED.
  - TAPERED THREAD COUPLER SYSTEM IS NOT ALLOWED.

COLUMNS DETAILS

SCALE 1:25

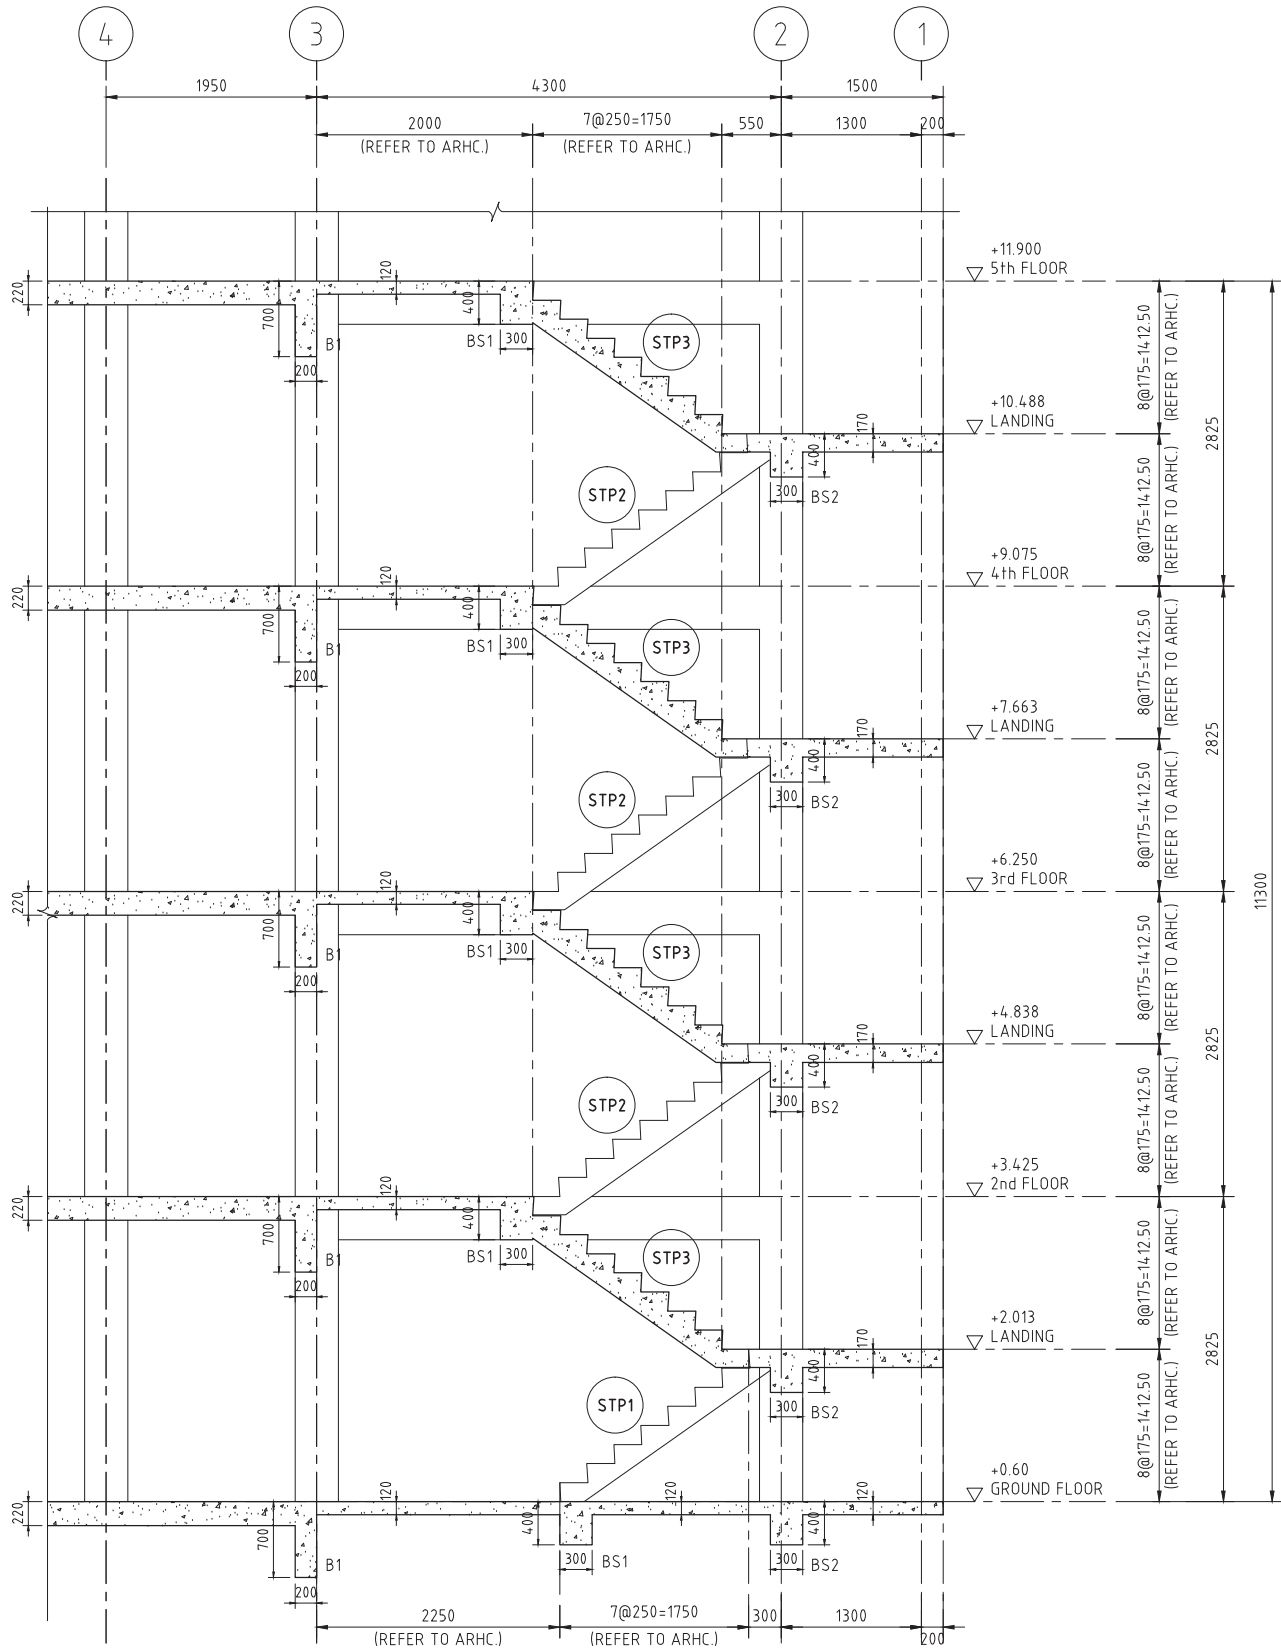

SECTION A  
SCALE 1:35

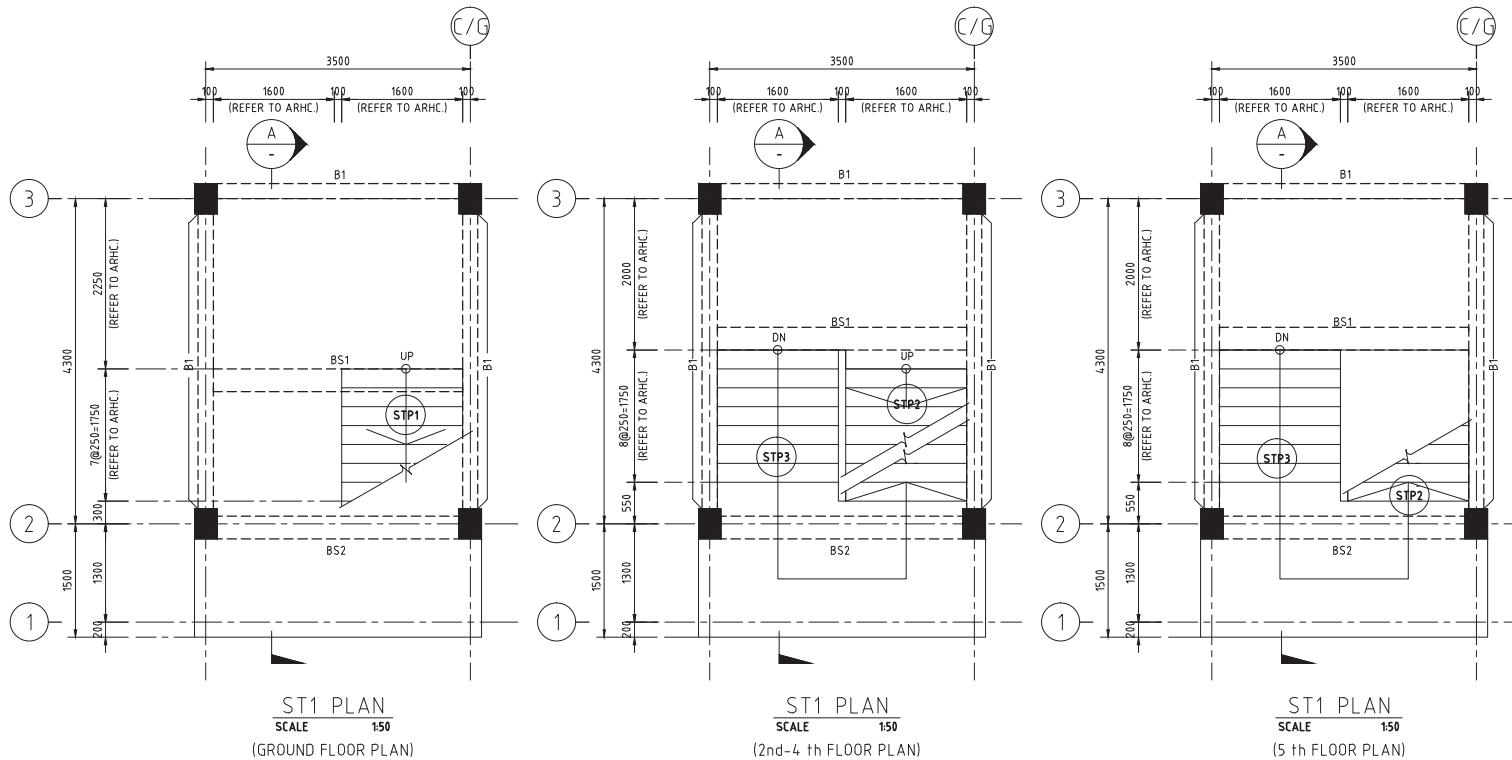







- NOTES:
- 1.) FOR SETOUT DIMENSIONS AND LEVELS REFER TO ARCHITECTURAL DRAWINGS.
  - 2.) FOR COLUMN SIZING & DETAILS, REFER TO DRAWING S5-01.
  - 3.) ALL TYPICAL DETAILS APPLY.
  - 4.) STP1 & STP2 REINFORCING REFER TO S6-02

<div><div></div><div><div>TESCO LTD. CONSULTING ENGINEERS</div><div>21/11-14 SOI SUKHUMVIT 18 , BANGKOK 10110</div><div>TEL. 259-8573 (10 LINES AUTOMATIC) FAX 258-1313</div></div></div>						
DESIGN	NAME	SIGNATURE	DESIGN	NAME	SIGNATURE	DATE
ARCHITECT	NARAE T. ๕๖๑.1821		MECHANICAL ENGINEER	POTE L. ๕๓๑.2055		17/11/2014
	PIYA S. ๖๓๑.9661			WICHAN T. ๖๓๑.14151		
STRUCTURAL ENGINEER	YUTTANA C. ๕๖๑.6404		ELECTRICAL ENGINEER	TOSAPHON B. ๕๓๑.2341		
CIVIL ENGINEER	PASIT T. ๕๖๑.2706		SANITARY ENGINEER	PASIT T. ๕๖๑.2706		



บริษัท เอสบีวัน จำกัด  
(สำนักงานใหญ่)  
537/102 ถนนสาธุประดิษฐ์ แขวงคลองจั่น  
เขตยานนาวา กรุงเทพมหานคร 10120

REV.	REVISION	DATE	APPR.	APPROVAL		ESB ONE	ESB ONE CO.,LTD			
MARK				ISSUED FOR			75 White Group Tower 2, 11 <sup>th</sup> Fl. Soi Rubia, Sukhumvit 42, Prakanong, Khlongtoey, Bangkok, Thailand			
△	—	—	—	CONSTRUCTION		PROJECT	LCH — PROJECT 1			
△	—	—	—	DATE —			CLIENTS ADDRESS	MAPYANGPHON PLUAK—DAENG RAYONG		
△	—	—	—	APPROVED	—	DRAWING TITLE		SCALE A1=1:50, A3=1:100		
△	—	—	—	ORDER NO.	—					
△	—	—	—	CONTRACTOR	—					
△	—	—	—	CONTRACT DATE	—					
△	AS—BUILT	18/08/60	—			STAIR DETAILS (SHEET 1)			DRAWING NO.	REV.
									LCH1—T1—ST—601	0

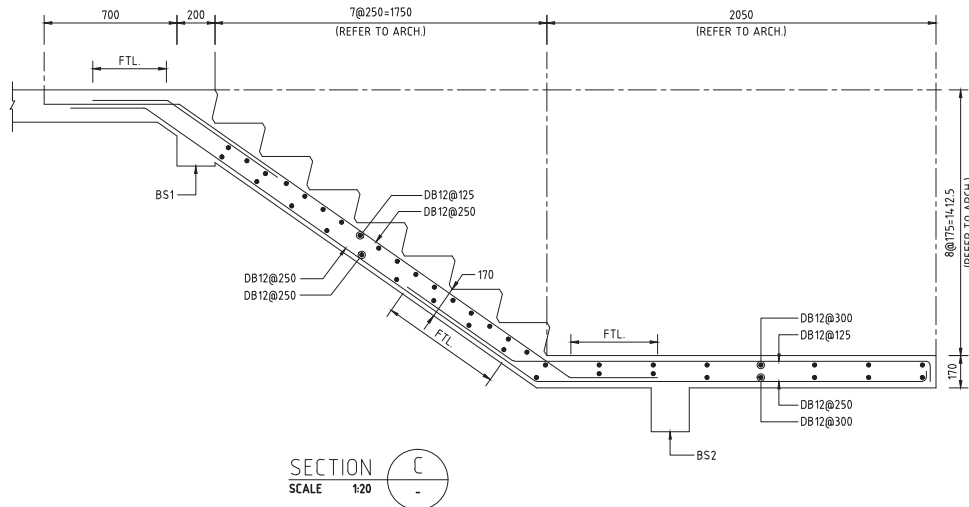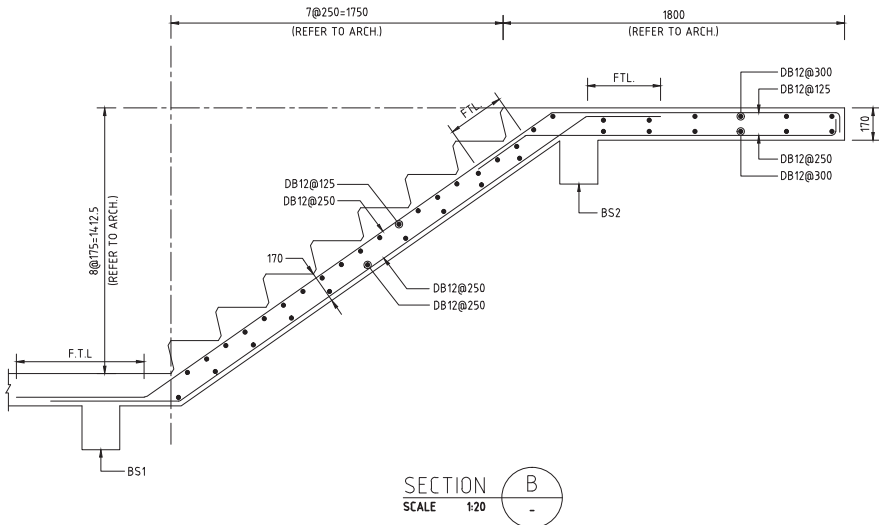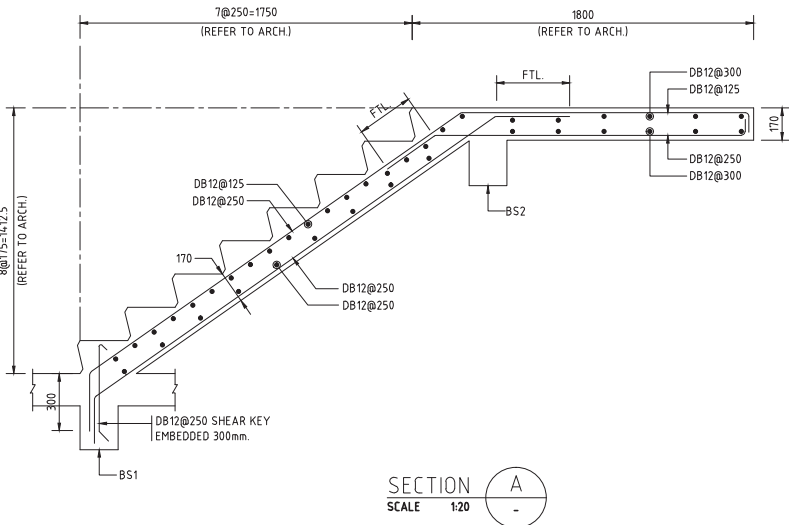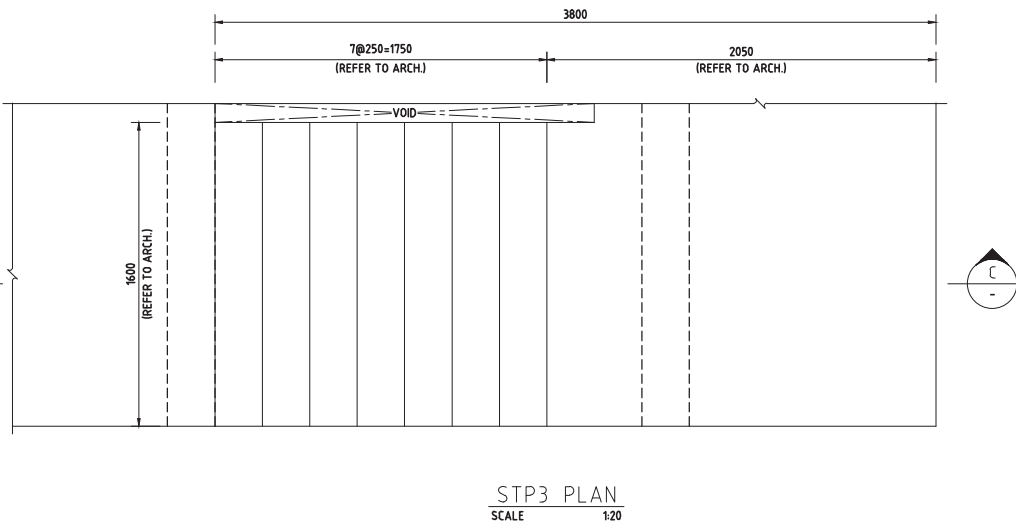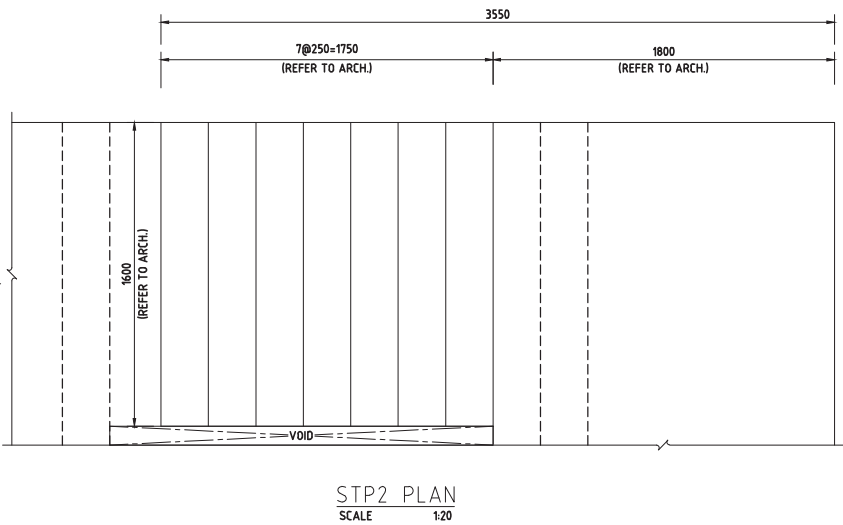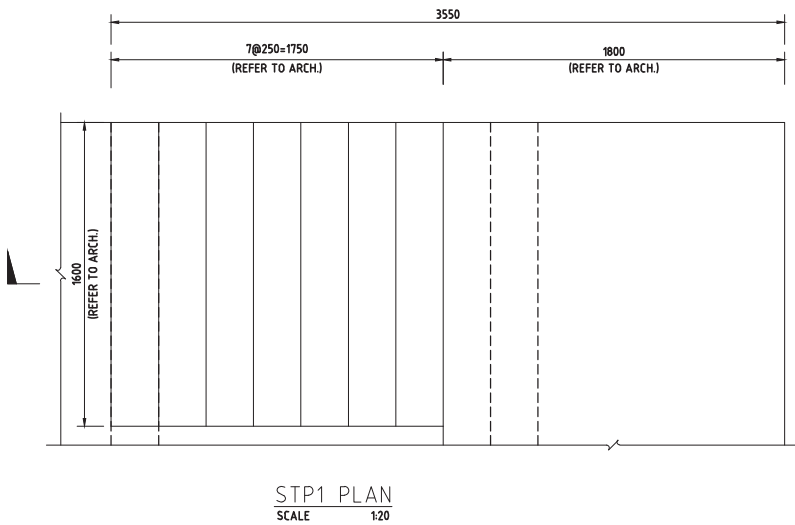

- NOTES:
- 1.) FOR SETOUT DIMENSIONS AND LEVELS REFER TO ARCHITECTURAL DRAWINGS.
  - 2.) FOR COLUMN SIZING & DETAILS, REFER TO DRAWING S5-01.
  - 3.) FOR BEAM SIZING & DETAILS, REFER TO DRAWING S4-01.
  - 4.) ALL TYPICAL DETAILS APPLY.




<div><div></div><div><div>TESCO LTD. CONSULTING ENGINEERS</div><div>21/11-14 SOI SUKHUMVIT 18 , BANGKOK 10110</div><div>TEL. 259-8573 (10 LINES AUTOMATIC) FAX 258-1313</div></div></div>						
DESIGN	NAME	SIGNATURE	DESIGN	NAME	SIGNATURE	DATE
ARCHITECT	NARAE T. รหัส.1821		MECHANICAL ENGINEER	POTE L. รหัส.2055		17/11/2014
	PIYA S. รหัส.19661			WICHAN T. รหัส.14151		
STRUCTURAL ENGINEER	YUTTANA C. รหัส.6404		ELECTRICAL ENGINEER	TOSAPHON B. รหัส.2341		
CIVIL ENGINEER	PASIT T. รหัส.2706		SANITARY ENGINEER	PASIT T. รหัส.2706		



บริษัท เอสบีวัน จำกัด  
(สำนักงานใหญ่)  
537/102 ถนนสาธุประดิษฐ์ แขวงช่องนนทรี  
เขตยานนาวา กรุงเทพมหานคร 10120

REV. MARK	REVISION	DATE	APPR.	APPROVAL	
				ISSUED FOR	
△	—	—	—	CONSTRUCTION	
△	—	—	—	DATE	—
△	—	—	—	APPROVED	—
△	—	—	—	ORDER NO.	—
△	—	—	—	CONTRACTOR	—
△	AS-BUILT	18/08/60	—	CONTRACT DATE	—

ESB ONE		ESB ONE CO.,LTD	
PROJECT		75 White Group Tower 2, 11 <sup>th</sup> Fl., Soi Rubia, Sukhumvit 42, Prakanong, Khlongtoey, Bangkok, Thailand	
CLIENTS ADDRESS		MAPYANGPHON PLUAK-DAENG RAYONG	
DRAWING TITLE		STAIR DETAILS (SHEET 2)	
		DRAWING NO.	REV.
		LCH1-T1-ST-602	0

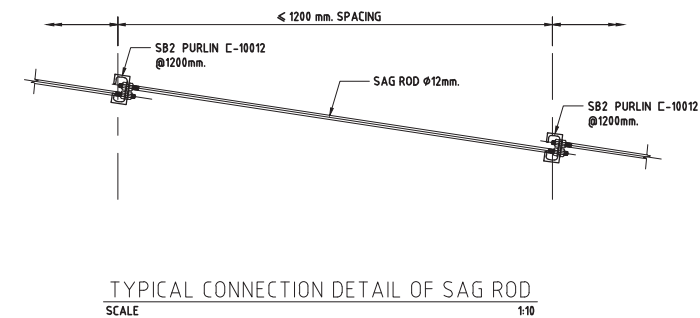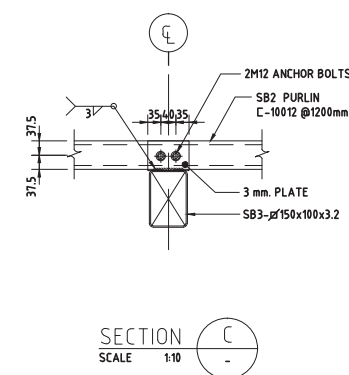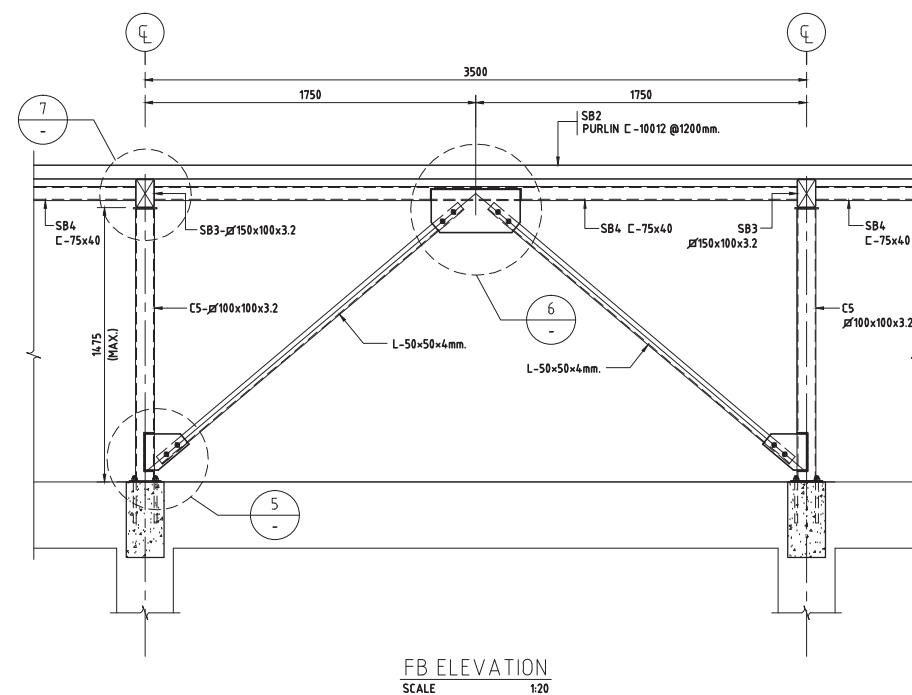

REV. MARK	REVISION	DATE	APPR.	APPROVAL		ESB ONE	ESB ONE CO.,LTD		SCALE	AS SHOWN	DRAWING NO. LCH1-T1-ST-701	REV O
				ISSUED FOR			PROJECT	75 White Group Tower 2, 11 <sup>th</sup> Fl, Soi Rubia, Sukhumvit 42, Prakanong, Khlongtoey, Bangkok, Thailand				
△	-	-	-	CONSTRUCTION		CLIENTS ADDRESS						
△	-	-	-	DATE	-	DRAWING TITLE						
△	-	-	-	APPROVED	-							
△	-	-	-	ORDER NO.	-							
△	-	-	-	CONTRACTOR	-							
△	-	-	-	CONTRACT DATE	-							
△	AS-BUILT	18/08/60	-			ROOF DETAILS						





0-2954-7745-6



0-2954-7747



[www.enviresearch.co.th](http://www.enviresearch.co.th)

*Save nature for the future.*

Environment Research & Technology Co.,Ltd. has been established since 1999 with the commitment to protect the quality of the environment and to provide services to the government and various industries.

The company together with the experienced consulting team will offer the environmental & safety engineering and technical services to support your environmental management and to assist your business and company to achieve safety and healthy environment.

บริษัท เอ็นไวรอนเมนต์ รีเสิร์ช แอนด์ เทคโนโลยี จำกัด  
เลขที่ 25/114 หมู่ 6 ซอยชินเขต 1 ถนนงามวงศ์วาน  
แขวงทุ่งสองห้อง เขตหลักสี่ กรุงเทพมหานคร 10210

Environment Research & Technology Co.,Ltd.  
25/114 Moo 6 Soi Chinaket 1, Ngamwongwan Road,  
Toongsonghong, Laksi, Bangkok 10210  
Tax. ID. 0105-542-064-981