


ภาคผนวก 2-5

แผนที่แสดงตำแหน่งแนวท่อของโครงการ

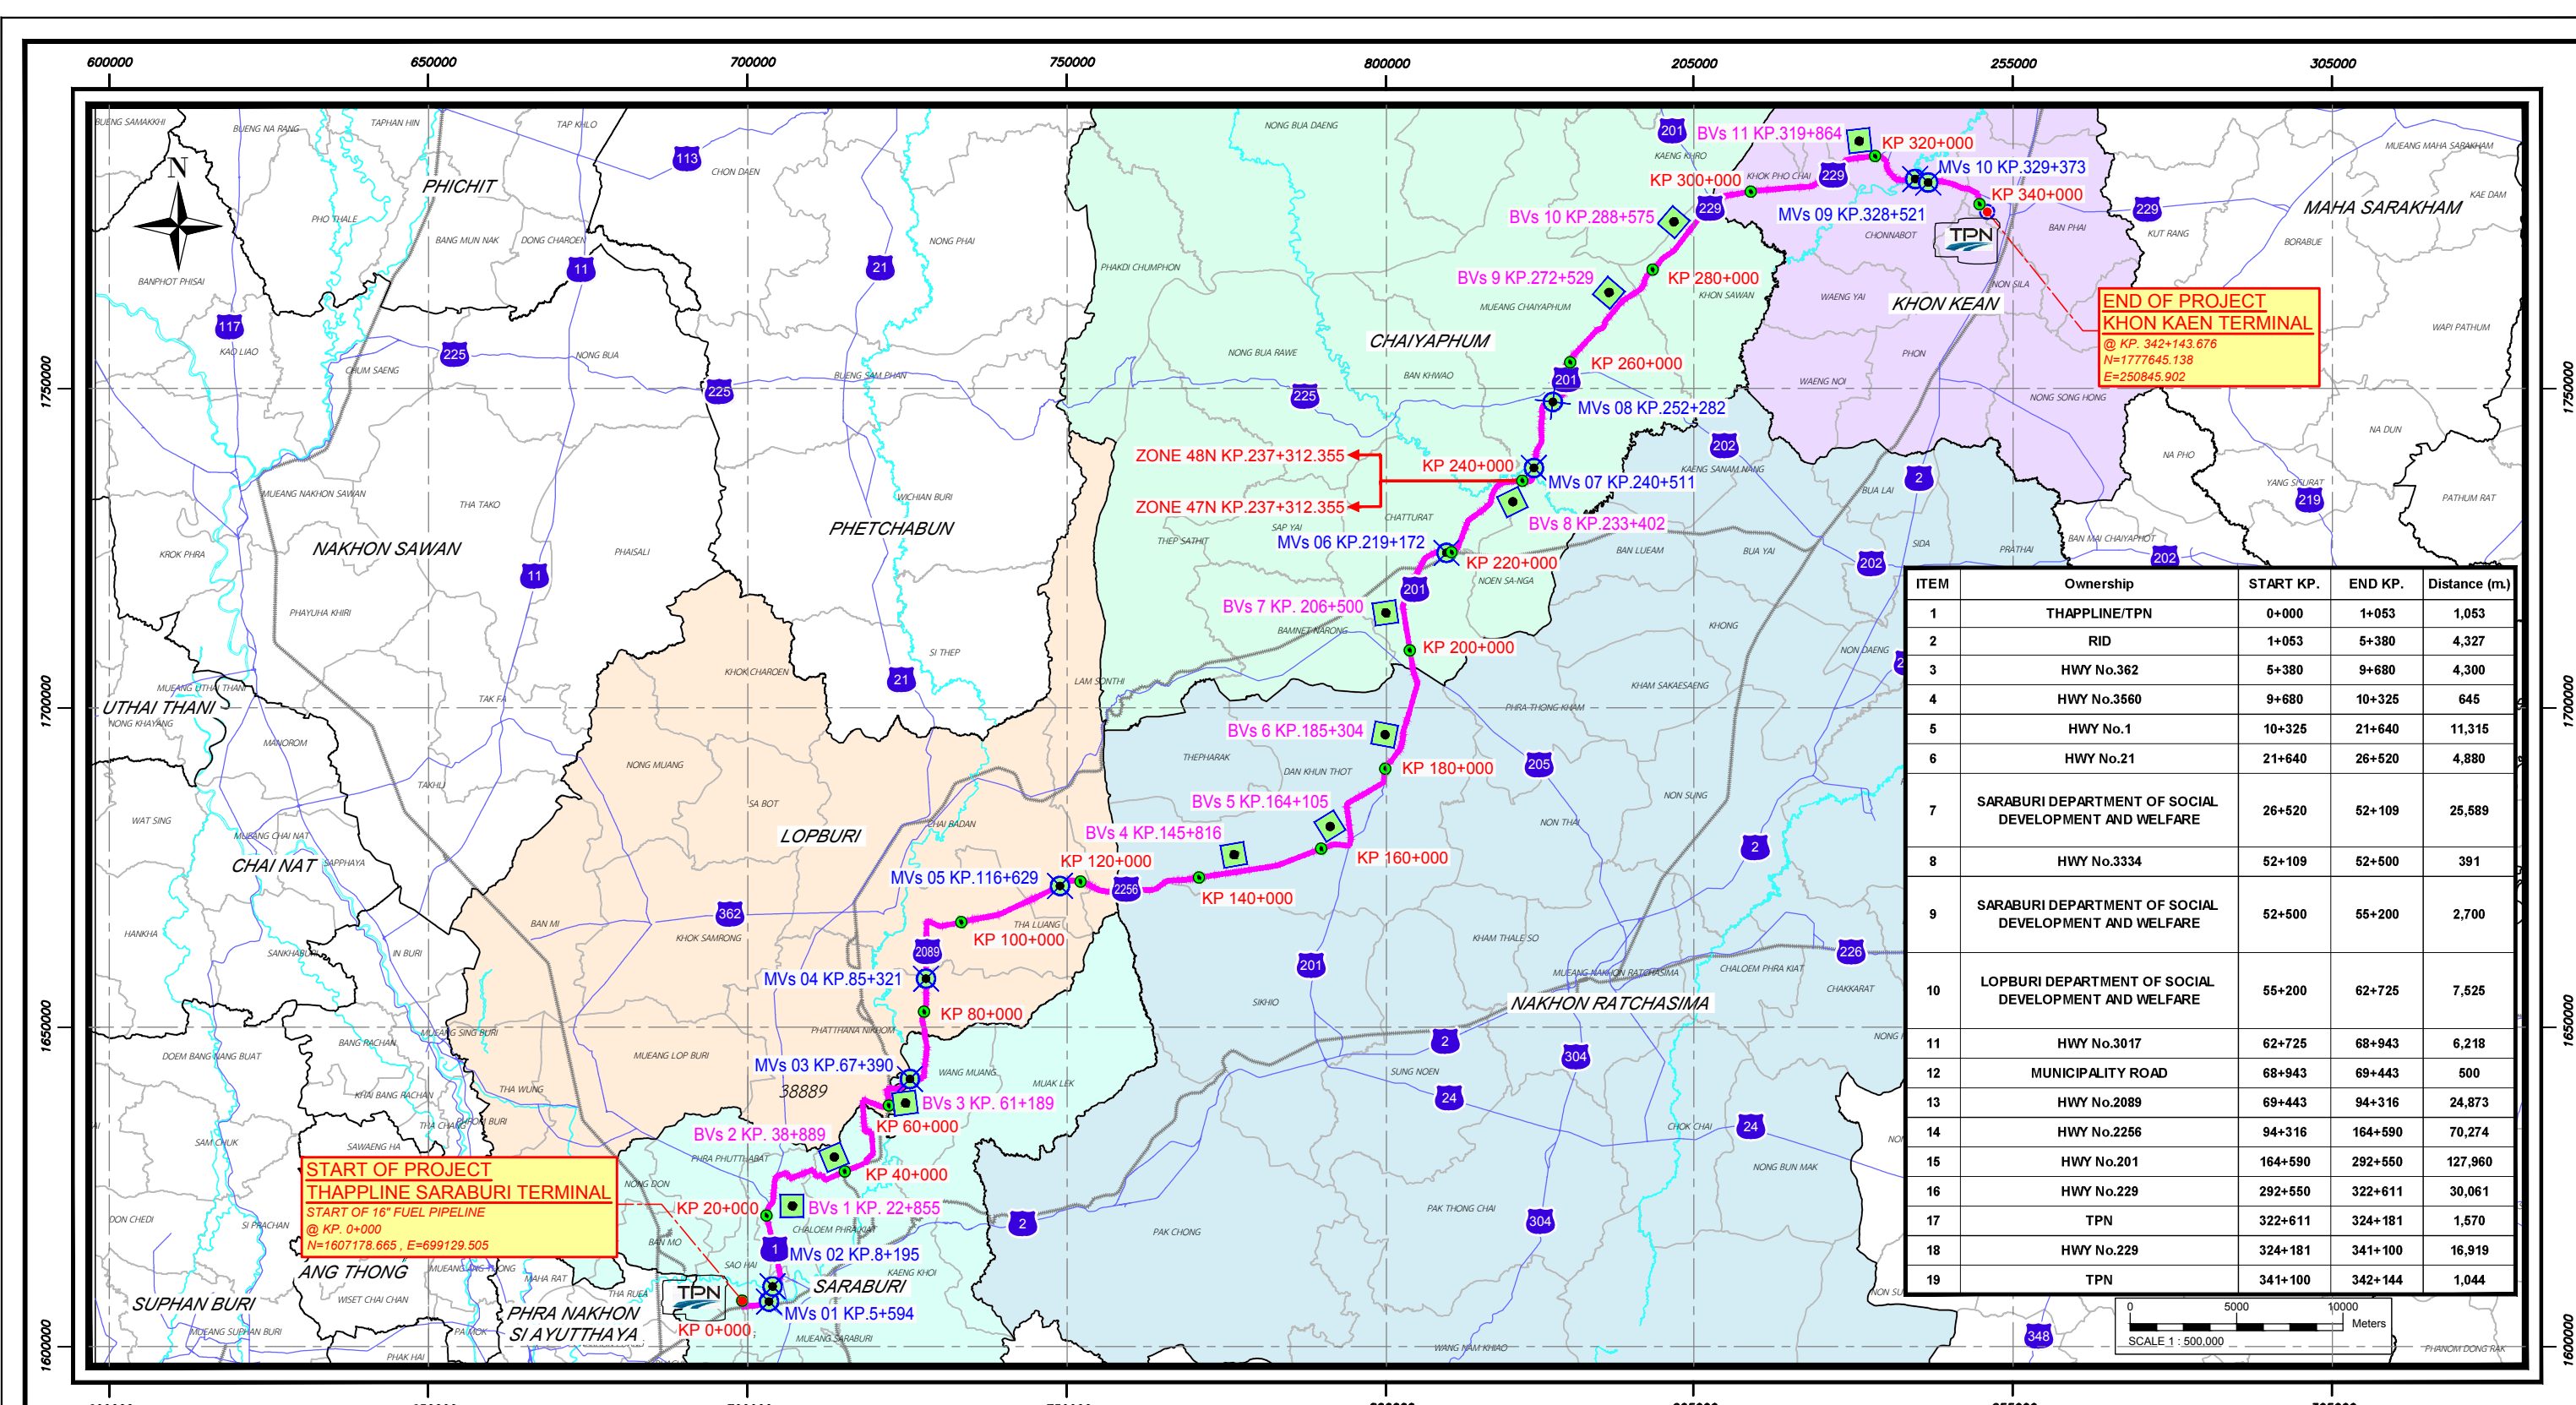

ITEM	Ownership	START KP.	END KP.	Distance (m.)
1	THAPPLINE/TPN	0+000	1+053	1,053
2	RID	1+053	5+380	4,327
3	HWY No.362	5+380	9+680	4,300
4	HWY No.3560	9+680	10+325	645
5	HWY No.1	10+325	21+640	11,315
6	HWY No.21	21+640	26+520	4,880
7	SARABURI DEPARTMENT OF SOCIAL DEVELOPMENT AND WELFARE	26+520	52+109	25,589
8	HWY No.3334	52+109	52+500	391
9	SARABURI DEPARTMENT OF SOCIAL DEVELOPMENT AND WELFARE	52+500	55+200	2,700
10	LOPBURI DEPARTMENT OF SOCIAL DEVELOPMENT AND WELFARE	55+200	62+725	7,525
11	HWY No.3017	62+725	68+943	6,218
12	MUNICIPALITY ROAD	68+943	69+443	500
13	HWY No.2089	69+443	94+316	24,873
14	HWY No.2256	94+316	164+590	70,274
15	HWY No.201	164+590	292+550	127,960
16	HWY No.229	292+550	322+611	30,061
17	TPN	322+611	324+181	1,570
18	HWY No.229	324+181	341+100	16,919
19	TPN	341+100	342+144	1,044


REFERENCE DRAWINGS		
No.	DRAWING No.	TITLE
1	D3-OPENE-0000-PL-102	DETAILED PIPELINE ROUTE MAP NO.1
2	D3-OPENE-0000-PL-103	DETAILED PIPELINE ROUTE MAP NO.2
3	D3-OPENE-0000-PL-104	DETAILED PIPELINE ROUTE MAP NO.3
4	D3-OPENE-0000-PL-105	DETAILED PIPELINE ROUTE MAP NO.4

GENERAL NOTES :
1. COORDINATE SYSTEM: WGS 1984 UTM ZONE 47N, 48N
PROJECTION: UNIVERSAL TRANSVERSE MERCATOR
DATUM: WGS 1984
UNITS: METER

LEGEND
16" FUEL PIPELINE
HIGHWAY
RAILWAY
PROVINCE BOUNDARY
DISTRICT
RIVER
KP. OF PIPELINE
BLOCK VALVE STATION
BREAK LINE
MANUAL VALVE

AS-BUILT Project: OPENE
APPROVED
BY :
DATE :
SUBCONTRACTOR
ASIA PIPELINES ASIA PIPELINES CO., LTD.
OWNER
TPN THAI PIPELINE NETWORK COMPANY LIMITED
CONSULTANT
TECHNIP ENERGIES
EPC CONTRACTOR
China Petroleum Pipeline Bureau (Thailand) Co., Ltd
PROJECT NAME :
OIL PIPELINE EXTENSION TO NORTH-EAST REGION OF THAILAND (OPENE) PROJECT
TITLE :
OVERALL PIPELINE ROUTE MAP
REV. 0
SHEET 1 OF 1
DRAWING NO. D3-OPENE-0000-PL-101
PROJECT NO. OPENE
SCALE AS SHOWN

0	21/04/23	AS-BUILT	ADS	CNB	WJF	SXD	
REV	DATE	REVISION DESCRIPTION	DRN.	CHKD.	ENG. APPRD.	PM. APPRD.	CUST. APPRD.

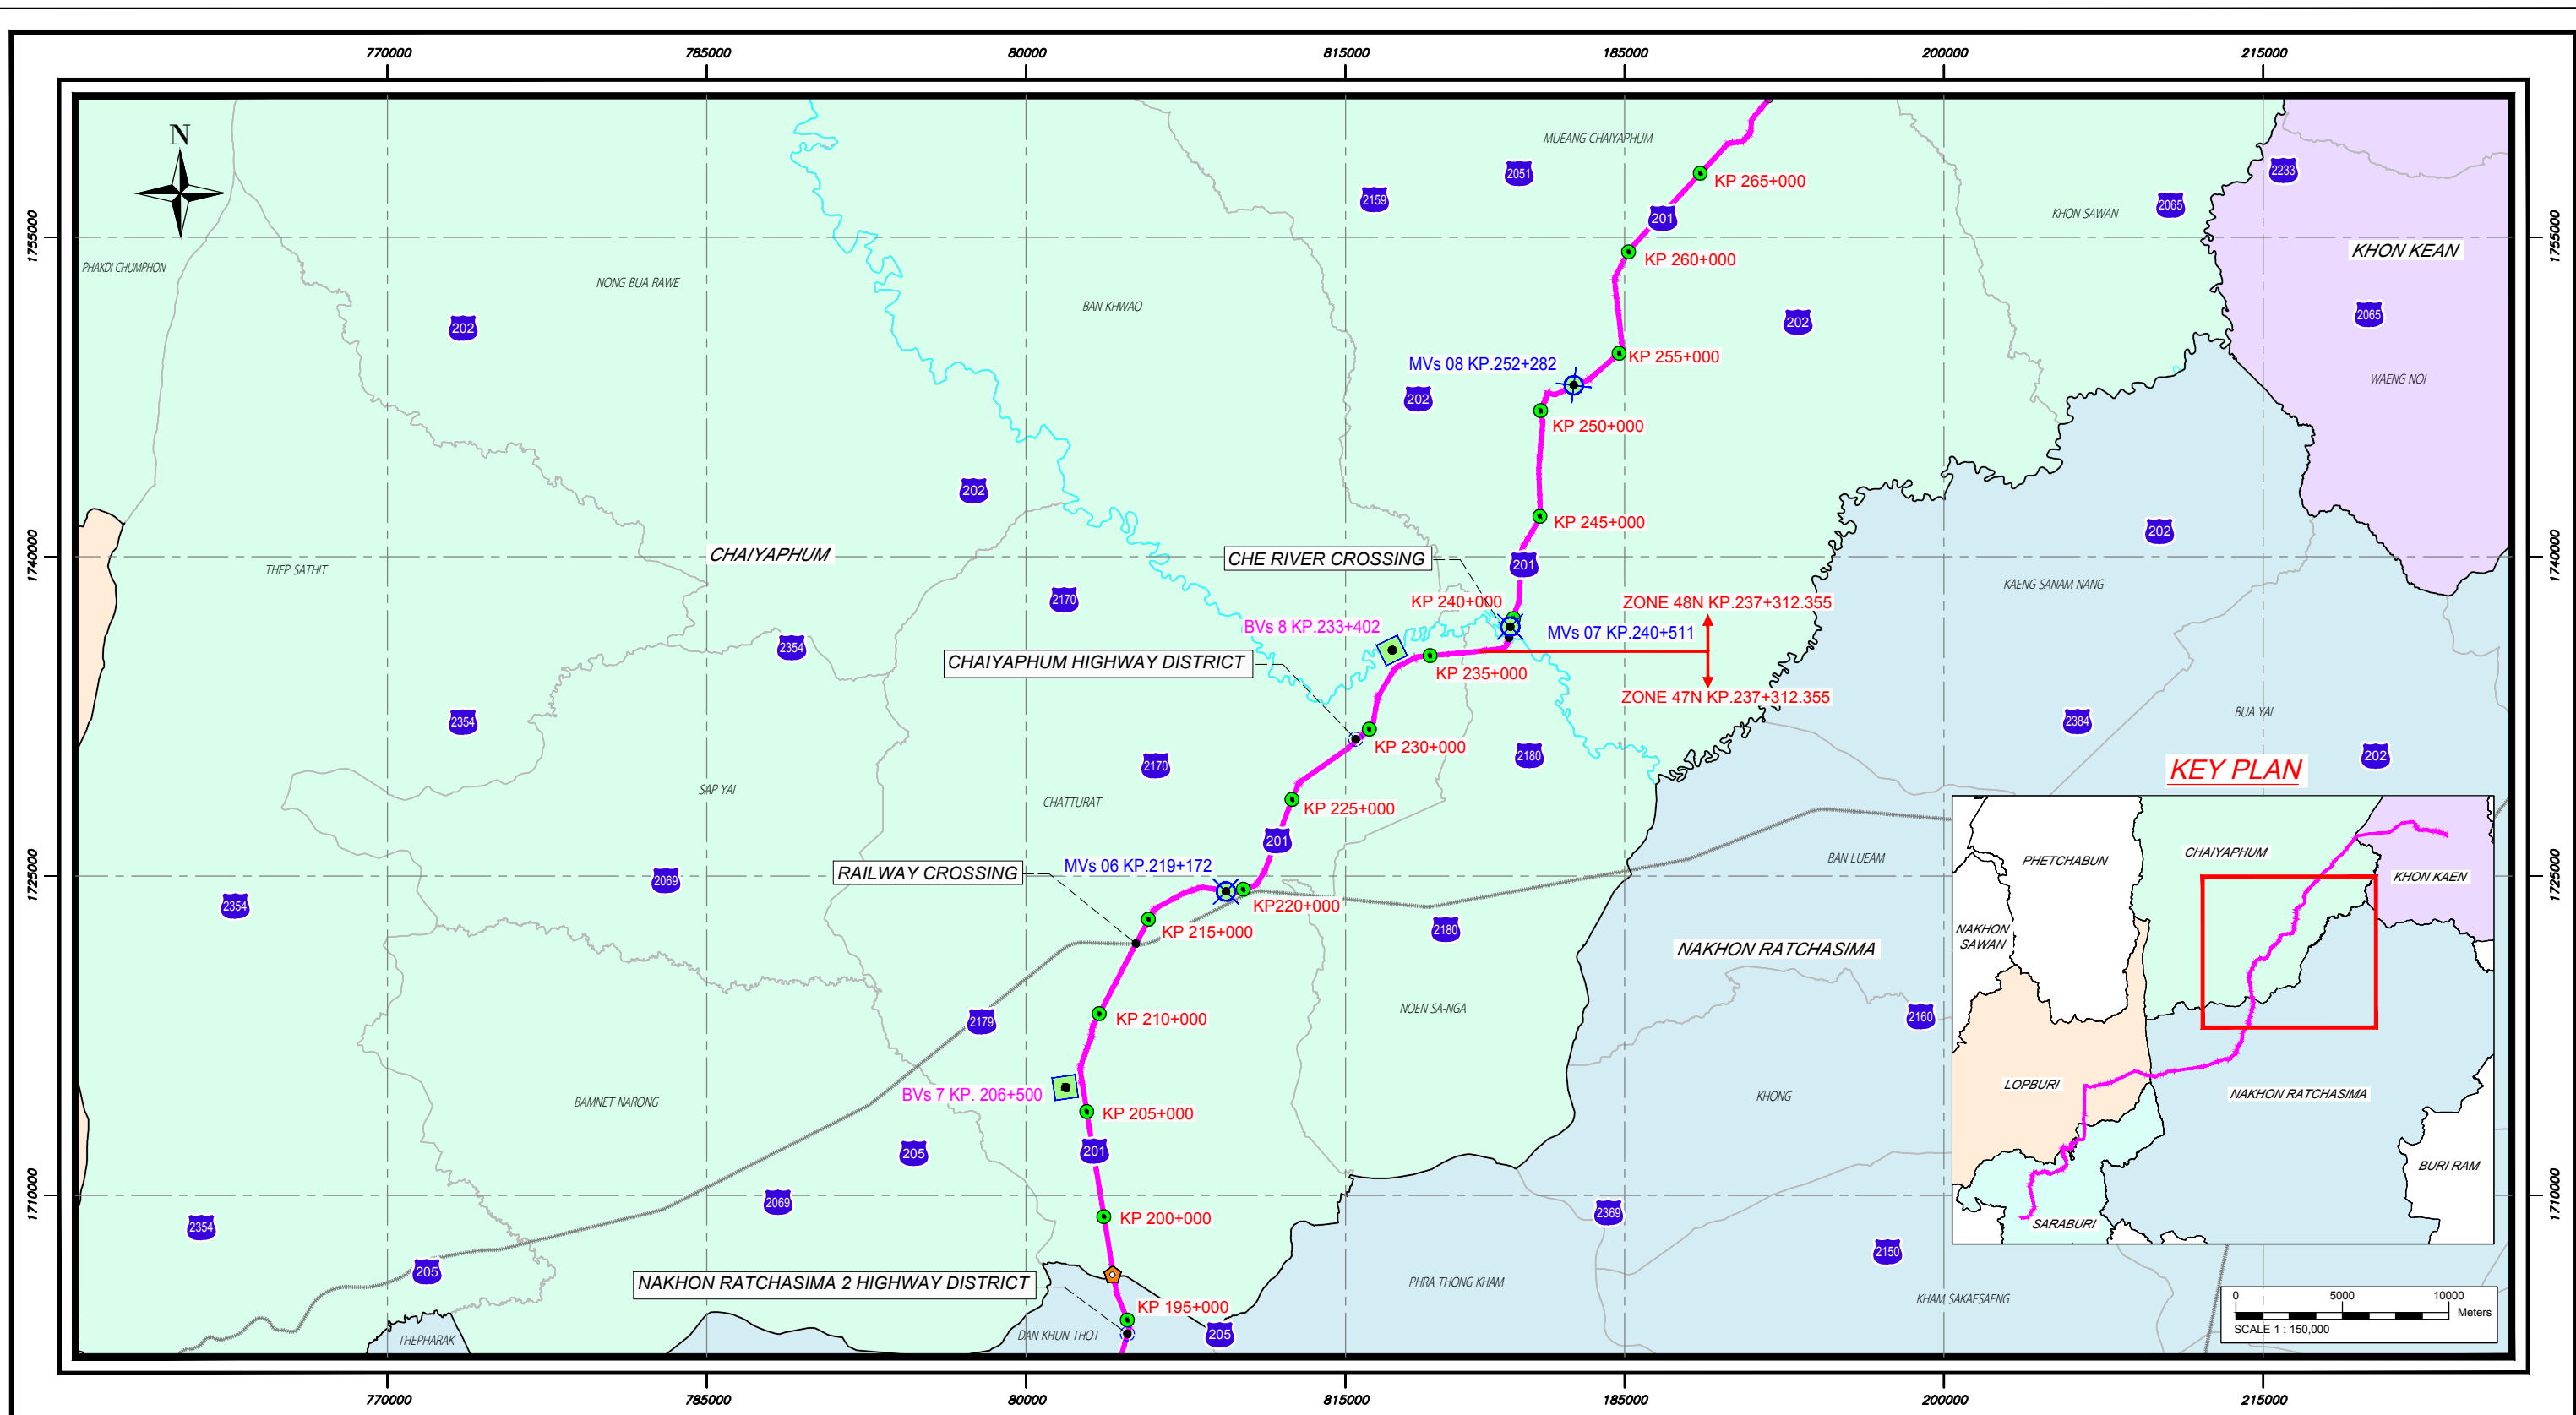

REFERENCE DRAWINGS	
No.	DRAWING No.
1	D3-OPENE-0000-PL-101
OVERALL PIPELINE ROUTE MAP	

GENERAL NOTES :
1. COORDINATE SYSTEM: WGS 1984 UTM ZONE 47N, 48N
PROJECTION: UNIVERSAL TRANSVERSE MERCATOR
DATUM: WGS 1984
UNITS: METER

LEGEND
16" FUEL PIPELINE
HIGHWAY
RAILWAY
PROVINCE BOUNDARY
DISTRICT
RIVER
KP OF PIPELINE
BLOCK VALVE STATION
BREAK LINE
MANUAL VALVE

AS-BUILT
Project: OPENE
APPROVED
BY :
DATE :

ASIA PIPELINES
ASIA PIPELINES CO., LTD.

REV	DATE	REVISION DESCRIPTION	DRN.	CHKD.	ENG. APPRD.	PM. APPRD.	CUST. APPRD.
0	21/04/23	AS-BUILT	ADS	CNB	WJF	SXD	

OWNER
TPN THAI PIPELINE NETWORK COMPANY LIMITED
CONSULTANT
TECHNIP ENERGIES
EPC CONTRACTOR
China Petroleum Pipeline Bureau (Thailand) Co., Ltd
PROJECT NAME :
OIL PIPELINE EXTENSION TO NORTH-EAST REGION OF THAILAND (OPENE) PROJECT
TITLE :
DETAILED PIPELINE ROUTE MAP NO.3

SCALE	PROJECT NO.	DRAWING NO.	SHEET	REV.
AS SHOWN	OPENE	D3-OPENE-0000-PL-104	1 OF 1	0

