

ภาคผนวก ข-4

เงื่อนไขสัญญาจ้างผู้รับเหมา

เงื่อนไขสัญญาจ้าง ระหว่างบริษัท เอ็กโก โคเจนเนอเรชั่น จำกัด
และบริษัท ทีอาร์ซี คอนสตรัคชั่น จำกัด (มหาชน)
(ระยะก่อสร้าง)

ORIGINAL

**NEW GAS PIPELINE SYSTEM
FOR EGCO COGENERATION SPP REPLACEMENT PROJECT**

EPC CONTRACT

CONTRACT AGREEMENT

CONTRACT NO. COGEN-EPC-2022-002

BETWEEN



EGCO COGENERATION COMPANY LIMITED

AND



 
TRC CONSTRUCTION PUBLIC COMPANY LIMITED

**CONTRACT AGREEMENT
CONTRACT NO. COGEN-EPC-2022-002
FOR
NEW GAS PIPELINE SYSTEM FOR EGCO COGENERATION SPP REPLACEMENT PROJECT**

This Contract is made this 1st day of the month of June 2022 by and between



hereinafter referred to as "Owner" of the one part, and:



hereinafter referred to as "Contractor", who shall bear complete responsibility for performance of Work under the terms and conditions specified in this Contract. Owner and Contractor agree that the Work specified herein shall be performed by Contractor in strict compliance with all provisions of this Contract which consists of the following documents:

Volume 1

- (i) This Contract Agreement
- (ii) Section I Terms of Negotiations
- (iii) Section II General Conditions
- (iv) Section III Special Conditions
- (v) Annex 1 Invitation to Bid and Addenda
- (vi) Annex 2 Contractor's Bid

Said Contract sets forth the entire contract and agreement between Owner and Contractor pertaining to the Work and supersedes all inquiries, proposals, agreements, negotiations and commitments, whether written or oral, prior to the Effective Date set forth below, pertaining to Work under this Contract. The provisions of this Contract may be changed only by a writing jointly executed by Owner and Contractor. Trade custom and trade usage are superseded by this Contract and shall not be applicable to the interpretation or performance of this Contract. This Contract is executed in duplicate on the date and year set forth above but is effective as of Effective Date: 1 February 2022.

Owner and Contractor have fully satisfied themselves with the terms and provisions hereof and have hereto appended their respective signatures in the presence of witnesses and each retains one original hereof.

NEW GAS PIPELINE SYSTEM
FOR EGCO COGENERATION SPP REPLACEMENT PROJECT
EPC CONTRACT
CONTRACT AGREEMENT

FOR: EGCO COGENERATION COMPANY LIMITED

BY:

Signature:

Name:

Title:

Chairman

JUN 2022

(please affix company seal here)



FOR: TRC CONSTRUCTION PUBLIC COMPANY LIMITED

BY:

Signature:

Name:

Title:

Marketing & Proposal Section Manager

JUN 2022

(please affix company seal here)





อ.ศ.5 ใบสัณห์คงดราสาฯ

เลขที่ 06068

วันที่ 6 มิถุนายน 2565

เลขประจำตัว [REDACTED] เลขที่สาขา
ชื่อผู้เสียภาษีอากร บริษัท ทิพย์ชัย คอนสตรัคชั่น จำกัด (มหาชน)

ในฐานะ ผู้มีหน้าที่เสียอากร

ที่อยู่ : เลขที่ 15 หมู่ 5 ตำบล 5 ซอย 32
อำเภอ -
หมู่บ้าน -
เลขที่ 8
ต.อ.ก/ซอย สุขาภิบาล 5 ซอย 32
ถนน -
เขต/อำเภอ บางเขน
รหัสไปรษณีย์ 10220

ชื่ออากร -
ชั้นที่ -
หมู่ที่ -
แยก -
แขวง/ตำบล ทานัง
จังหวัด กรุงเทพมหานคร



เลขประจำตัวผู้เสียภาษีอากร [REDACTED] เลขที่สาขา
ชื่อ บริษัท เอกโก โดเมนเนมเชน จำกัด

ได้เสียอากรแล้วเป็นเงินสำหรับดราสาฯตามบัญชีผู้เสียอากรแล้วฉบับที่ 4
ลักษณะดราสาฯ สัญญาจ้าง ดังนี้ :

	บาท	สต.
มูลค่าดราสาฯ	132,000,000	00
ค่าอากรแล้วฉบับ	132,000	00
เงินเพิ่ม	0	00
รวมเงิน	132,000	00



จำนวนเงินเป็นคำอักษร (หนึ่งแสนสามหมื่นสองพันบาทถ้วน)

ตามใบเสร็จ

เลขประจำตัว [REDACTED]

ลง

ตำแหน่ง

ใบสัณห์คงดราสาฯนี้จะสมบูรณ์เมื่อมีจำนวนเงินที่อากรแล้วฉบับของหน่วยเก็บภาษีอากร
ได้ลงชื่อและออกใบเสร็จรับเงินเรียบร้อยแล้ว



[illegible]

เงื่อนไขสัญญาจ้าง ระหว่างบริษัท เอ็กโก โคเจนเนอเรชั่น จำกัด
และบริษัท ปตท. จำกัด (มหาชน)
(ระยะดำเนินการ)

สัญญาบริการดำเนินงานบำรุงรักษา ระบบท่อและระบบอุปกรณ์เชื่อมต่อ

บริษัท ปตท. จำกัด (มหาชน)

เลขประจำตัวผู้เสียภาษีอากร [REDACTED]
(ผู้ให้บริการ)

และ

บริษัท เอ็กโก โคเจนเนอเรชั่น จำกัด

เลขประจำตัวผู้เสียภาษีอากร [REDACTED]
(ผู้เชื่อมต่อ)

สัญญาบริการดำเนินงานบำรุงรักษาระบบท่อและระบบอุปกรณ์เชื่อมต่อ

ทำที่ บริษัท ปตท. จำกัด (มหาชน)

วันที่ 15 มิ.ย. 2566

สัญญาบริการดำเนินงานบำรุงรักษาระบบท่อและระบบอุปกรณ์เชื่อมต่อ ("สัญญา") ทำขึ้น ระหว่าง บริษัท เอ็กโก โคเจนเนอเรชั่น จำกัด ที่อยู่ 222 อาคารเอ็กโก ถนนวิภาวดีรังสิต แขวงทุ่งสองห้อง เขตหลักสี่ กรุงเทพมหานคร โดย นายเทิดศักดิ์ วิจิตรสมบัติ ผู้มีอำนาจลงนามผูกพันนิติบุคคล ซึ่งต่อไปในสัญญานี้จะเรียกว่า "ผู้เชื่อมต่อ" ฝ่ายหนึ่ง กับ

บริษัท ปตท. จำกัด (มหาชน) สำนักงานใหญ่ตั้งอยู่ เลขที่ 555 ถนนวิภาวดีรังสิต แขวงจตุจักร เขตจตุจักร กรุงเทพมหานคร โดย นายประกอบ เบญจศิริลักษณ์ ตำแหน่ง ผู้ช่วยกรรมการผู้จัดการใหญ่ระบบท่อส่งก๊าซธรรมชาติ กลุ่มธุรกิจปิโตรเลียมขั้นต้นและก๊าซธรรมชาติ ซึ่งต่อไปในสัญญาฉบับนี้ เรียกว่า "ผู้ให้บริการ" อีกฝ่ายหนึ่ง

ตามที่

- ก. ผู้เชื่อมต่อและผู้ให้บริการได้จัดทำ สัญญาการเชื่อมต่อระบบส่งก๊าซธรรมชาติของ บริษัท ปตท. จำกัด (มหาชน) ลงวันที่ 23 พฤษภาคม 2566 เรียกว่า "สัญญาการเชื่อมต่อ" เพื่อเชื่อมต่อระบบท่อและระบบอุปกรณ์เชื่อมต่อเข้ากับระบบส่งก๊าซธรรมชาติบนบกเส้นที่ 4 ของ บริษัท ปตท. จำกัด (มหาชน) เพื่อรองรับการใช้ก๊าซธรรมชาติของโครงการก่อสร้างระบบท่อและระบบอุปกรณ์เชื่อมต่อไปยังโรงไฟฟ้า ของผู้เชื่อมต่อ
- ข. ตามข้อ 4.7 ของ สัญญาการเชื่อมต่อ กำหนดเงื่อนไขบังคับก่อนการทดสอบระบบท่อและระบบอุปกรณ์เชื่อมต่อ ผู้เชื่อมต่อ และผู้ให้บริการจะต้องมีสัญญาบริการดำเนินงานบำรุงรักษาระบบท่อและระบบอุปกรณ์เชื่อมต่อ จนกว่าจะมีการโอนกรรมสิทธิ์ทรัพย์สินแล้วเสร็จตามเงื่อนไขที่กำหนดในสัญญาการเชื่อมต่อ
- ค. สัญญาประกอบด้วยรายละเอียดดังนี้
 - ส่วนที่ 1 รายละเอียดการบริการบำรุงรักษาระบบท่อและระบบอุปกรณ์เชื่อมต่อ
 - ส่วนที่ 2 ข้อกำหนดและเงื่อนไข
 - เอกสารแนบท้าย

คู่สัญญาทั้งสองฝ่าย ตกลงทำสัญญาโดยมีรายละเอียดดังนี้

ส่วนที่ 1 รายละเอียด
การบริการบำรุงรักษาระบบท่อและระบบอุปกรณ์เชื่อมต่อ

- | | |
|----------------------------|---|
| ▪ เลขที่สัญญา | 2023-OAM-0001 |
| ▪ วัตถุประสงค์ | ดำเนินการบำรุงรักษาระบบท่อและระบบอุปกรณ์เชื่อมต่อ ตาม
เอกสารแนบท้าย 1 |
| | <input type="checkbox"/> กรณีจุดส่งเข้า |
| | (1) ก่อนการโอนกรรมสิทธิ์ในทรัพย์สินให้กับผู้ให้บริการ |
| | - ระบบท่อ สถานีควบคุมก๊าซ (ถ้ามี) และระบบอุปกรณ์
ตั้งแต่หน้าแปลนก่อนวาล์วตัดแยกชุดสุดท้ายในสถานีวัด
ไปจนถึงจุดเชื่อมต่อ รวมถึงระบบสื่อสารและระบบไฟฟ้า
ทั้งหมด |
| | - สถานีวัด (ไม่รวมวาล์วตัดแยกชุดสุดท้าย) (ยกเว้นกรณี
ตกลงกันเป็นอย่างอื่น) |
| | (2) หลังการโอนกรรมสิทธิ์ในทรัพย์สินให้กับผู้ให้บริการ |
| | - สถานีวัด (ไม่รวมวาล์วตัดแยกที่โอนให้แก่ผู้ให้บริการ
แล้ว) (ยกเว้นกรณีตกลงกันเป็นอย่างอื่น) |
| | <input checked="" type="checkbox"/> กรณีจุดจ่ายออก |
| | (1) ก่อนการโอนกรรมสิทธิ์ในทรัพย์สินให้กับผู้ให้บริการ |
| | - ระบบท่อ สถานีควบคุมก๊าซ (ถ้ามี) และระบบอุปกรณ์
หลังจุดเชื่อมต่อจนถึงหน้าแปลนหลังวาล์วตัดแยกชุดแรก
ในสถานีวัด รวมถึงระบบสื่อสารและระบบไฟฟ้าทั้งหมด
จนกว่าการโอนจะเสร็จสิ้นและ |
| | - สถานีวัด (ไม่รวมวาล์วตัดแยกชุดแรก) |
| | (2) หลังการโอนกรรมสิทธิ์ในทรัพย์สินให้กับผู้ให้บริการ |
| | - สถานีวัด (ไม่รวมวาล์วตัดแยกชุดแรกที่โอนให้แก่ผู้ให้
บริการแล้ว) |
| ▪ วันที่สัญญามีผลบังคับใช้ | 30 มิถุนายน 2566 |
| ▪ วันที่สัญญาสิ้นสุด | 29 มิถุนายน 2568 |
| ▪ ระยะเวลาของสัญญา | 2 ปี |


เอกสารแนบท้าย 1

ขอบเขตการให้บริการ

ก. ขอบเขตพื้นที่การให้บริการ

ตามขอบเขตของข้อกำหนดเกี่ยวกับการเปิดให้ใช้หรือเชื่อมต่อระบบส่งก๊าซธรรมชาติบนบกแก่บุคคลที่สาม รวมถึงสถานีควบคุมก๊าซ (Block Valve Station) และสถานีวัด (Metering Station) ดังนี้

จุดเริ่มต้นของการให้บริการ : โครงการท่อส่งก๊าซธรรมชาติไปยังโรงไฟฟ้าเอ็กโก โคเจน (ส่วนขยาย ครั้งที่ 1) ตั้งอยู่เลขที่ 222 หมู่ที่ 8 ถนนทางหลวงระยอง-ปลวกแดง ตำบลมาบข่า อำเภอนิคมพัฒนา จังหวัดระยอง มีขนาดเส้นผ่านศูนย์กลาง 8 นิ้ว โดยมีจุดเริ่มต้นที่สถานีควบคุมระบบการขนส่งปิโตรเลียมทางท่อที่ 1 (BV 4.1) ของบริษัท ปตท. จำกัด (มหาชน) ณ จุดเชื่อมต่อ Tie-in Valve (Ball valve 12" HV 003 และ Ball valve 2" HV 003) โดยแนวท่อส่งก๊าซธรรมชาติของโครงการฯ จะวางในเขตทางของถนนชุมชนหนองคล้าซอย 5 (ซอยมาบใหญ่-กระเจต) เข้าสู่พื้นที่ของโรงไฟฟ้าเอ็กโก โคเจน (ส่วนขยาย ครั้งที่ 1) และไปสิ้นสุดที่สถานีควบคุมและวัดปริมาตรก๊าซธรรมชาติ (MRS) ที่อยู่ภายในโครงการฯ มีความยาวประมาณ 1.369 กิโลเมตร ตามรูปที่ 1

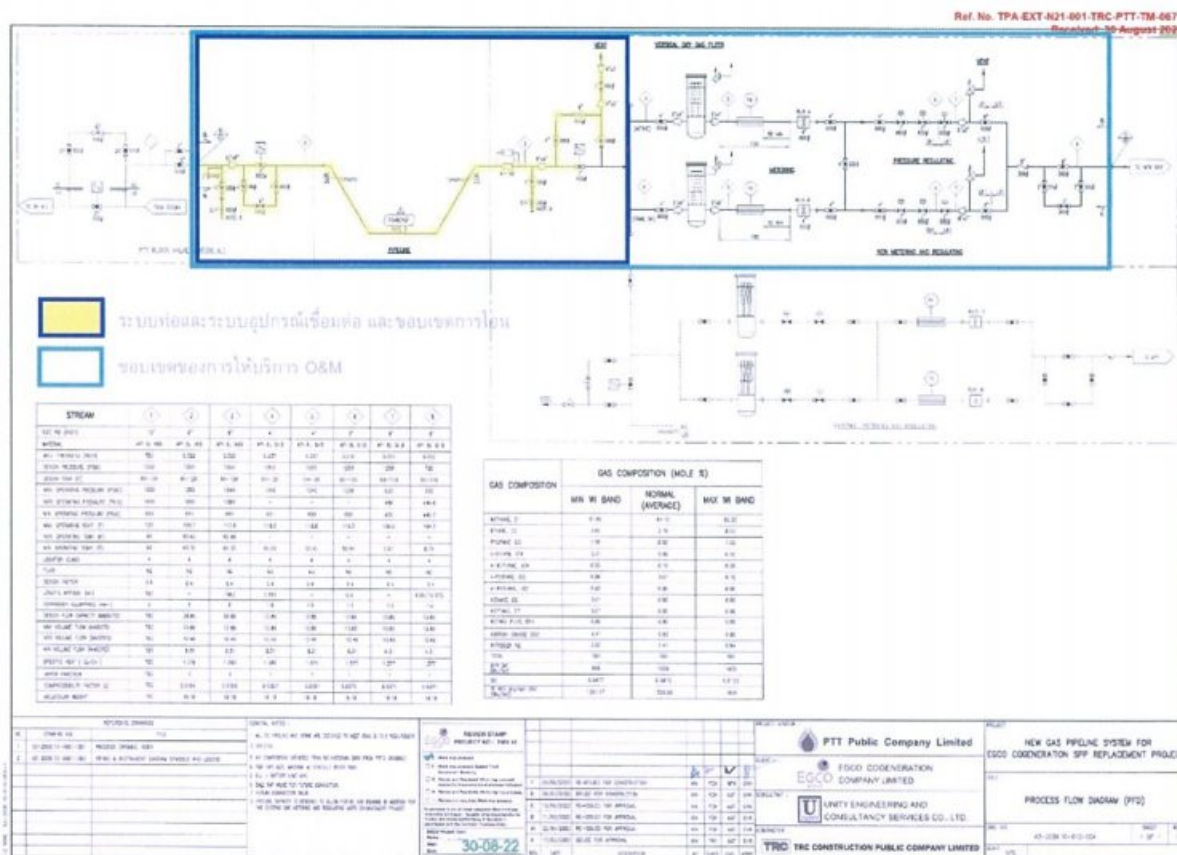

รูปที่ 1 ภาพแสดงขอบเขตการให้บริการ O&M

ข. ขอบเขตการให้บริการ

1. งานปฏิบัติการและบำรุงรักษาระบบท่อและระบบอุปกรณ์จนถึงจุดส่งมอบก๊าซตามขอบเขตของข้อกำหนดเกี่ยวกับการเปิดให้ใช้หรือเชื่อมต่อระบบส่งก๊าซธรรมชาติบนบกแก่บุคคลที่สาม รวมถึงสถานีควบคุมก๊าซ (Block Valve Station) ภายใต้มาตรฐาน ASME B31.8s (American Society of Mechanical Engineers) มาตรฐาน AGA (American Gas Association), GPA (Gas Processors Association), ASTM (American Society for Testing and Materials) และ API (American Petroleum Institute) เป็นต้น
 - 1.1 งานปฏิบัติการและบำรุงรักษาระบบท่อรวมถึงสถานีควบคุมก๊าซ (Block Valve Station) (ถ้ามี) หมายรวมถึงงาน Preventive Maintenance และงาน Corrective Maintenance รายละเอียดตามเอกสารแนบท้าย 2 และงานจ้างรักษาความปลอดภัย (ถ้ามี)
 - 1.2 งานปฏิบัติการและบำรุงรักษาเครื่องมือวัด ระบบควบคุมและอุปกรณ์เชื่อมต่อ สำหรับสถานีวัด (Gas Metering Station) หมายรวมถึงงาน Preventive Maintenance และงาน Corrective Maintenance รายละเอียดตามเอกสารแนบท้าย 2

เอกสารแนบท้าย 2

รายละเอียดในการให้บริการบำรุงรักษาและอัตราค่าบริการ

ก. Preventive Maintenance

1) งานปฏิบัติการและบำรุงรักษาระบบท่อ

1.1) งานปฏิบัติการและบำรุงรักษาระบบท่อ มีรายการงานดังต่อไปนี้

รายละเอียด	หน่วย	อัตราค่าบริการ	
		ปีที่ 1	ปีที่ 2
<ul style="list-style-type: none"> การลาดตระเวนตรวจแนววางท่อส่งก๊าซธรรมชาติ และการตรวจสอบการรั่วไหลของก๊าซธรรมชาติ อย่างน้อย 4 ครั้งต่อปี การตรวจสอบประสิทธิภาพของระบบป้องกันการผุกร่อน ส่วนภายนอกสถานี (Cathodic Protection : CP) อย่างน้อย 2 ครั้งต่อปี 	บาท/ กิโลเมตร/ เดือน	6,000	6,000

2) งานปฏิบัติการและบำรุงรักษาระบบอุปกรณ์สำหรับสถานีวัด มีรายการงานดังต่อไปนี้

รายละเอียด	หน่วย	อัตราค่าบริการ	
		ปีที่ 1	ปีที่ 2
2.1 ค่าบริการบำรุงรักษาท่อ & อุปกรณ์ สำหรับสถานี <ul style="list-style-type: none"> การตรวจสอบสภาพความผุกร่อนบนผิวท่อเหนือผิวดิน และหน้าแปลน (Atmospheric corrosion survey) อย่างน้อย 1 ครั้งต่อปี การตรวจสอบประสิทธิภาพของระบบป้องกันการผุกร่อนท่อในสถานี (Cathodic Protection : CP) อย่างน้อย 1 ครั้งต่อปี งานตรวจสอบการตัดแยกทางไฟฟ้า (Insulation joints หรือ Insulation flange) ทุก 1 ปี การบำรุงรักษาอุปกรณ์สื่อสาร Fiber Optic และ FOTE อย่างน้อย 2 ครั้งต่อปี 	บาท/ สถานี/ เดือน	46,000	49,000
2.2 ค่าบริการบำรุงรักษาชุดอุปกรณ์วัด <ul style="list-style-type: none"> การตรวจสอบสภาพทั่วไปของอุปกรณ์ภายในสถานี อย่างน้อย 12 ครั้งต่อปี การตรวจสอบการรั่วไหลของก๊าซภายในสถานี อย่างน้อย 2 ครั้งต่อปี การตรวจสอบวาล์วระบายแรงดันสถานี (Process Relief Valve) อย่างน้อย 1 ครั้งต่อปี การตรวจสอบและทดสอบการทำงานของอุปกรณ์ควบคุมความดัน ทุก 6 เดือน 	บาท/ ชุด/ เดือน		

<ul style="list-style-type: none"> ● การตรวจสอบอุปกรณ์กรองฝุ่นละอองอย่างน้อย 1 ครั้งต่อปี ● การตรวจสอบและทดสอบอุปกรณ์ส่งสัญญาณวัดแรงดัน และมาตรวัดอุณหภูมิ อย่างน้อย 1 ครั้งต่อปี ● การตรวจสอบและทดสอบวาล์วตัดแยกระบบ วาล์วควบคุมแรงดันภายในสถานี อย่างน้อย 1 ครั้งต่อปี ● การตรวจสอบและสอบเทียบอุปกรณ์วัดปริมาณก๊าซ ทุก 3 ปี ● การตรวจสอบอุปกรณ์ RTU อย่างน้อย 2 ครั้งต่อปี ● การตรวจสอบอุปกรณ์ทางไฟฟ้า อย่างน้อย 2 ครั้งต่อปี ● การตรวจสอบและสอบเทียบอุปกรณ์คำนวณปริมาณก๊าซ อย่างน้อยทุก 3 ปี ● การตรวจสอบและทดสอบอุปกรณ์ความปลอดภัยและระบบดับเพลิง อย่างน้อย 1 ครั้งต่อปี ● การตรวจสอบอุปกรณ์ปรับอากาศ อย่างน้อย 2 ครั้งต่อปี ● ทำความสะอาดล้างสถานี 2 ครั้ง ต่อปี 			
---	--	--	--

หมายเหตุ

1. ผู้ให้บริการขอสงวนสิทธิในการเปลี่ยนแปลงอัตราค่าบริการในปีถัดไป โดยจะมีการแจ้งให้ทราบล่วงหน้าหรือเป็นไปตามหลักการที่ กกพ. เห็นชอบ
2. ผู้ให้บริการจะเริ่มให้บริการบำรุงรักษา ตั้งแต่วันเริ่มใช้ก๊าซเชิงพาณิชย์ของระบบท่อและระบบอุปกรณ์เชื่อมต่อ ซึ่งระบุไว้ในหนังสือแจ้งผลการจ่ายก๊าซธรรมชาติเข้าระบบและทดสอบระบบ (First Gas and Commissioning)

ภาคผนวก ข-5

คู่มือปฏิบัติการและติดต่อประสานงาน
การบำรุงรักษาระบบท่อ

คู่มือปฏิบัติการ และติดต่อประสานงาน

ระหว่าง

ส่วนปฏิบัติการระบบท่อเขต 3

และ

บริษัท เอ็กโก โคเจนเนอเรชั่น จำกัด



ส่วนปฏิบัติการระบบท่อเขต 3
บริษัท ปตท. จำกัด (มหาชน)

สารบัญ

บทที่	เรื่อง
1	วัตถุประสงค์
2	ขั้นตอนการปฏิบัติงานในสถานีควบคุมความดันและวัดปริมาตรก๊าซ
3	ความรับผิดชอบในการปฏิบัติงานบำรุงรักษา
4	การติดต่อประสานงาน
5	แบบฟอร์มที่ใช้ในงานบำรุงรักษา



1. วัตถุประสงค์

คู่มือการปฏิบัติการและติดต่อประสานงานฉบับนี้ จัดทำขึ้นเพื่อใช้เป็นแนวทางในการปฏิบัติงานบำรุงรักษาอุปกรณ์ภายในสถานีควบคุมความดันและวัดปริมาตรก๊าซ และการติดต่อประสานงานระหว่างส่วนปฏิบัติการระบบท่อเขต 3 บริษัท ปตท. จำกัด (มหาชน) กับ บริษัทลูกค้าก๊าซบริษัท ปตท. จำกัด (มหาชน)



2. ขั้นตอนการปฏิบัติงานในสถานีควบคุมความดันและวัดปริมาตรก๊าซ

2.1 การปฏิบัติงานที่เกี่ยวข้องกับระบบท่อส่งก๊าซ และ สถานีควบคุมและวัดปริมาตรก๊าซ ประกอบด้วย

2.1.1 งานบำรุงรักษาประจำ (Preventive Maintenance)

- งานสอบเทียบอุปกรณ์ Flow Computer และ Transmitter ทุก 3 เดือน



- งานสอบเทียบอุปกรณ์ Gas Turbine Meter ทุก 3 ปี



2.1.2 งานบำรุงรักษาตามสภาพ

-งาน Corrective Maintenance

-งานตาม Work Request

ในกรณีงานบำรุงรักษาตามสภาพ เมื่อได้รับการตรวจสอบจากบริษัทลูกค้าก๊าซ หรือ ปตท. แล้วพบว่าอุปกรณ์ขัดข้อง หรือ สงสัยว่าอุปกรณ์ชำรุดหรือทำงานผิดพลาด บริษัทลูกค้าก๊าซ หรือ ปตท. จะต้องดำเนินการแจ้งให้ บริษัทลูกค้าก๊าซ หรือ ปตท. ทราบ ก่อนเข้าดำเนินการ เพื่อประโยชน์ต่อทั้งสองฝ่าย และ เมื่อดำเนินการแล้วเสร็จจะต้องจัดทำเอกสารรายงานผลการดำเนินการแก้ไขและต้องมีผลเป็นที่ยอมรับทั้งสองฝ่ายด้วย

ในกรณีที่มีจำเป็นเนื่องจากเหตุฉุกเฉินที่ต้องแก้ไขทันทีเพื่อความปลอดภัยระบบท่อส่งก๊าซ และสถานีควบคุมความดันและวัดปริมาตรก๊าซ บริษัทลูกค้าน้ำ หรือ ปตท. สามารถเข้าดำเนินการแก้ไขได้ทันที แต่อย่างไรก็ตาม บริษัทลูกค้าน้ำ หรือ ปตท. จะต้องแจ้งรายละเอียดของการดำเนินการให้ทราบภายหลังทันที หลังจากเข้าสู่สภาวะปกติ



2.2 ขั้นตอนในการเข้าดำเนินการ



* การปฏิบัติงานใด ๆ ต้องปฏิบัติตามกฎความปลอดภัยของพื้นที่


* ขั้นตอนการปฏิบัติงานต้องได้รับความเห็นชอบจากทั้งสองฝ่าย

3. ความรับผิดชอบในการปฏิบัติงานบำรุงรักษา

ปตท. จะปฏิบัติงานบำรุงรักษาอุปกรณ์ภายในสถานีควบคุมความดันและวัดปริมาตรก๊าซ เพื่อให้อุปกรณ์อยู่ในสภาพดีเป็นไปตามมาตรฐานที่ได้ระบุไว้ รวมทั้งอยู่ในข้อกำหนดของสัญญาซื้อขายก๊าซ ในกรณีที่ตรวจสอบว่าอุปกรณ์เกิดการชำรุด หรือมีแนวโน้มคลาดเคลื่อน ปตท. หรือ บริษัทลูกค้าน้ำ สามารถร้องขอเข้าดำเนินการแก้ไขหรือสอบเทียบให้อุปกรณ์สามารถทำงานได้ดังเดิม โดย ปตท. หรือ บริษัทลูกค้าน้ำ สามารถเข้าตรวจสอบและแก้ไขได้ตลอด 24 ชั่วโมง

ในกรณีที่อุปกรณ์เกิดการขัดข้อง และจำเป็นจะต้องเปลี่ยนอะไหล่ (Spare Part) ปตท. จะทำการเบิกอะไหล่จากบริษัทลูกค้าน้ำ เพื่อใช้งาน (ถ้ามี) หรือในกรณีที่ ปตท. ต้องดำเนินการจัดซื้ออะไหล่ บริษัทลูกค้าน้ำ จะต้องเป็นผู้ออกค่าใช้จ่ายในอะไหล่ที่เปลี่ยนนั้นทั้งสิ้น เมื่อ ปตท. มีการเรียกเก็บมาภายหลัง




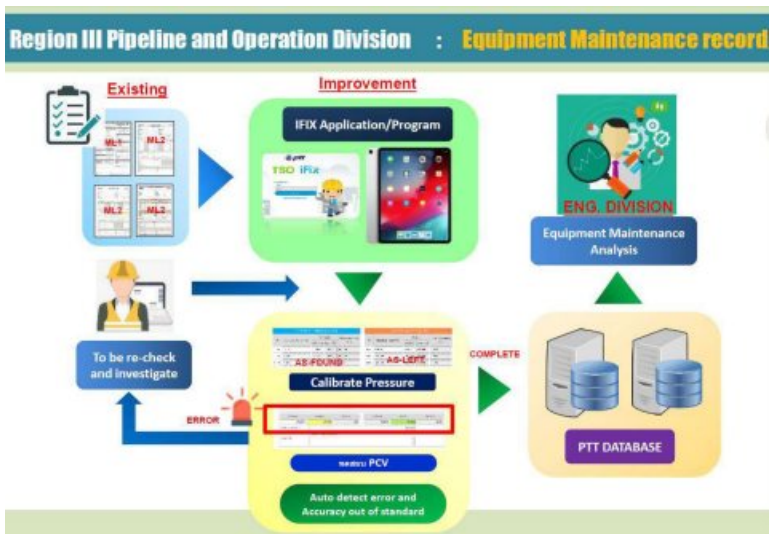

ระบบ IFIX คือระบบที่ปรับปรุงระบบ Maintenance Record DATA ให้เป็นระบบ DIGITAL ผ่านอุปกรณ์ IPAD เพื่อลดการใช้แบบฟอร์ม ML1 ,ML2 ,ML3 ที่เป็นกระดาษ และใช้ระบบ Gas QR ที่เป็นการบันทึกข้อมูลปริมาณการใช้ก๊าซสำหรับตัดยอดก๊าซ เพื่อให้ง่ายต่อการตรวจสอบข้อมูลและป้องกันเอกสารสูญหาย เนื่องจากอยู่ในระบบ DATA BASE ของปตท. พร้อมทั้งแจ้งเตือนผู้ปฏิบัติงานให้เฝ้าระวัง ในกรณีที่แตกต่างกันการบำรุงรักษา มีแนวโน้มที่จะเกิดความผิดปกติ (Auto Detect Error) และส่งข้อมูลไปยังหน่วยงานวิศวกรรมเพื่อใช้ในการวิเคราะห์ข้อมูลในอนาคต

4. การติดต่อประสานงาน

4.1 ผู้โครงสร้างส่วนปฏิบัติการระบบท่อเขต 3 บริษัท ปตท. จำกัด (มหาชน)

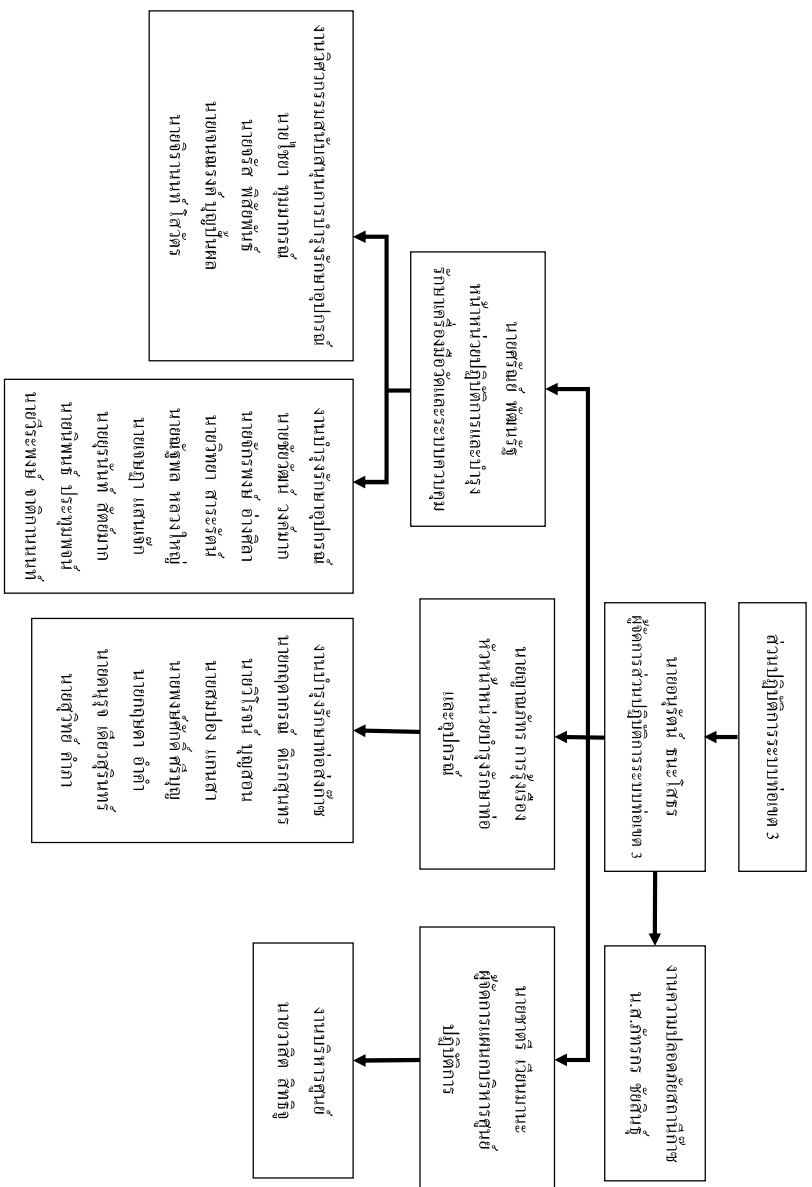

4.2 หมายเลขโทรศัพท์ติดต่อประสานงาน และแจ้งเหตุ

4.2.1 ส่วนปฏิบัติการระบบท่อเขต 3

ที่ตั้ง

เลขที่ 555/6 ถ.สุขุมวิท ต.ห้วยโป่ง อ.เมือง จ.ระยอง 21150

โทรศัพท์ติดต่อและช่องทางการติดต่อประสานงาน

- อุบัติการณ์ตลอด 24 ชั่วโมง

พนักงาน Stand-By ส่วนปฏิบัติการระบบท่อเขต 3

หมายเลข


PTT Call Center :

ศูนย์ควบคุมระบบท่อส่งก๊าซ (Gas Control): ชลบุรี


4.3 ขั้นตอนการติดต่อประสานงาน

4.3.1 กรณีพบเหตุการณ์อุปกรณ์ชำรุด

กรณีพบเหตุการณ์อุปกรณ์ชำรุด
ซึ่งอาจจะก่อให้เกิดผลกระทบต่อการส่งก๊าซให้กับโรงงาน

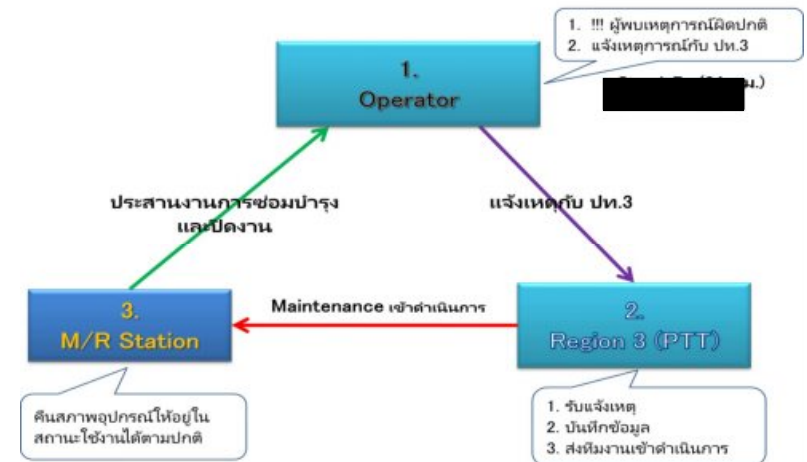

4.3.2 กรณีฉุกเฉินโรงงาน Trip ทุก Unit

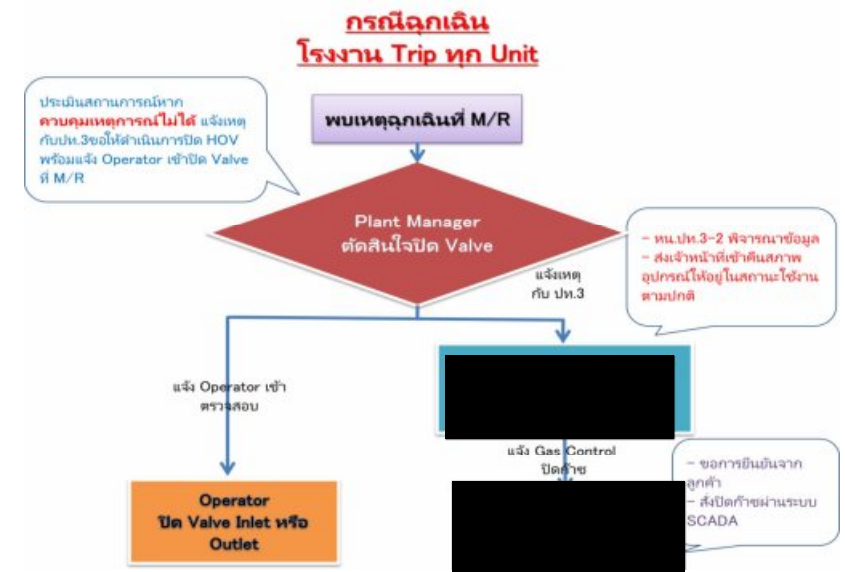

5. แบบฟอร์มที่ใช้ในงานบำรุงรักษาและติดต่อประสานงาน

5.1 MAINTENANCE LEVEL1(ML1)

เป็นเอกสารบันทึกตรวจสอบสภาพสถานี สภาพท่อและอุปกรณ์ทั่วไป แรงดันและอุณหภูมิ สถานะการทำงานของอุปกรณ์ ที่สถานีวัดปริมาตรก๊าซ โดยทาง ปตท. จะเข้าดำเนินการตรวจสอบเป็นประจำ ทุกเดือนการปฏิบัติงานทั้งหมดจะกระทำโดย ปตท. และ บริษัทลูกก๊าซ จะเป็นผู้ร่วมสังเกตการณ์เมื่อเสร็จสิ้นการปฏิบัติงานจะต้องลงชื่อในท้ายแบบฟอร์มร่วมกัน และเก็บเอกสารไว้ เป็นหลักฐานฝ่ายละ 1 ฉบับ

5.2 MAINTENANCE LEVEL2(ML2)และแบบฟอร์มบันทึกผลการปรับแต่งอุปกรณ์

เป็นเอกสารบันทึกการบำรุงรักษาสถานีวัดปริมาตรก๊าซ(ML2) รวมถึงอุปกรณ์ภายในสถานี ก๊าซ ได้แก่ PCV,PSV,SSV และอุปกรณ์อื่นๆ ส่วนอีกแบบหนึ่งเป็นแบบฟอร์มที่ใช้สำหรับบันทึกผลการ ทดสอบและปรับแต่งอุปกรณ์วัดปริมาตรก๊าซ โดยการปฏิบัติงานทั้งหมดจะกระทำโดย ปตท. และ บริษัท ลูกก๊าซ จะเป็นผู้ร่วมสังเกตการณ์เมื่อเสร็จสิ้นการปฏิบัติงานจะต้องลงชื่อในท้ายแบบฟอร์มร่วมกัน และ เก็บเอกสารไว้ เป็นหลักฐานฝ่ายละ 1 ฉบับ

5.3 เอกสารอื่นๆ

5.3.1 ใบแจ้งปริมาณการใช้ก๊าซ

ใช้การ print out current report สำหรับจดค่าปริมาณการใช้ก๊าซในเดือนที่ผ่านมาเป็น ประจำเดือน ซึ่งจะต้องจดค่าทั้ง 2 RUN โดยปตท. และ บริษัทลูกก๊าซ จะต้องลงชื่อในท้ายแบบฟอร์ม ร่วมกัน และเก็บเอกสารนี้ไว้เป็น หลักฐานฝ่ายละ 1 ฉบับ


5.3.2 INSPECTION SHEET

ขอให้ระบุค่า Index Turbine ลงใน Daily Report จาก Flow Computer ทุกเที่ยงคืน โดยทาง ปตท. จะขอให้บริษัทลูกช่วยจดบันทึกค่า Index Turbine ข้างต้นเป็นประจำทุกวัน

แบบฟอร์ม 5.1

F-รณ.วรด.-010) ประกาศใช้ครั้งที่ 2

F-รณ.วธค.-0101 ประกาศใช้ครั้งที่ 2

		แบบฟอร์มตรวจสอบ M/R Station สำหรับระบบท่อส่งก๊าซธรรมชาติ				ML1			
Work Order No.:		120728444							
Tag name.:		TSO-SCSC_2				Work Permit:			
Division/Region:		ผบ.3-2				Working Date:		29 Sep 2021	
Site/Customer:		TSO-SCSC_2				Type of Station:		NGR	
Create Date:		27 Oct 2021				Create by:		NATTAPON LUANGHAI	

h. การทำงานของ เครื่องวัดการไหลของก๊าซ ☐ ไม่ดี

รายการที่ตรวจสอบ	Alarm		Flow Meter		Leak		Pressure Gauge		Calibration Gas Pressure (psi)		อธิบายสภาพ
	ดี	ไม่ดี	ปรับ	ปกติ	ดี	ไม่ดี	ปรับ	ปกติ	No.1	No.2	
<input type="checkbox"/> Probe											
<input type="checkbox"/> OMA											
<input type="checkbox"/> BTU											

i. การทำงานของ อุปกรณ์ไฟฟ้า

- MDB : 0.8 @ ไม่ดี

1 Ph โวลต์ 230 +/- 10% 3 Ph โวลต์ 400 +/- 10%

Phase	1Ph	L-N	L-L	R-S	S-S	T-R
Main AC Voltage (V)						
Main AC Current(A)						
Automatic Transfer Switch						
สถานะการทำงานของ						
สถานะของตู้ควบคุม Flow Computer, RTU, ฯลฯ						
Air conditioner ยกเว้นตู้ควบคุม ไม่ดี/ปกติ						
Charger / UPS :						

Charger / UPS	Source Alarm	Output Alarm	Battery	Oxide หรือ Belt	อธิบายสภาพ
<input type="checkbox"/> Charger#1					
<input type="checkbox"/> Charger#2					
<input type="checkbox"/> UPS#1					
<input type="checkbox"/> UPS#2					

Representative Signature

Name-Surname	Signature	Date

		แบบฟอร์มตรวจสอบ M/R Station สำหรับระบบท่อส่งก๊าซธรรมชาติ				ML1			
Work Order No.:		120728444							
Tag name.:		TSO-SCSC_2				Work Permit:			
Division/Region:		ผบ.3-2				Working Date:		29 Sep 2021	
Site/Customer:		TSO-SCSC_2				Type of Station:		NGR	
Create Date:		27 Oct 2021				Create by:		NATTAPON LUANGHAI	

j. สภาพทั่วไปของ อุปกรณ์อื่นๆในสถานี

รายการที่ตรวจสอบ	ปกติ	ชำรุด	ไม่มี	อธิบายสภาพ
1. Gauge ภายในสถานีที่ดูแล (แสดงค่าถูกส่ง, ไม่แสดง, ไม่แสดง)				
2. HV ภายในสถานีที่ดูแล (สถานะถูกส่ง, ไม่มีค่ารับเข้า)				
3. HCV/MCV/PCV ภายในสถานีที่ดูแล (สถานะถูกส่ง, ไม่มีค่ารับเข้า, ไม่มี Alarm)				
4. Control Valve ภายในสถานีที่ดูแล (สถานะถูกส่ง, ไม่มีค่ารับเข้า)				
5. PT/TT/POT ภายในสถานีที่ดูแล (สถานะถูกส่ง, ไม่มีค่ารับเข้า)				
6. Level Indicator ภายในสถานีที่ดูแล (สถานะถูกส่ง, ไม่มีค่ารับเข้า)				
7. Kirk Cell / SSD (สถานะถูกส่ง, ไม่มีค่ารับเข้า)				

Comment

-

Representative Signature

Signature	Date

แบบฟอร์ม 5.2

	บริษัท การปิโตรเลียมแห่งประเทศไทย Pressure Regulator and Safety Device		ML2
	ส่วน Gas Metering and Regulating Station/Gate Station		
	สาขาการควบคุมและรักษาความปลอดภัย		
Work Order No.:	120728302	Date:	27 Oct 2021
Site:	TSO-GPSC3	Region:	ปท.3-2
Work Permit:		Unit:	psig

***Pressure Regulator Test: Max. Error $\pm 2\%$ of Set Point**

Tag No.	Set Point	As-found	%Error	As-Left	%Error	Lock up pressure	Result*
TSO-GPSC3-0330-PCV-S01A	0.0000	0.0000	0.0000	--	--		Fail

Reference Equipment

Equipment Name	Manufacturer	Model	S/N.	Calibration Date
--	--	--	--	--

***Pressure Shut off Valve Test: Max. Error $\pm 1\%$ of Set Point**

Tag No.	Set Point	As-found	%Error	As-Left	%Error	Result*
TSO-GPSC3-0330-SSV-S01A	0.0000	0.0000	0.0000	--	--	Fail

Reference Equipment

Equipment Name	Manufacturer	Model	S/N.	Calibration Date
--	--	--	--	--

***Pressure Relief Valve Test: Max. Error ± 3 psig @ Pr. ≤ 70 psig and $\pm 3\%$ @ Pr. > 70 psig**

Tag No.	Set Point	As-found	%Error	As-Left	%Error	Result*
TSO-GPSC3-0330-PSV-S01A	0.0000	0.0000	0.0000	--	--	Fail
TSO-GPSC3-0330-PSV-S01B	0.0000	0.0000	0.0000	--	--	Fail

Reference Equipment


Equipment Name	Manufacturer	Model	S/N.	Calibration Date
--	--	--	--	--


Note

Representative Signature

Name-Surname	Signature	Date
--------------	-----------	------



		Grounding Resistance		ML2	
Division/Region:		Unit 3-2		Grounding System : Single Ground	
Site/Customer:		TSO-GNLL2		Test Equipment :	
Type of Station:		GSM		S/N :	
Resistance Test					
Single Ground					
(1) Single Ground		=		< 5 * R	
Condition: <input type="radio"/> GOOD <input type="radio"/> BAD		Comment:		<input type="radio"/> PASS <input type="radio"/> FAIL	
* หากพบค่า : ค่าแรงดันตก Ex : 100V Zener Diode (100V) หรือ 100V Instrument Ground < 1 Ω					
Station Loop Test					
From		To		Result (Ω)	
Ground rod	Elect. Ground bar	Ground rod	MDR	<input type="checkbox"/> N/A	
Ground rod	Int. Ground bar	Ground rod	RTU	<input type="checkbox"/> N/A	
Ground rod	Lighting system	Ground rod	Handing	<input type="checkbox"/> N/A	
Ground rod	Int. Gas pipeline	Ground rod	Handing	<input type="checkbox"/> N/A	
Ground rod	Transformer				
Ground rod	30V PCV				
Ground rod	Battery / Solar				
Ground rod	Other				
หมายเหตุ 3 Ω ไม่ผ่านเกณฑ์ 10.0					
Note :					
Note N/A:					
Inspector					
By: CHAKAPONG ANGILA		Date of Inspection: 27 Oct 2021			

		PRESSURE CALIBRATION REPORT		ML2	
		FLOW COMPUTER-TRANSMITTER LOOP MEASUREMENT			
		NATURAL GAS TRANSMISSION			
Work Order No.:		120687835		Division/Region:	
Work Permit:		21-HT-6487		Customer Type:	
Manufacturer:		Rosemount		Site/Customer:	
Model:		305151TG		F/C Tag No.:	
Serial No.:		3566111		Tag No.:	
Accuracy:		± 0.0750 % of full scale		Pressure Range:	
Date of Calibration:		23 Apr 2021		Receiver:	
				Output:	
				<input checked="" type="checkbox"/> Hart <input type="checkbox"/> 4-20 mA <input type="checkbox"/> Field bus	
				<input type="checkbox"/> barg <input type="checkbox"/> psig <input type="checkbox"/> MBar	

Test Result

Pressure Input		As Found			As Left		
%	barg	Current(mA)	Flow Computer Reading (RTU)	Error % of full scale	Current(mA)	Flow Computer Reading (RTU)	Error % of full scale
0%	0.0000	0.0000	12.40	-0.0000	-	-	-
25%	12.5000	0.0000	24.99	-0.0000	-	-	-
50%	25.0000	0.0000	24.99	-0.0000	-	-	-
75%	37.5000	0.0000	24.99	-0.0000	-	-	-
100%	50.0000	0.0000	24.99	-0.0000	-	-	-
75%	37.5000	0.0000	24.99	-0.0000	-	-	-
50%	25.0000	0.0000	24.99	-0.0000	-	-	-
25%	12.5000	0.0000	24.99	-0.0000	-	-	-
0%	0.0000	0.0000	24.99	-0.0000	-	-	-

Calibration Result:
Comment:

Test Equipment

Equipment Name:	TSO-TEQR3-0330-DWP-018		
Manufacturer:	Boamex	Model:	MC6-EX
Serial No:	602481/52666/53002	Calibration Date:	23 Dec 2020 - 23 Dec 2021

Representative Signature

Name-Surname	Signature	Date

TEMPERATURE CALIBRATION REPORT				ML2
FLOW COMPUTER-TRANSMITTER LOOP MEASUREMENT				
NATURAL GAS TRANSMISSION				
Work Order No.:	12068/7835	Division/Region:	dn.3-2	
Work Permit:	21-HT-6487	Customer Type:	SPP	
Manufacturer:	Rosemount	Site/Customer:	TSD-GNLL2	
Model:	3144P	F/C Tag No.:	5602-FY-0287A	
Serial No.:	3571127	Tag No.:	TSD-GNLL2-5602-TT-0207A	
Accuracy:	± 0.2000 % of full scale	Temperature Range:	Min: 0.0000 Max: 50.0000	
Date of Calibration:	23 Apr 2021	Receiver:	RTU	
		Output:	<input checked="" type="checkbox"/> Hart <input type="checkbox"/> 4-20 mA <input type="checkbox"/> Field bus <input type="checkbox"/> 0 °C <input type="checkbox"/> 9 °C	

Test Result

Standard Temperature		As Found		As Left	
%	Ohms	°C	Flow Computer Reading (RTU)	Error % of full scale	Flow Computer Reading (RTU)
0%	100.0000	0.0000	0.0600	0.0000	0.0640
25%	104.8770	12.5000	12.5610	0.0000	12.5610
50%	109.7350	25.0000	25.0620	0.0000	25.0620
75%	114.5750	37.5000	37.5630	0.0000	37.5630
100%	119.3970	50.0000	50.0640	0.0000	50.0640
Calibration Result:					
Comment:					
One Point Check (RTU Loop Test with RTU)					
Standard Temperature	°C	Flow Computer Reading	°C	Error	Maximum Allow Error °C
RTU	0.0000	0.0600	0.0640	0.0000	±0.35
Calibration Result:					
Turbine Index:					
Comment:					

Test Equipment

Equipment Name:	TEQ-DCB-003	Model:	279301
Manufacturer:	Yokogawa	Calibration Date:	28 May 2020 - 28 May 2021
Serial No.:	60VX0030		

Test Equipment Standard Thermometer


Equipment Name:	TSD-TEQJ3-0330-DGT-009	Model:	1524
Manufacturer:	Fuke	Calibration Date:	16 Feb 2021 - 16 Feb 2022
Serial No.:	9920064		

Representative Signature

Name-Surname	Signature	Date
--------------	-----------	------

Hydraulic Operate Valve (HOV)		ML2
Unit: TSD-GNLL2-5602-HOV-0207A		
Work Order No.:	120723027	Date of Calibration:
Work Permit:	TSD-GNLL2	Customer Type:
Site/Customer:	TSD-GNLL2	Division/Region:
Tag No.:	TSD-GNLL2-5602-HOV-0207A	Manufacturer:
Model:		S/N:
1. Valve Actuator & Body		
1.1 Valve Actuator		
Clearing:	<input type="checkbox"/> Clean Filter <input type="checkbox"/> Dirty/Choke <input type="checkbox"/> Normal	<input type="checkbox"/> Abnormal
1.2 Valve Body		
Lubricant:	<input type="checkbox"/> Top up Valve Lubricant <input type="checkbox"/> N/A	
*Remarks:		
- install/replace Top up Valve Lubricant when necessary		
2. Stroke & Functional Test		
Test Method:	<input type="checkbox"/> Full Loop Test <input type="checkbox"/> Dry Test & Partial Stroke Test	
*Remarks:		
- install/replace/adjust Full Loop Test when necessary		
Line Pressure:	<input type="checkbox"/> Pig <input type="checkbox"/> Gas Supply Pressure	<input type="checkbox"/> Pig
2.1 Manual Operate (Local)		
<input type="checkbox"/> Open to Close <input type="checkbox"/> Close to Open	Command (S) Status (S)	Condition Normal Abnormal
*Remarks:		
- install/replace/adjust when necessary		
- replace/adjust when necessary		
- install/replace/adjust when necessary		
Representative Signature		
PTT:	CHAKPONG ANGSA	Date:
Approved:	CHAYA TOOPHONGSIN	Date:

Hydraulic Operate Valve (HOV)		ML2
Unit: TSD-GNLL2-5602-HOV-0207A		
Work Order No.:	120723027	Date of Calibration:
Work Permit:	TSD-GNLL2	Customer Type:
Site/Customer:	TSD-GNLL2	Division/Region:
Tag No.:	TSD-GNLL2-5602-HOV-0207A	Manufacturer:
Model:		S/N:
2.2 Remote Operate		
<input type="checkbox"/> Open to Close <input type="checkbox"/> Close to Open	Command (S) Status (S)	Condition Normal Abnormal
*Remarks:		
- install/replace/adjust when necessary		
- replace/adjust when necessary		
- install/replace/adjust when necessary		
2.3 Local Hand Pump		
<input type="checkbox"/> Open to Close <input type="checkbox"/> Close to Open	Stroke (S) Status (S)	Condition Normal Abnormal
*Remarks:		
- install/replace/adjust when necessary		
- Open to Close full stroke when necessary		
- Close to Open full stroke when necessary		
2.4 Valve Status		
- install/replace/adjust when necessary		
- Limit Switch and Valve Status Open		
- Limit Switch and Valve Status Close		
3. Pressure Alarm Switch Test		
Set Point	As-found	Reset Pressure
Pressure Switch Low (Pig)		
Normally Close ± 3%		
4. Line Break Control		
Representative Signature		
PTT:	CHAKPONG ANGSA	Date:
Approved:	CHAYA TOOPHONGSIN	Date:

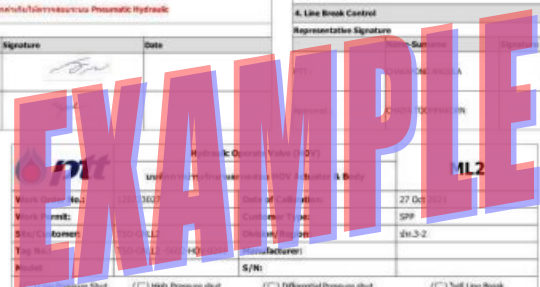

ภาคผนวก ข-6

สำเนาหนังสือแจ้งรายละเอียดแนวท่อที่ดำเนินการจริง
ต่อหน่วยงานเจ้าของพื้นที่ที่แนวท่อพาดผ่าน

หนังสือแจ้งผลการพิจารณาให้ความเห็นชอบทิศทางและแนวเขต
ในการวางระบบโครงข่ายก๊าซฯ ต่อหน่วยงานเจ้าของพื้นที่

ที่ 086/2565

วันที่ 22 สิงหาคม 2565

เรื่อง แจ้งผลการพิจารณาให้ความเห็นชอบทิศทางและแนวเขตในการวางระบบโครงข่ายก๊าซธรรมชาติโครงการ
วางท่อส่งก๊าซธรรมชาติไปยังโรงไฟฟ้าเอ็กโก โควเจน (ส่วนขยาย ครั้งที่1) ของบริษัท เอ็กโก โควเจนเน-
อเรชั่น จำกัด

เรียน นายกเทศบาลตำบลมาบตาพุดพัฒนา

อ้างถึง หนังสือขออนุญาตใช้พื้นที่วางท่อส่งก๊าซธรรมชาติไปยังโรงไฟฟ้าเอ็กโก โควเจน (ส่วนขยาย ครั้งที่1)

ที่ [REDACTED] ลง ณ วันที่ 21 เมษายน 2565

สิ่งที่ส่งมาด้วย 1. หนังสือแจ้งผลการพิจารณาให้ความเห็นชอบทิศทางและแนวเขตในการวางระบบโครงข่ายก๊าซ
ธรรมชาติ ที่ [REDACTED] ลง ณ วันที่ 9 สิงหาคม 2565 จำนวน 5 แผ่น

ตามที่ บริษัท เอ็กโก โควเจนเนอเรชั่น จำกัด (“บริษัทฯ”) ได้ขอความเห็นชอบทิศทางและแนวเขตในการ
วางระบบโครงข่ายก๊าซธรรมชาติ โครงการวางท่อส่งก๊าซธรรมชาติไปยังโรงไฟฟ้าเอ็กโก โควเจน (ส่วนขยาย ครั้งที่1)
ต่อคณะกรรมการกำกับกิจการพลังงาน (กกพ.) เพื่อให้เป็นไปตามบทบัญญัติการประกอบกิจการพลังงาน พ.ศ.
2550 นั้น

บัดนี้ บริษัทฯ ได้รับการพิจารณาเห็นชอบทิศทางและแนวเขตในการวางระบบโครงข่ายก๊าซธรรมชาติ
โครงการวางท่อส่งก๊าซธรรมชาติไปยังโรงไฟฟ้าเอ็กโก โควเจน (ส่วนขยาย ครั้งที่1) โดยมีวัตถุประสงค์เพื่อนำก๊าซ
ธรรมชาติมาใช้เป็นเชื้อเพลิงในกระบวนการผลิตไฟฟ้าให้แก่โรงไฟฟ้าเอ็กโก โควเจน ซึ่งตั้งอยู่ในตำบลมาบตา อำเภอนิคมพัฒนา จังหวัดระยอง (รายละเอียดตามเอกสารแนบหมายเลข 1)

จึงเรียนมาเพื่อโปรดทราบ

ขอแสดงความนับถือ

[REDACTED]

ผู้จัดการโครงการโรงไฟฟ้าเอ็กโก โควเจนเนอเรชั่น (ส่วนขยาย)

บริษัท เอ็กโก โควเจนเนอเรชั่น จำกัด

[REDACTED]

ที่ 087/2565

วันที่ 22 สิงหาคม 2565

เรื่อง แจ้งผลการพิจารณาให้ความเห็นชอบทิศทางและแนวเขตในการวางระบบโครงข่ายก๊าซธรรมชาติโครงการ
วางท่อส่งก๊าซธรรมชาติไปยังโรงไฟฟ้าเอ็กโก โคเจน (ส่วนขยาย ครั้งที่1) ของบริษัท เอ็กโก โคเจนเนอ-
เรชั่น จำกัด

เรียน ผู้ช่วยกรรมการผู้จัดการใหญ่ระบบท่อส่งก๊าซธรรมชาติบริษัท ปตท. จำกัด (มหาชน)

อ้างถึง หนังสืออนุญาตให้บริษัท เอ็กโก โคเจนเนอเรชั่น จำกัด ก่อสร้างวางท่อส่งก๊าซธรรมชาติ ที่ สกพ
[REDACTED] ลง ณ วันที่ 3 พฤษภาคม 2565

สิ่งที่ส่งมาด้วย 1. หนังสือแจ้งผลการพิจารณาให้ความเห็นชอบทิศทางและแนวเขตในการวางระบบโครงข่ายก๊าซ
ธรรมชาติ [REDACTED] ลง ณ วันที่ 9 สิงหาคม 2565 จำนวน 5 แผ่น

ตามที่ บริษัท เอ็กโก โคเจนเนอเรชั่น จำกัด (“บริษัทฯ”) ได้ขอความเห็นชอบทิศทางและแนวเขตในการ
วางระบบโครงข่ายก๊าซธรรมชาติ โครงการวางท่อส่งก๊าซธรรมชาติไปยังโรงไฟฟ้าเอ็กโก โคเจน (ส่วนขยาย ครั้งที่1)
ต่อคณะกรรมการกำกับกิจการพลังงาน (กกพ.) เพื่อให้เป็นไปตามบทบัญญัติการประกอบกิจการพลังงาน พ.ศ.
2550 นั้น

บัดนี้ บริษัทฯ ได้รับการพิจารณาเห็นชอบทิศทางและแนวเขตในการวางระบบโครงข่ายก๊าซธรรมชาติ
โครงการวางท่อส่งก๊าซธรรมชาติไปยังโรงไฟฟ้าเอ็กโก โคเจน (ส่วนขยาย ครั้งที่1) โดยมีวัตถุประสงค์เพื่อนำก๊าซ
ธรรมชาติมาใช้เป็นเชื้อเพลิงในกระบวนการผลิตไฟฟ้าให้แก่โรงไฟฟ้าเอ็กโก โคเจน ที่ตั้งอยู่ในตำบลมาบข่า อำเภอนิคมพัฒนา จังหวัดระยอง (รายละเอียดตามเอกสารแนบหมายเลข 1)


จึงเรียนมาเพื่อโปรดทราบ

ขอแสดงความนับถือ

[REDACTED]
ผู้จัดการโครงการโรงไฟฟ้าเอ็กโก โคเจนเนอเรชั่น (ส่วนขยาย)
บริษัท เอ็กโก โคเจนเนอเรชั่น จำกัด





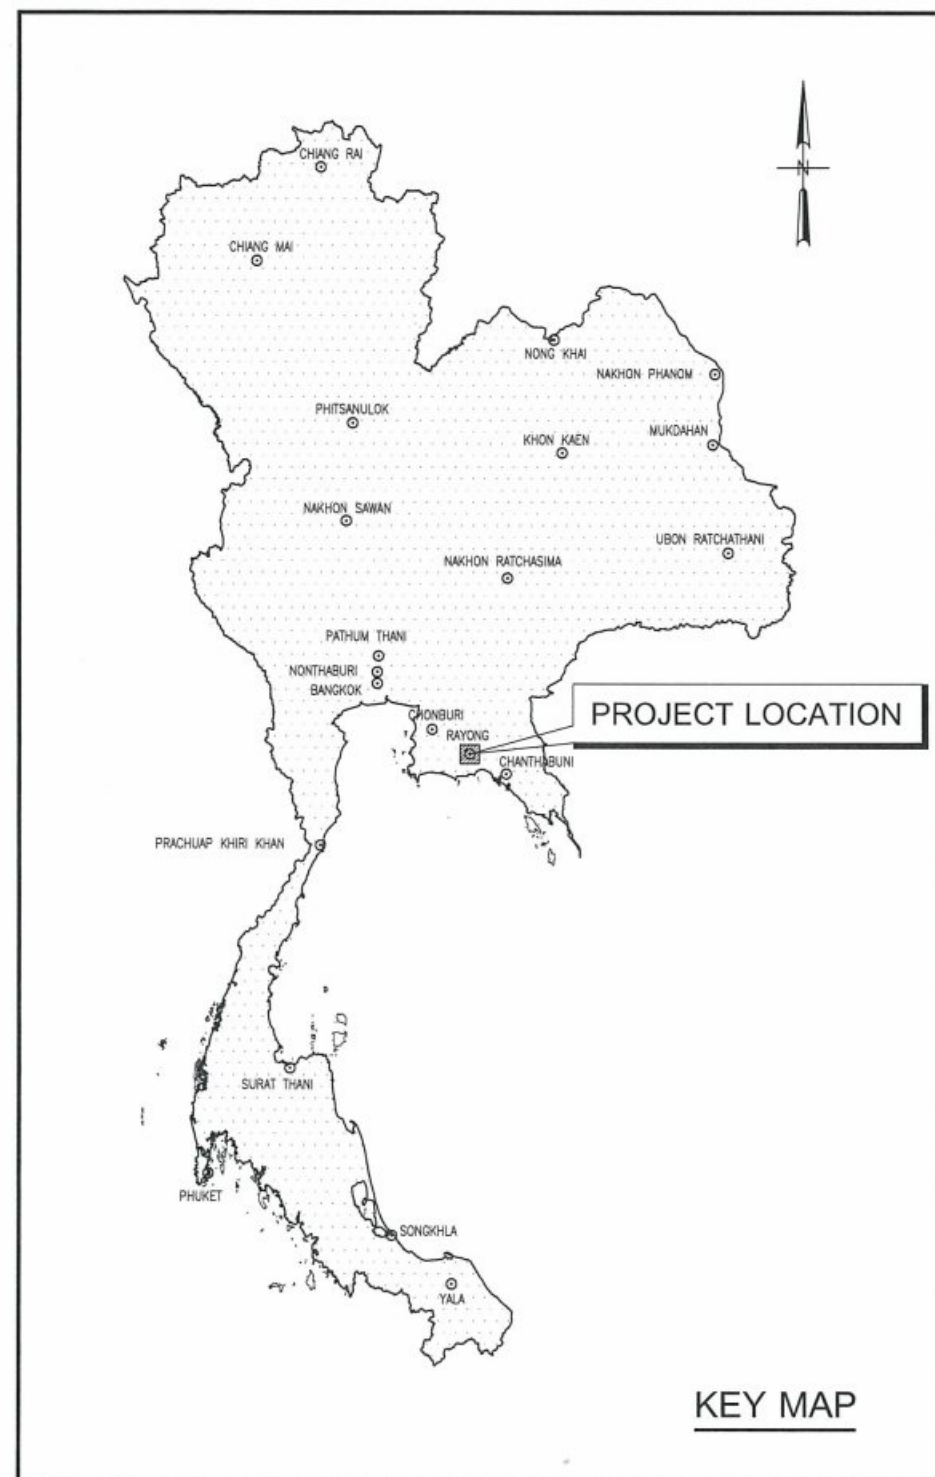


แผนที่แสดงตำแหน่งแนวท่อที่ดำเนินการจริง





Ø 8 GAS PIPELINE
APPROXIMATELY PIPELINE LENGTH 1,359 M.

TIE-IN POINT EXISTING PTT BLOCK VALVE 4.1 STATION
E : 739,145 N : 1414,716



AS-BUILT

REFERENCE DRAWINGS			GENERAL NOTES : <div><div><div><div><div></div><div>REVIEW STAMP</div><div>PROJECT NO.: 2006.10</div></div><div><input type="checkbox"/> E : Work may proceed.</div><div><input type="checkbox"/> F : Work may proceed, Submit Final Document / Drawing.</div><div><input type="checkbox"/> G : Revise and Resubmit, Work may proceed subject to Incorporation of changes indicated.</div><div><input type="checkbox"/> H : Revise and Resubmit, Work may not proceed.</div><div><input type="checkbox"/> I : Review not required, Work may proceed.</div></div><div>Acceptance in any of these categories shall in no way relieve the Contractor / Supplier of its responsibility for</div></div></div>	PROJECT ADVISOR : <div> PTT Public Company Limited</div>										PROJECT :																																																																																																																																																																																																																																																																																																																																																																																																																																																																																																																																																																																																																																																																																																																																																																																																																																																																																																																																																																																																																																																																																																																																																																																																																																																																																																																																									
NO.	DRAWING NO.	TITLE		CLIENT : <div> EGCO COGENERATION COMPANY LIMITED</div>										TITLE :																																																																																																																																																																																																																																																																																																																																																																																																																																																																																																																																																																																																																																																																																																																																																																																																																																																																																																																																																																																																																																																																																																																																																																																																																																																																																																																																									
				AGENT : <div> UNITY ENGINEERING AND CONSULTANCY SERVICES CO., LTD.</div>										PROJECT LOCATION PLAN																																																																																																																																																																																																																																																																																																																																																																																																																																																																																																																																																																																																																																																																																																																																																																																																																																																																																																																																																																																																																																																																																																																																																																																																																																																																																																																																									
				CONTRACTOR : <div> TRC CONSTRUCTION PUBLIC COMPANY LIMITED</div>										DWG. NO.																																																																																																																																																																																																																																																																																																																																																																																																																																																																																																																																																																																																																																																																																																																																																																																																																																																																																																																																																																																																																																																																																																																																																																																																																																																																																																																																									
																																																																																																																																																																																																																																																																																																																																																																																																																																																																																																																																																																																																																																																																																																																																																																																																																																																																																																																																																																																																																																																																																																																																																																																																																																																																																																																																																							</

OWNERSHIP	TESSABANWAKHA	RD.	TESSABANWAKHA	EGCO COGENERATION POWER PLANT
JURISDICTION			T.MAP KHA, KING AMPHIE NIKOM PATTANA, RAYONG PROVINCE	
LAND USE	OPEN AREA	CHANNEL	OPEN AREA	OPEN AREA

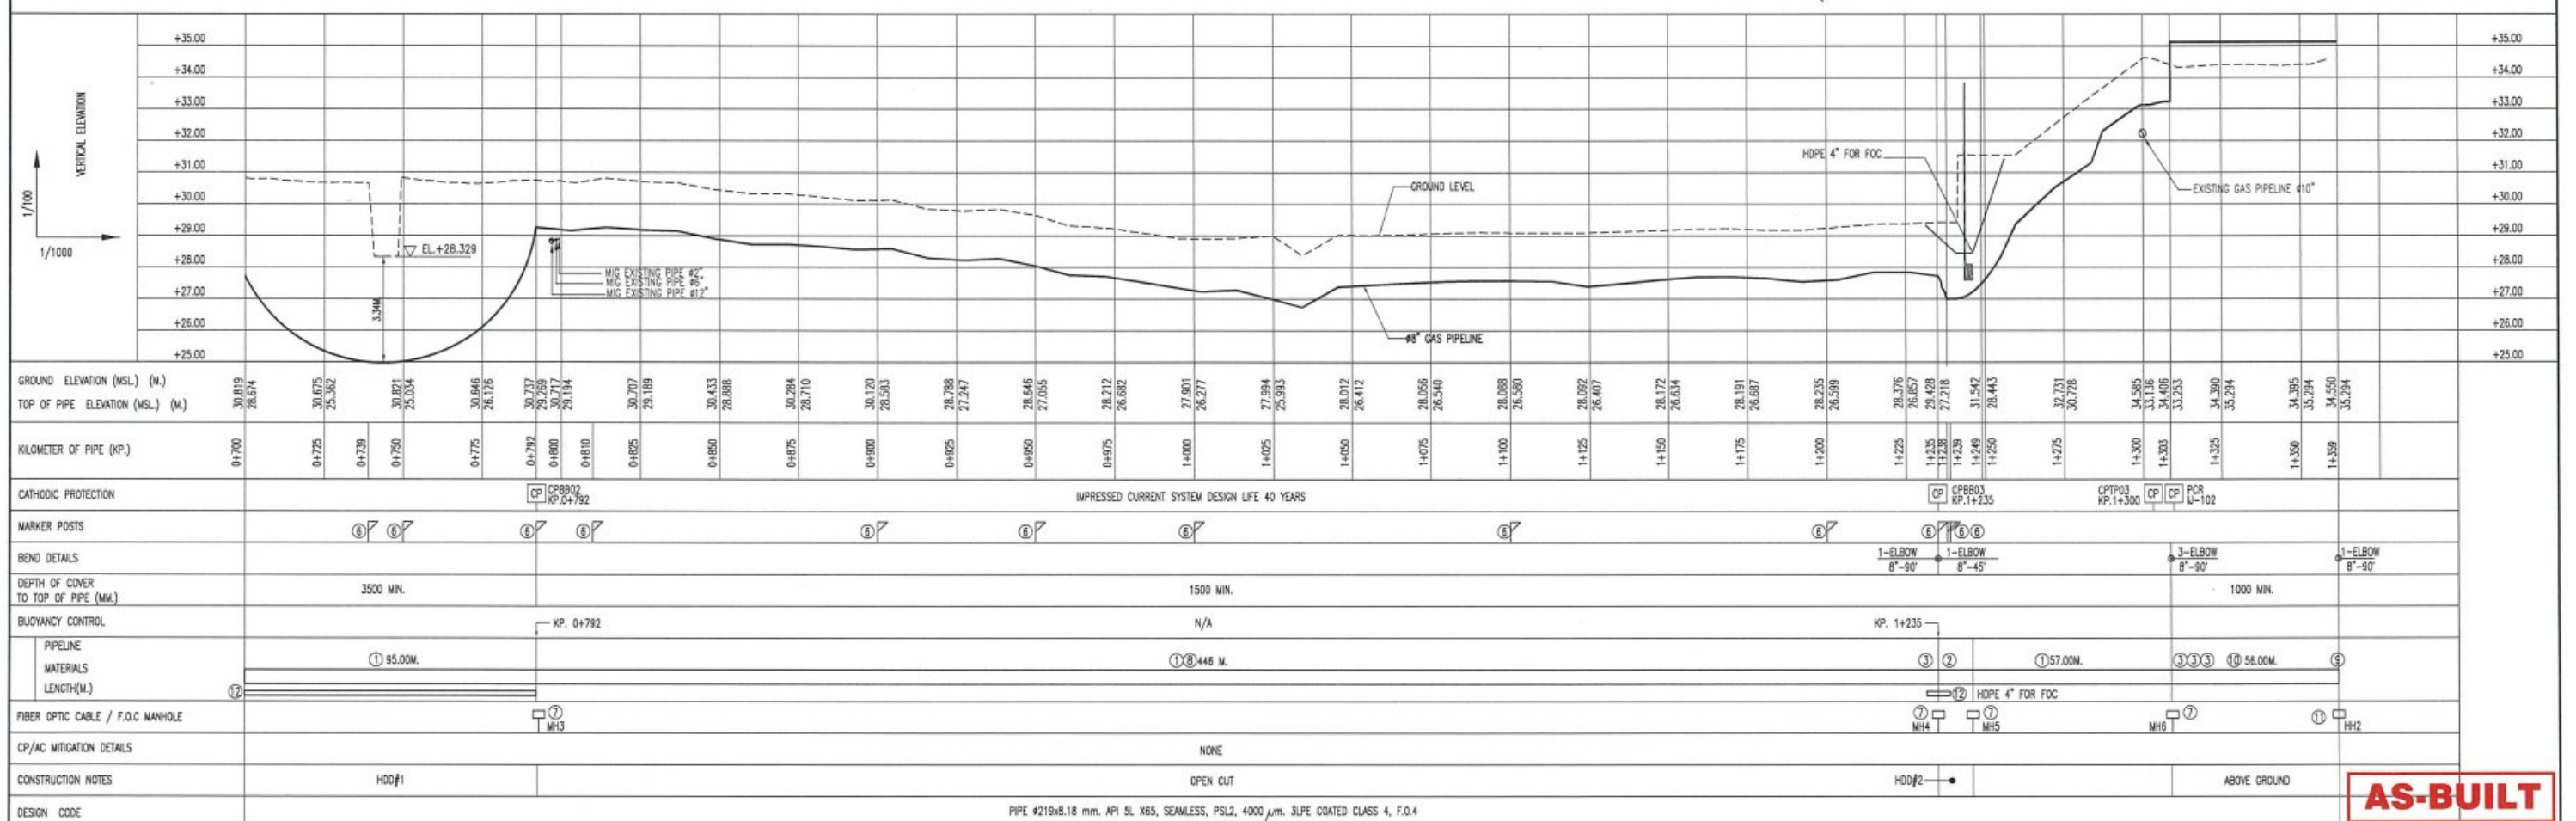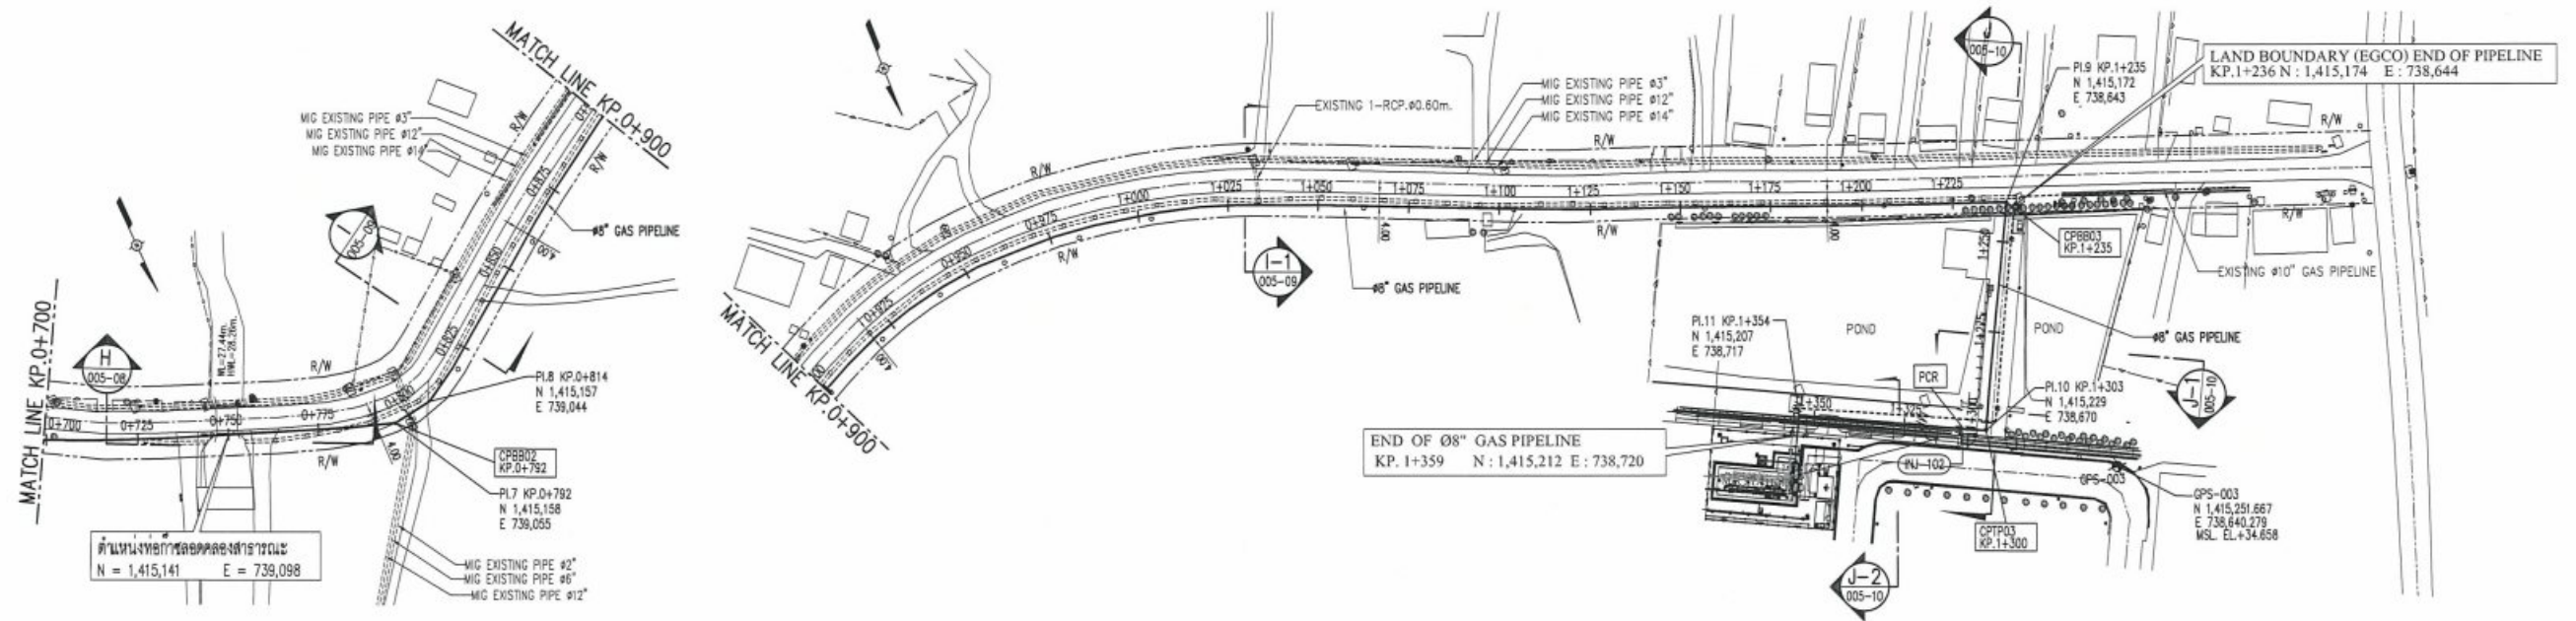


MATERIAL LIST			GENERAL NOTES :		REVIEW STAMP		PROJECT ADVISOR :		PROJECT :			
NO.	QUANTITY	DESCRIPTION	1. INTERMEDIATE MARKERS SHALL BE SPACED APPROXIMATELY 100 METRES OR INSTALLED AT THE NEAREST BEND, DIKE, TRACK ETC. INTERMEDIATE MARKERS MUST BE INTERMISBLE AND SPACING SHALL NOT EXCEED 300 METRES. 2. CONTRACTOR SHALL VERIFY THE ADJACENT EXISTING PTT & M/G PIPELINE LOCATION BEFORE CONSTRUCTION. 3. CONTRACTOR SHALL TOPOGRAPHIC SURVEY AGAIN AND VERIFY ALL OF UNDERGROUND UTILITY DURING DETAILS DESIGN. 4. CONTRACTOR SHALL VERIFY RIGHT OF WAY OF SAO BEFORE CONSTRUCTION. 5. FOR CROSSING RD, RIVER AND WILKING OF RD AND SAO SHALL BE ACHIEVED APPROVAL FROM AUTHORITY OWNERSHIP BEFORE CONSTRUCTION. 6. EPC CONTRACTOR SHALL FURNISH AND INSTALL PROPRIETARY TRENCH BOXES OR OVERLAPPED TRENCH SHEET PILING WITH PROPS AND WALLINGS. 7. FOR CONSTRUCTION METHOD TYPE "BORED" IS MEAN "AUGER BORING" 8. REFERENCE FOR M/G GAS PIPELINE DWG.NO. 7-5531-0036-B ALIGNMENT SHEET TO THANGDI LATERAL STA.0+300.000 TO 0+555.885 9. REFERENCE FOR M/G GAS PIPELINE DWG.NO. 7-5531-0003-B ALIGNMENT SHEET SEGMENT STA.0+000.000 TO 1+248.875 10. REFERENCE FOR PTT GAS PIPELINE DWG.NO. 01-1104.01-4800-009 WILKING 42" ALIGNMENT SHEET FROM KP.15+450 TO KP.16+850 11. REFERENCE FOR PTT GAS PIPELINE DWG.NO. 01-1504.01-4500-109 PRELIMINARY PIPELINE ALIGNMENT SHEET TIPS MOVING STATION TO RAB MOVING STATION KP.11+200 TO 12+000 12. REFERENCE DOC. NO. MS-C-2006.10-4901-001 METHOD STATEMENT FOR HD0. 13. REFERENCE DOC. NO. MS-C-2006.10-4901-002 METHOD STATEMENT FOR BORING. 14. REFERENCE DOC. NO. MS-C-2006.10-4901-003 METHOD STATEMENT FOR OPEN CUT.		EGCO GROUP PROJECT NO.: 2006.10 <input type="checkbox"/> E : Work may proceed. <input type="checkbox"/> F : Work may proceed. Submit Final Document / Drawing. <input type="checkbox"/> G : Review and Resubmit. Work may proceed subject to incorporation of changes indicated. <input type="checkbox"/> H : Review and Resubmit. Work may not proceed. <input type="checkbox"/> I : Review not required. Work may proceed. Acceptance in any of these categories Shall in no way relieve the Contractor / Supplier of its responsibility for		PTT Public Company Limited EGCO COGENERATION COMPANY LIMITED UNITY ENGINEERING AND CONSULTANCY SERVICES CO., LTD. TRC CONSTRUCTION PUBLIC COMPANY LIMITED		NEW GAS PIPELINE SYSTEM FOR EGCO COGENERATION SPP REPLACEMENT PROJECT			
							CLIENT :		TITLE :			
①	603 M.	PIPE #219x8.18 mm. API 5L-X65, SMLS 4,000 µm EXT. 3LPE COATED			1	04/07/2023	ISSUED FOR AS-BUILT			ALIGNMENT SHEET MAIN SHEET KP.0+700 TO KP.1+359		
②	1 EA.	45° 3D ELBOW # 219x8.18 mm. SMLS ASTM A860 WPHY 65, 4000 µm. 3LPE COATED			2	26/08/2022	ISSUED FOR CONSTRUCTION	WY	WRP		PNK	CHN
③	5 EA.	90° 3D ELBOW # 219x8.18 mm. SMLS ASTM A860 WPHY 65, 4000 µm. 3LPE COATED			D	02/08/2022	RE-ISSUED FOR APPROVAL	WY	WRP		PNK	CHN
⑥	12 EA.	INTERMEDIATE MARKER			C	05/07/2022	RE-ISSUED FOR APPROVAL	WY	WRP		PNK	CHN
⑦	4 EA.	MANHOLE (MH3, MH4, MH5, MH6)			B	20/05/2022	RE-ISSUED FOR APPROVAL	IX	WRP		PNK	CHN
⑧	661 M.	#40 mm. HDPE FIBRE OPTIC CABLE AND DUCTS			A	16/03/2022	ISSUED FOR APPROVAL	IX	WRP		PNK	CHN
⑨	1 EA.	90° LR ELBOW # 219x8.18 mm. SMLS ASTM A860 WPHY 65			REV.	DATE	DESCRIPTION	BY	CHKD.		ENG.	APPR.
⑩	56 M.	#219x8.18 mm. API 5L-X65, ERW										
⑪	1 EA.	MANHOLE (MH2)										
⑫	105 M.	#4" HDPE. (FOR FOD)										
							CONSULTANT :		CONTRACTOR :			
							EGCO GROUP		TRC			
							UNITY		CONSTRUCTION PUBLIC COMPANY LIMITED			
							PROJECT NO.: 2006.10-4901-004-02		SCALE AS SHOW			
							SHEET 2 OF 2		REV. 1			

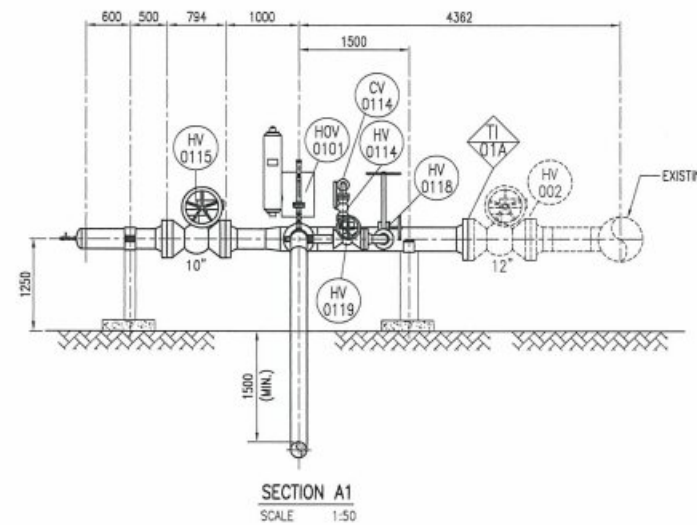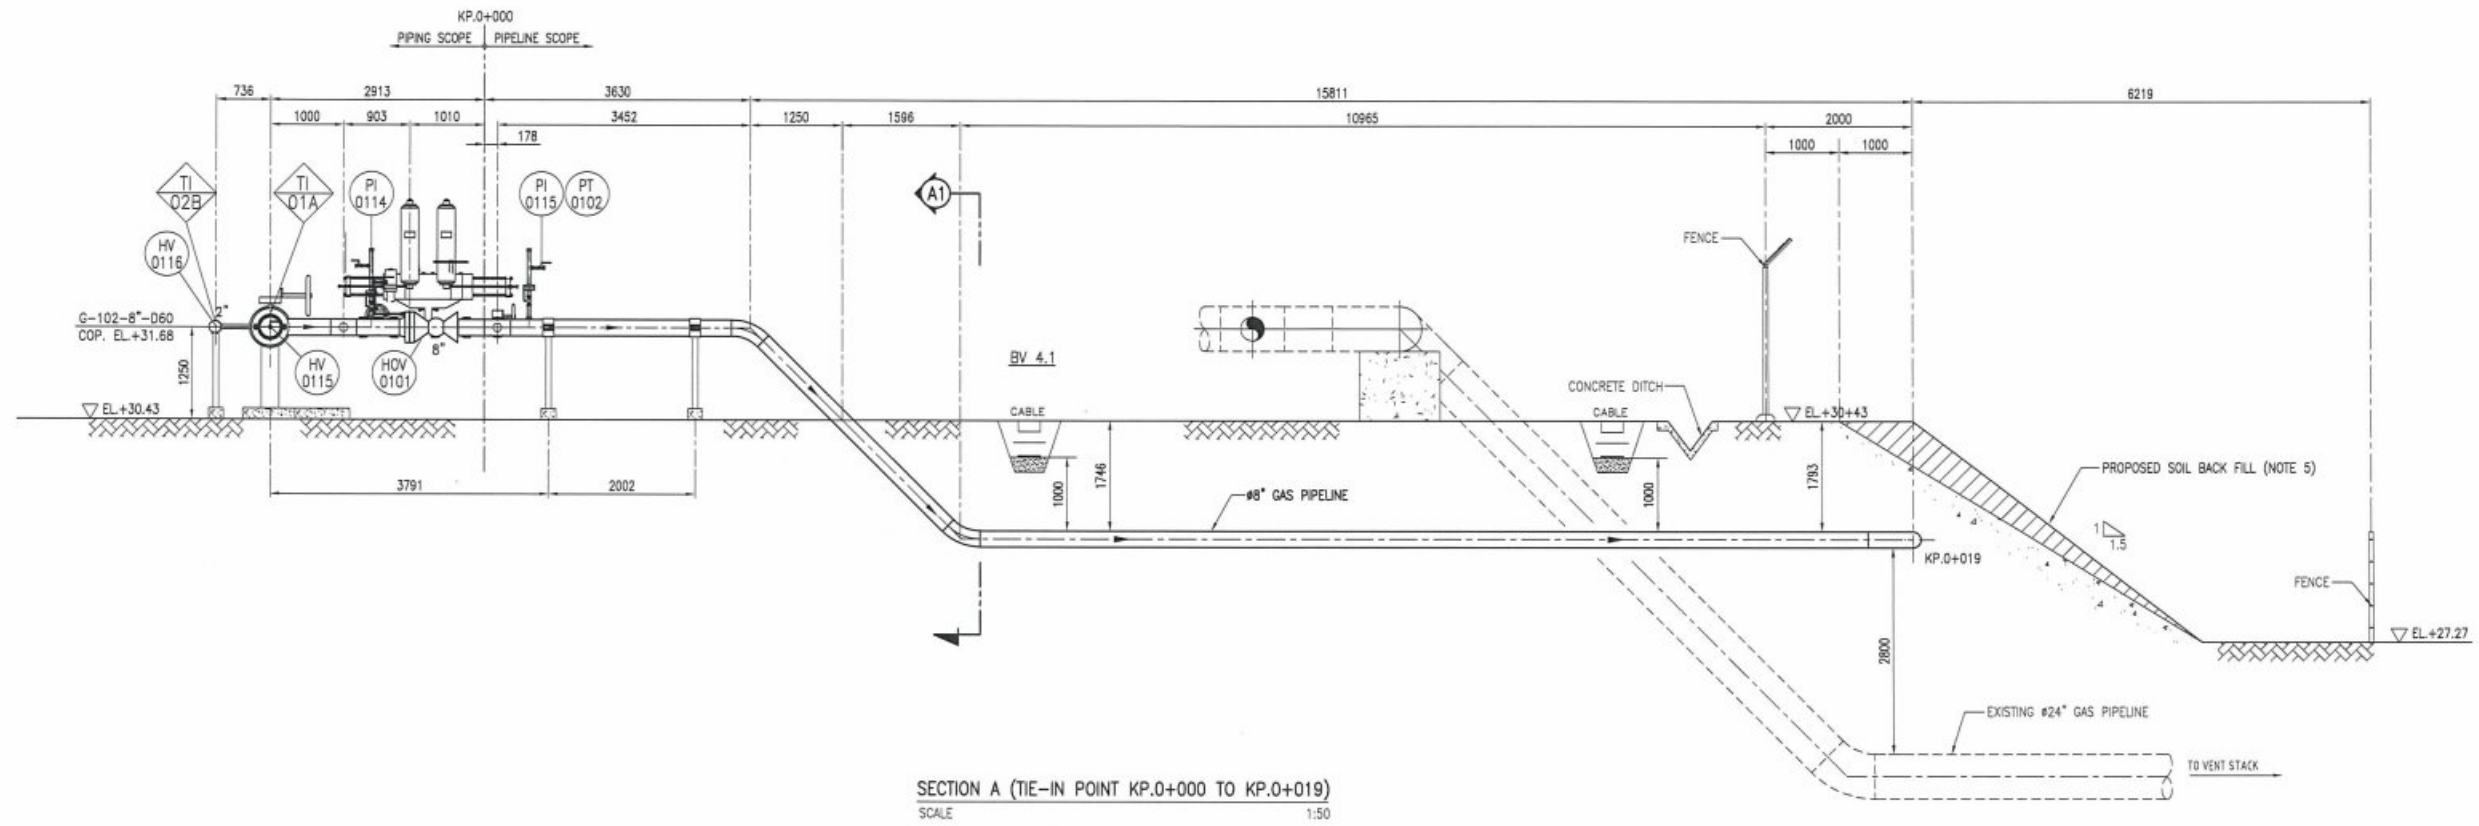



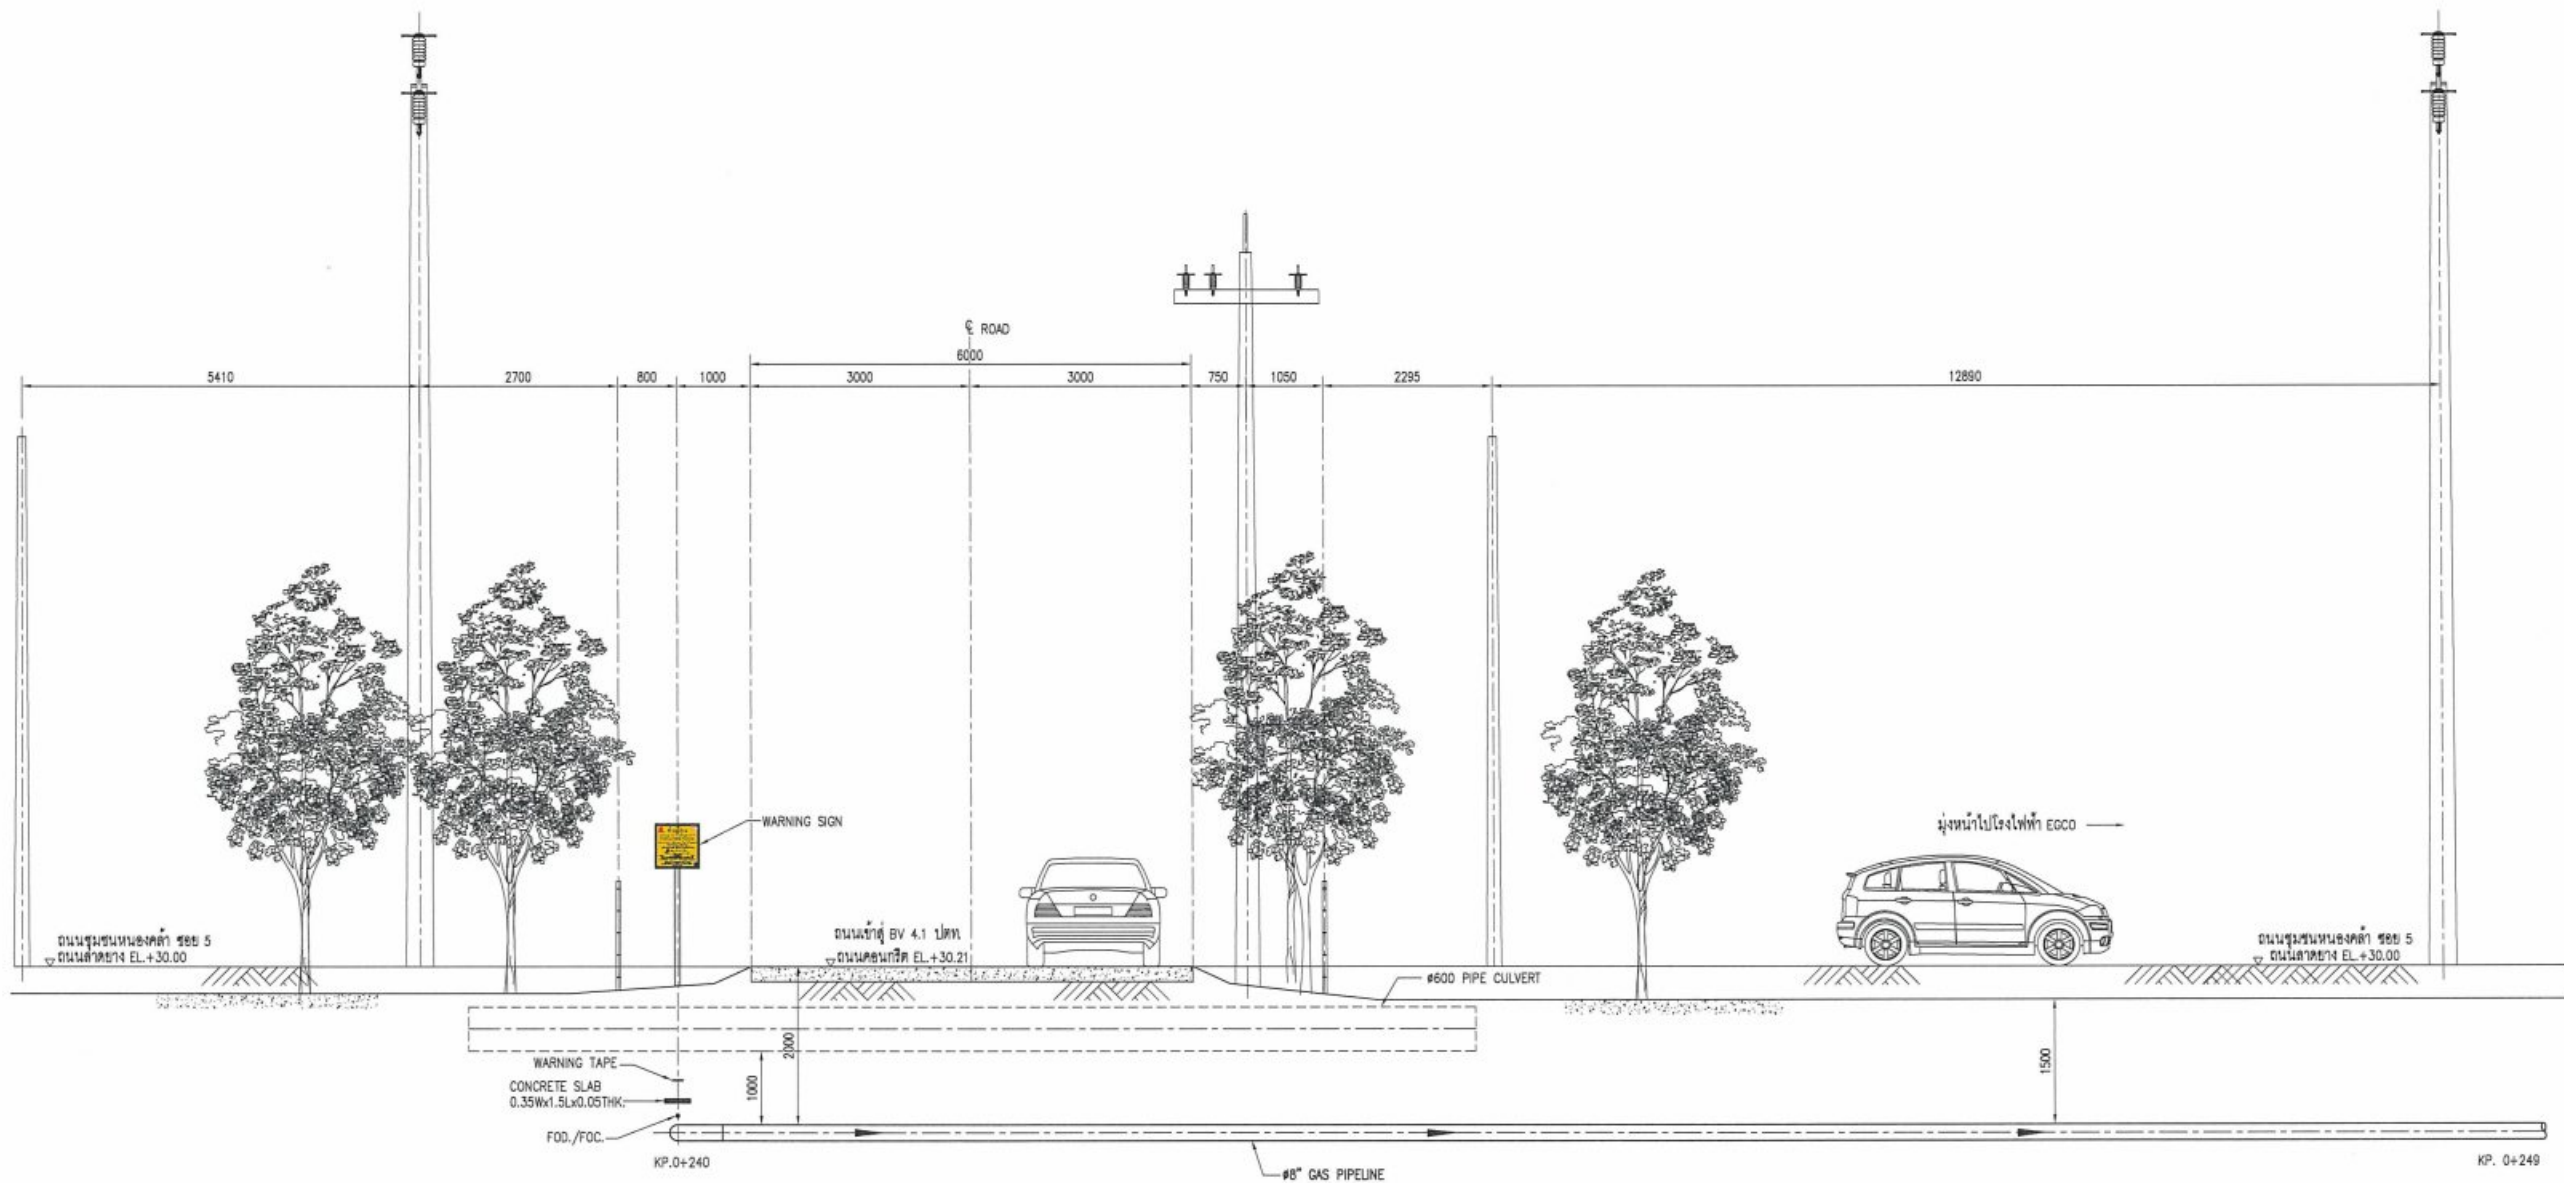


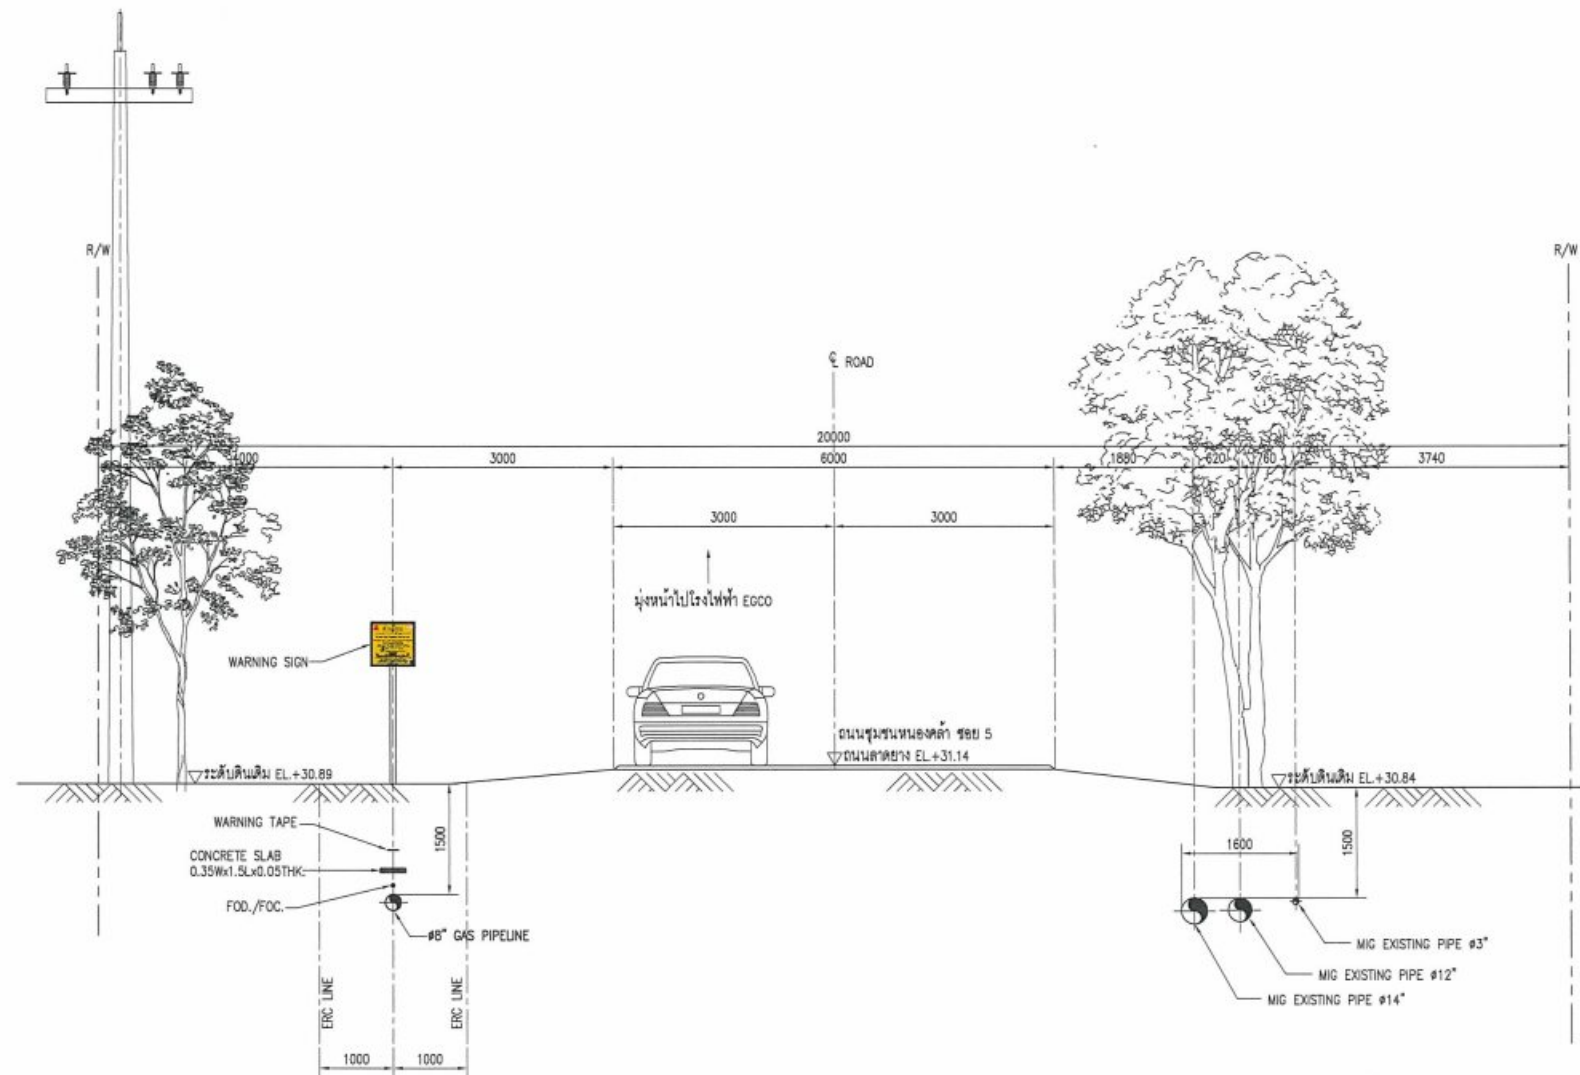
AS-BUILT

REFERENCE DRAWINGS			GENERAL NOTES :			PROJECT ADVISOR :			PROJECT :		
NO.	DRAWING NO.	TITLE	1. CONTRACTOR SHALL VERIFY THE ADJACENT EXISTING PTT & MIG PIPELINE LOCATION BEFORE CONSTRUCTION.			PTT Public Company Limited			NEW GAS PIPELINE SYSTEM FOR		
1	D3-2006.10-4901-004-01	ALIGNMENT SHEET KP.0+000 TO KP.0+700	2. SHORING BRACING OR MATERIAL FOR RETAINING WALLS SHALL BE INSTALLED BEFORE TRENCH EXCAVATION.			EGCO COGENERATION COMPANY LIMITED			EGCO COGENERATION SPP REPLACEMENT PROJECT		
			3. CONTRACTOR SHALL PERFORM SITE INVESTIGATION FOR INSTALLATION ALL MARKER POSTS BEFORE CONSTRUCTION.			UNITY ENGINEERING AND CONSULTANCY SERVICES CO., LTD.			TITLE :		
			4. CONTRACTOR SHALL VERIFY UNDERGROUND UTILITY BEFORE CONSTRUCTION.			CONTRACTOR :			TYPICAL CROSS SECTION DRAWING FROM APPROXIMATE KP.0+000 TO KP.0+019		
			5. PROTECTION SLOPE DAMAGE REFER TO METHOD STATEMENT DOC. NO. MS-C-2006.10-010-003			TRC CONSTRUCTION PUBLIC COMPANY LIMITED			DWG. NO.		
			6. REFERENCE DOC. NO. ED-D-2006.10-4901-001 FOR PIPELINE STRESS ANALYSIS REPORT.			REV.			D3-2006.10-4901-005-01		
			7. REFERENCE DOC. NO. ED-C-2006.10-4901-006 FOR PIPELINE SETTLEMENT CALCULATION.			DATE			1 OF 10		
						DESCRIPTION			SCALE		
						BY			1 : 50		
						CHKD.					
						ENG.					
						APPR.					



AS-BUILT

REFERENCE DRAWINGS			GENERAL NOTES :	<div><div></div><div>REVIEW STAMP</div><div>PROJECT NO.: 2006.10</div></div> <div><div><input checked="" type="checkbox"/> E : Work may proceed.</div><div><input type="checkbox"/> F : Work may proceed. Submit Final Document / Drawing.</div><div><input type="checkbox"/> G : Review and Resubmit. Work may proceed subject to Incorporation of changes indicated.</div><div><input type="checkbox"/> H : Review and Resubmit. Work may not proceed.</div><div><input type="checkbox"/> I : Review not required. Work may proceed.</div></div> <div>Acceptance in any of these categories shall in no way relieve the Contractor / Supplier of its responsibility for the due and proper performance of the Work in accordance with the Contract / Purchase Order.</div> <th>PROJECT ADVISOR :</th> <th colspan="5">PROJECT :</th>	PROJECT ADVISOR :	PROJECT :				
NO.	DRAWING NO.	TITLE			PROJECT ADVISOR :	PROJECT :				
1	03-2006.10-4901-004-01	ALIGNMENT SHEET KP.0+000 TO KP.0+700	<div></div> <div>PTT Public Company Limited</div>	NEW GAS PIPELINE SYSTEM FOR EGCO COGENERATION SPP REPLACEMENT PROJECT						
			CLIENT :	TITLE :						
			<div></div> <div>EGCO COGENERATION COMPANY LIMITED</div>	TYPICAL CROSS SECTION DRAWING FROM APPROXIMATE KP.0+240 TO KP.0+249						
			CONSULTANT :							
			<div></div> <div>UNITY ENGINEERING AND CONSULTANCY SERVICES CO., LTD.</div>							
			CONTRACTOR :							
			<div></div> <div>TRC CONSTRUCTION PUBLIC COMPANY LIMITED</div>							
2	04/07/2023	ISSUED FOR AS-BUILT								
1	05/08/2022	RE-ISSUED FOR CONSTRUCTION	WY	WRP	PMK	CHN				
0	29/06/2022	ISSUED FOR CONSTRUCTION	IX	WRP	PMK	CHN				
B	20/05/2022	RE-ISSUED FOR APPROVAL	IX	WRP	PMK	CHN				
A	16/3/2022	ISSUED FOR APPROVAL	IX	WRP	PMK	CHN				
REV.	DATE	DESCRIPTION	BY	CHKD.	ENG.	APPR.				





SECTION F (KP.0+650)
SCALE 1:50




AS-BUILT


FILE NAME : D3-2006.10-4901-005-06-2

REFERENCE DRAWINGS			GENERAL NOTES :		REVIEW STAMP EGCO PROJECT NO.: 2006.10	PROJECT ADVISOR : PTT Public Company Limited				PROJECT : NEW GAS PIPELINE SYSTEM FOR EGCO COGENERATION SPP REPLACEMENT PROJECT			
NO.	DRAWING NO.	TITLE											
1	D3-2006.10-4901-004-01	ALIGNMENT SHEET KP.0+000 TO KP.0+700	1. CONTRACTOR SHALL VERIFY THE ADJACENT EXISTING PTI & MIG PIPELINE LOCATION BEFORE CONSTRUCTION. 2. SHORING BRACING OR MATERIAL FOR RETAINING WALLS SHALL BE INSTALLED BEFORE TRENCH EXCAVATION. 3. CONTRACTOR SHALL PERFORM SITE INVESTIGATION FOR INSTALLATION ALL MARKER POSTS BEFORE CONSTRUCTION. 4. CONTRACTOR SHALL VERIFY UNDERGROUND UTILITY BEFORE CONSTRUCTION. 5. REFERENCE DOC. NO. MS-C-2006.10-010-003 FOR METHOD STATEMENT FOR OPEN CUT. 6. REFERENCE DOC. NO. ED-D-2006.10-4901-004 FOR BUOYANCY CONTROL CALCULATION. 7. REFERENCE DOC. NO. ED-D-2006.10-4901-002 FOR PIPELINE STRESS CROSSING ROAD CALCULATION. 8. REFERENCE DOC. NO. ED-D-2006.10-4901-001 FOR PIPELINE STRESS ANALYSIS REPORT.		<input checked="" type="checkbox"/> E : Work may proceed. <input type="checkbox"/> F : Work may proceed. Submit Final Document / Drawing. <input type="checkbox"/> G : Review and Resubmit. Work may proceed subject to Incorporation of changes indicated. <input type="checkbox"/> H : Review and Resubmit. Work may not proceed. <input type="checkbox"/> I : Review not required. Work may proceed. Acceptance in any of these categories shall in no way relieve the Contractor / Supplier of its responsibility for the due and proper performance of the Work in accordance with the Contract / Purchase Order.	CLIENT : EGCO COGENERATION COMPANY LIMITED CONSULTANT : UNITY ENGINEERING AND CONSULTANCY SERVICES CO., LTD. CONTRACTOR : TRC CONSTRUCTION PUBLIC COMPANY LIMITED				TITLE : TYPICAL CROSS SECTION DRAWING FROM APPROXIMATE KP.0+650 DWG. NO. : 03-2006.10-4901-005-06 SCALE : 1 : 50			
						2	04/07/2023	ISSUED FOR AS-BUILT					
						1	05/08/2022	RE-ISSUED FOR CONSTRUCTION	WY	WRP	PWK	CHN	
						0	28/06/2022	ISSUED FOR CONSTRUCTION	IX	WRP	PWK	CHN	
						B	20/05/2022	RE-ISSUED FOR APPROVAL	IX	WRP	PWK	CHN	
						A	16/03/2022	ISSUED FOR APPROVAL	IX	WRP	PWK	CHN	
						REV.	DATE	DESCRIPTION	BY	CHKD.	ENG.	APPR.	

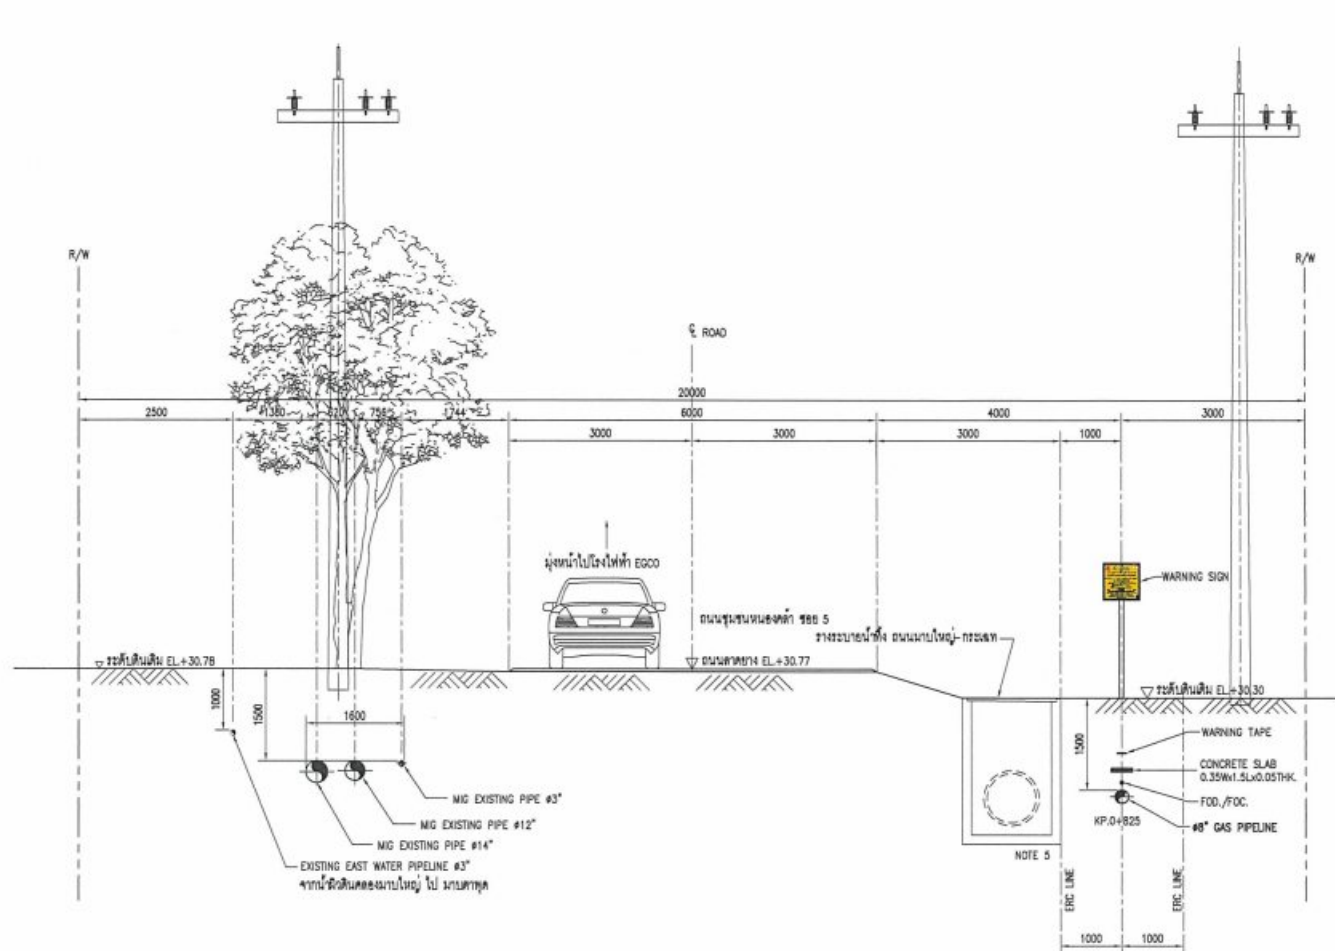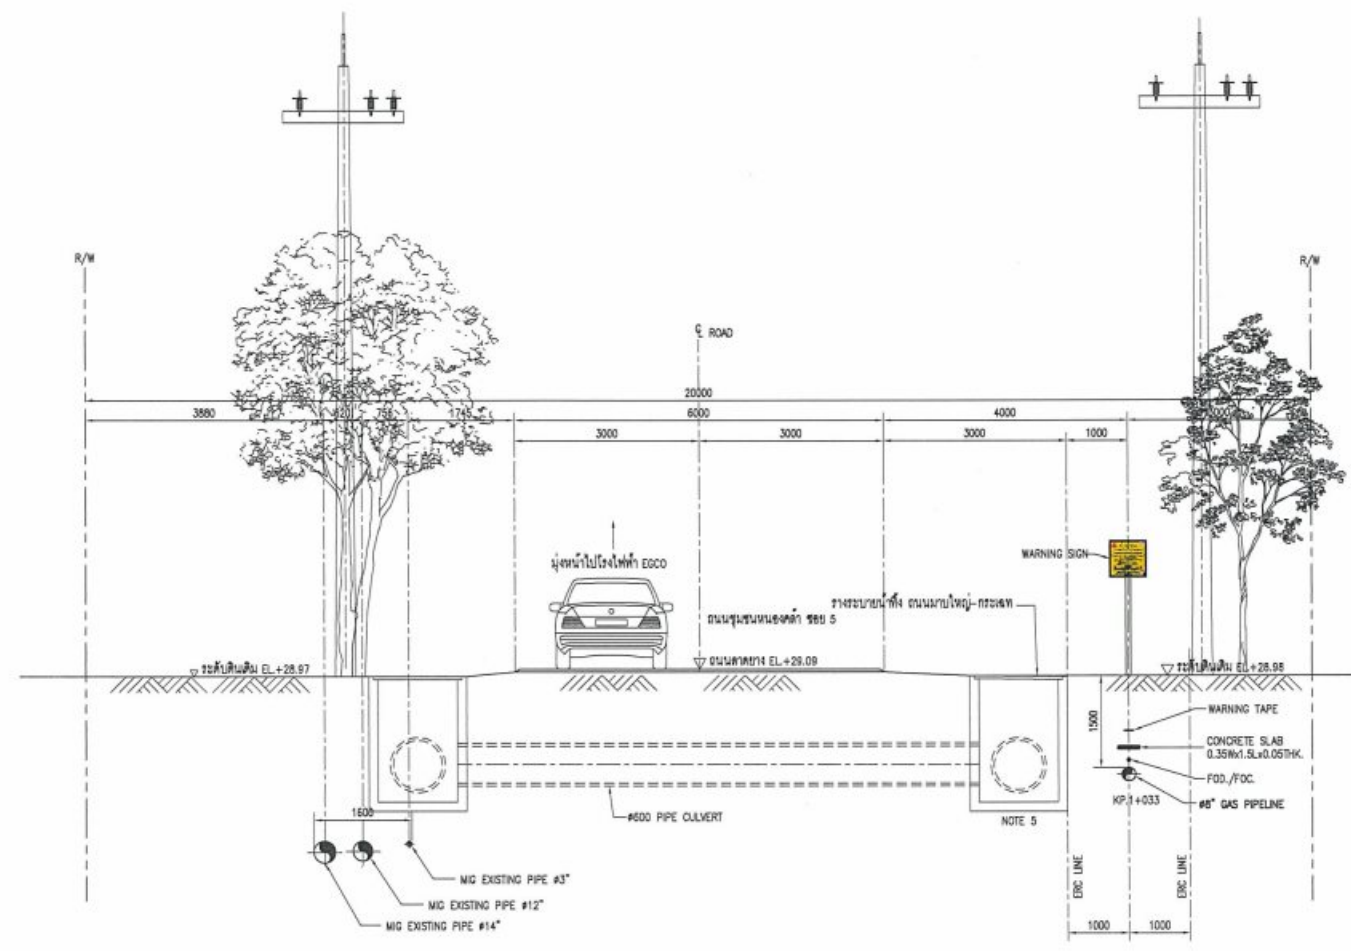SHEET 6 OF 10
REV. 2

SECTION I (KP.0+825)
SCALE 1:75SECTION I-1 (KP.1+033)
SCALE 1:75**AS-BUILT**

REFERENCE DRAWINGS			GENERAL NOTES :	<div><div></div><div>REVIEW STAMP PROJECT NO.: 2006.10</div><div><input checked="" type="checkbox"/> E : Work may proceed. <input type="checkbox"/> F : Work may proceed. Submit Final Document / Drawing. <input type="checkbox"/> G : Review and Resubmit. Work may proceed subject to incorporation of changes indicated. <input type="checkbox"/> H : Review and Resubmit. Work may not proceed. <input type="checkbox"/> I : Review not required. Work may proceed. <small>Acceptance in any of these categories shall in no way relieve the Contractor / Supplier of its responsibility for the due and proper performance of the Work in</small></div></div>	PROJECT ADVISOR : <div> PTT Public Company Limited</div>					PROJECT : NEW GAS PIPELINE SYSTEM FOR EGCO COGENERATION SPP REPLACEMENT PROJECT	
NO.	DRAWING NO.	TITLE			CLIENT : <div> EGCO COGENERATION COMPANY LIMITED</div>					TITLE : TYPICAL CROSS SECTION DRAWING FROM APPROXIMATE KP.0+825 AND KP.1+033	
1	03-2006.10-4901-004-02	ALIGNMENT SHEET KP.0+700 TO KP.1+359	1. CONTRACTOR SHALL VERIFY THE ADJACENT EXISTING PIT & MIG PIPELINE LOCATION BEFORE CONSTRUCTION.	2	04/07/2023	ISSUED FOR AS-BUILT					
			2. SHORING BRACING OR MATERIAL FOR RETAINING WALLS SHALL BE INSTALLED BEFORE TRENCH EXCAVATION.	1	05/08/2022	RE-ISSUED FOR CONSTRUCTION					
			3. CONTRACTOR SHALL PERFORM SITE INVESTIGATION FOR INSTALLATION ALL MARKER POSTS BEFORE CONSTRUCTION.	0	28/06/2022	ISSUED FOR CONSTRUCTION	IX	WRP	PNK	CHN	
			4. CONTRACTOR SHALL VERIFY UNDERGROUND UTILITY BEFORE CONSTRUCTION.	A1	20/05/2022	RE-ISSUED FOR APPROVAL	IX	WRP	PNK	CHN	
			5. CONTRACTOR SHALL PROPOSED TEMPORARY WATER DRAINAGE DURING CONSTRUCTION.	A	16/03/2022	ISSUED FOR APPROVAL	IX	WRP	PNK	CHN	
			6. REFERENCE DOC. NO. MS-C-2006.10-010-003 FOR METHOD STATEMENT FOR OPEN CUT.	REV.	DATE	DESCRIPTION	BY	CHKD.	ENG.	APPR.	
			7. REFERENCE DOC. NO. ED-D-2006.10-4901-004 FOR BUOYANCY CONTROL CALCULATION.								
			8. REFERENCE DOC. NO. ED-D-2006.10-4901-002 FOR PIPELINE STRESS CROSSING ROAD CALCULATION.								
			9. REFERENCE DOC. NO. ED-D-2006.10-4901-001 FOR PIPELINE STRESS ANALYSIS REPORT.								
		</									


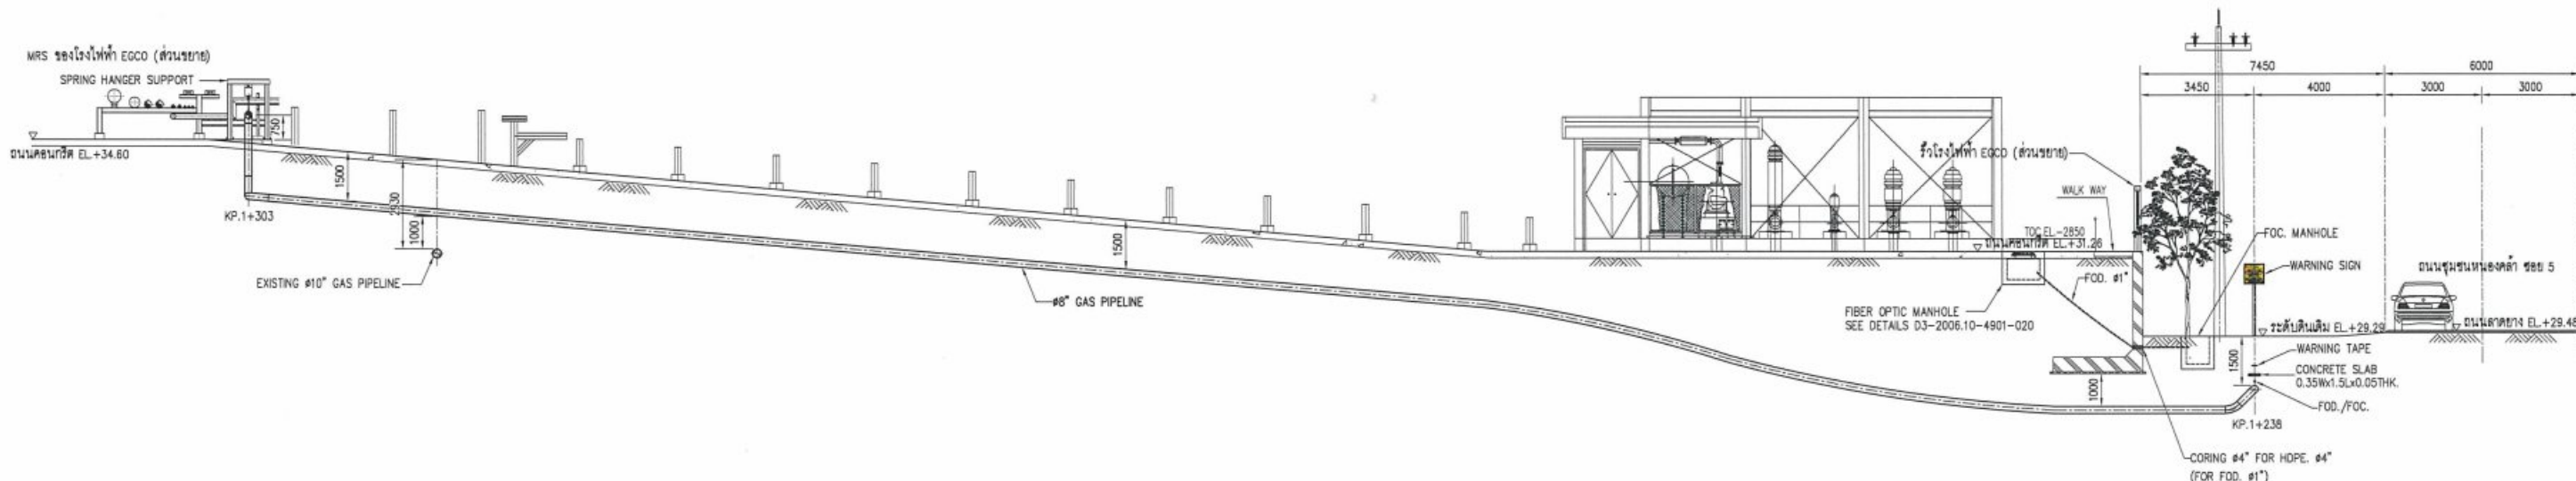


SECTION J (KP.1+238 TO KP.1+303)
SCALE 1:100

AS-BUILT


REFERENCE DRAWINGS			GENERAL NOTES :			REVIEW STAMP			PROJECT ADVISOR :			PROJECT :		
NO.	DRAWING NO.	TITLE				EGCO GROUP PROJECT NO.: 2006.10			PTT Public Company Limited			NEW GAS PIPELINE SYSTEM FOR EGCO COGENERATION SPP REPLACEMENT PROJECT		
1	03-2006.10-4901-004-02	ALIGNMENT SHEET KP.0+700 TO KP.1+359	1. CONTRACTOR SHALL VERIFY THE ADJACENT EXISTING PTT & MIG PIPELINE LOCATION BEFORE CONSTRUCTION. 2. SHORING BRACING OR MATERIAL FOR RETAINING WALLS SHALL BE INSTALLED BEFORE TRENCH EXCAVATION. 3. CONTRACTOR SHALL PERFORM SITE INVESTIGATION FOR INSTALLATION ALL MARKER POSTS BEFORE CONSTRUCTION. 4. CONTRACTOR SHALL VERIFY UNDERGROUND UTILITY BEFORE CONSTRUCTION. 5. REFERENCE DOC. NO. MS-C-2006.10-010-003 FOR METHOD STATEMENT FOR OPEN CUT. 6. REFERENCE DOC. NO. ED-D-2006.10-4901-004 FOR BUOYANCY CONTROL CALCULATION. 7. REFERENCE DOC. NO. ED-D-2006.10-4901-002 FOR PIPELINE STRESS CROSSING ROAD CALCULATION. 8. REFERENCE DOC. NO. ED-D-2006.10-4901-001 FOR PIPELINE STRESS ANALYSIS REPORT. 9. REFERENCE DOC. NO. ED-C-2006.10-4901-006 FOR PIPELINE SETTLEMENT CALCULATION.			<input checked="" type="checkbox"/> C : Work may proceed. <input type="checkbox"/> F : Work may proceed. Submit Final Document / Drawing. <input type="checkbox"/> G : Review and Resubmit. Work may proceed subject to incorporation of changes indicated. <input type="checkbox"/> H : Review and Resubmit. Work may not proceed. <input type="checkbox"/> I : Review not required. Work may proceed. Acceptance in any of these categories shall in no way relieve the Contractor / Supplier of its responsibility for the due and proper performance of the Work in accordance with the Contract / Purchase Order.			CLIENT : EGCO COGENERATION COMPANY LIMITED CONSULTANT : UNITY ENGINEERING AND CONSULTANCY SERVICES CO., LTD. CONTRACTOR : TRC CONSTRUCTION PUBLIC COMPANY LIMITED			TITLE : TYPICAL CROSS SECTION DRAWING FROM APPROXIMATE KP.1+238 TO KP.1+303 DWG. NO. : D3-2006.10-4901-005-10 SCALE : AS SHOWN		
						2 04/07/2023 ISSUED FOR AS-BUILT 1 05/08/2022 RE-ISSUED FOR CONSTRUCTION 0 29/06/2022 ISSUED FOR CONSTRUCTION A1 20/05/2022 RE-ISSUED FOR APPROVAL A 16/03/2022 ISSUED FOR APPROVAL						SHEET 10 OF 10 REV. 2		
						REV. DATE DESCRIPTION BY CHKD. ENG. APPR.								

FILE NAME : D3-2006.10-4901-005-10-2

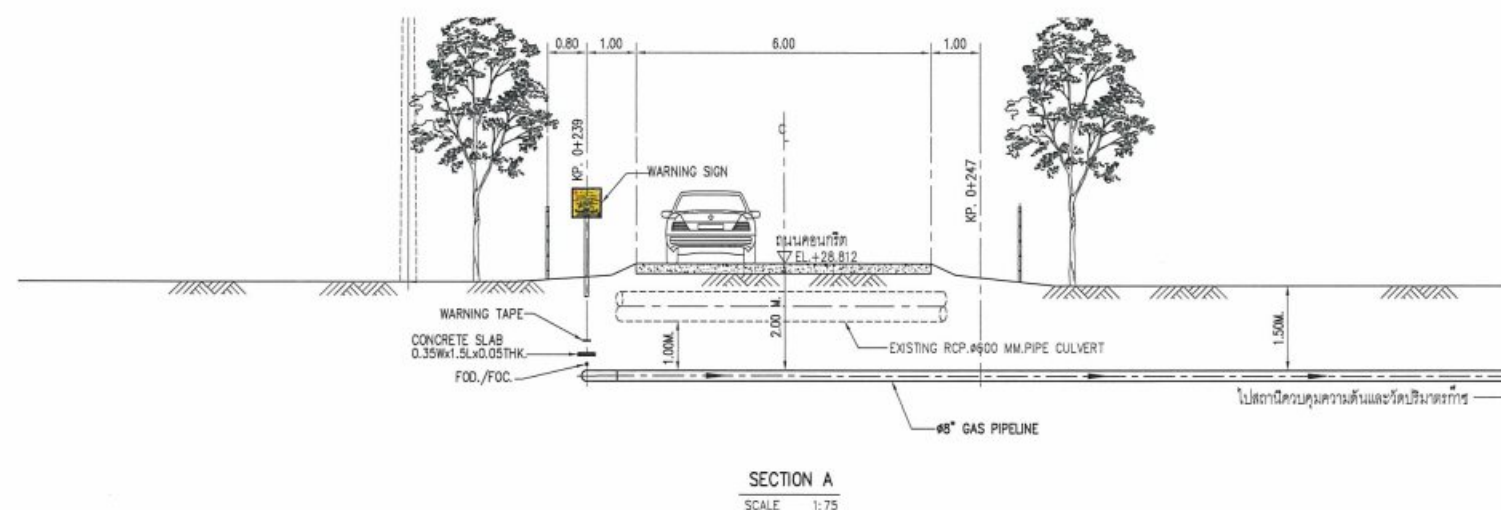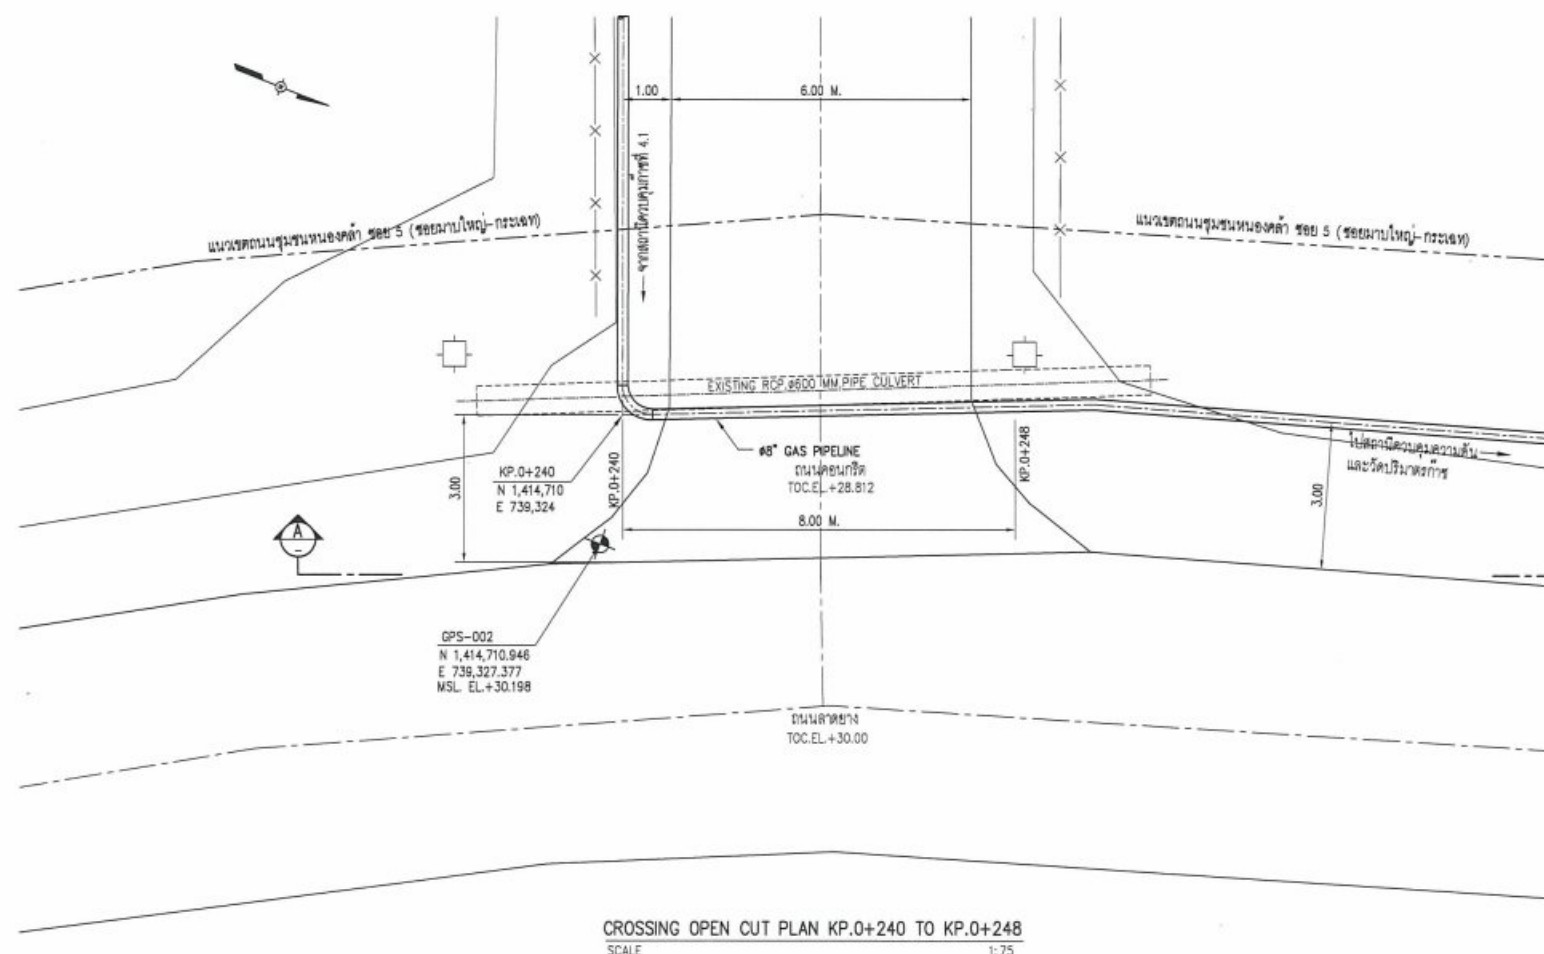


AS-BUILT

[illegible]

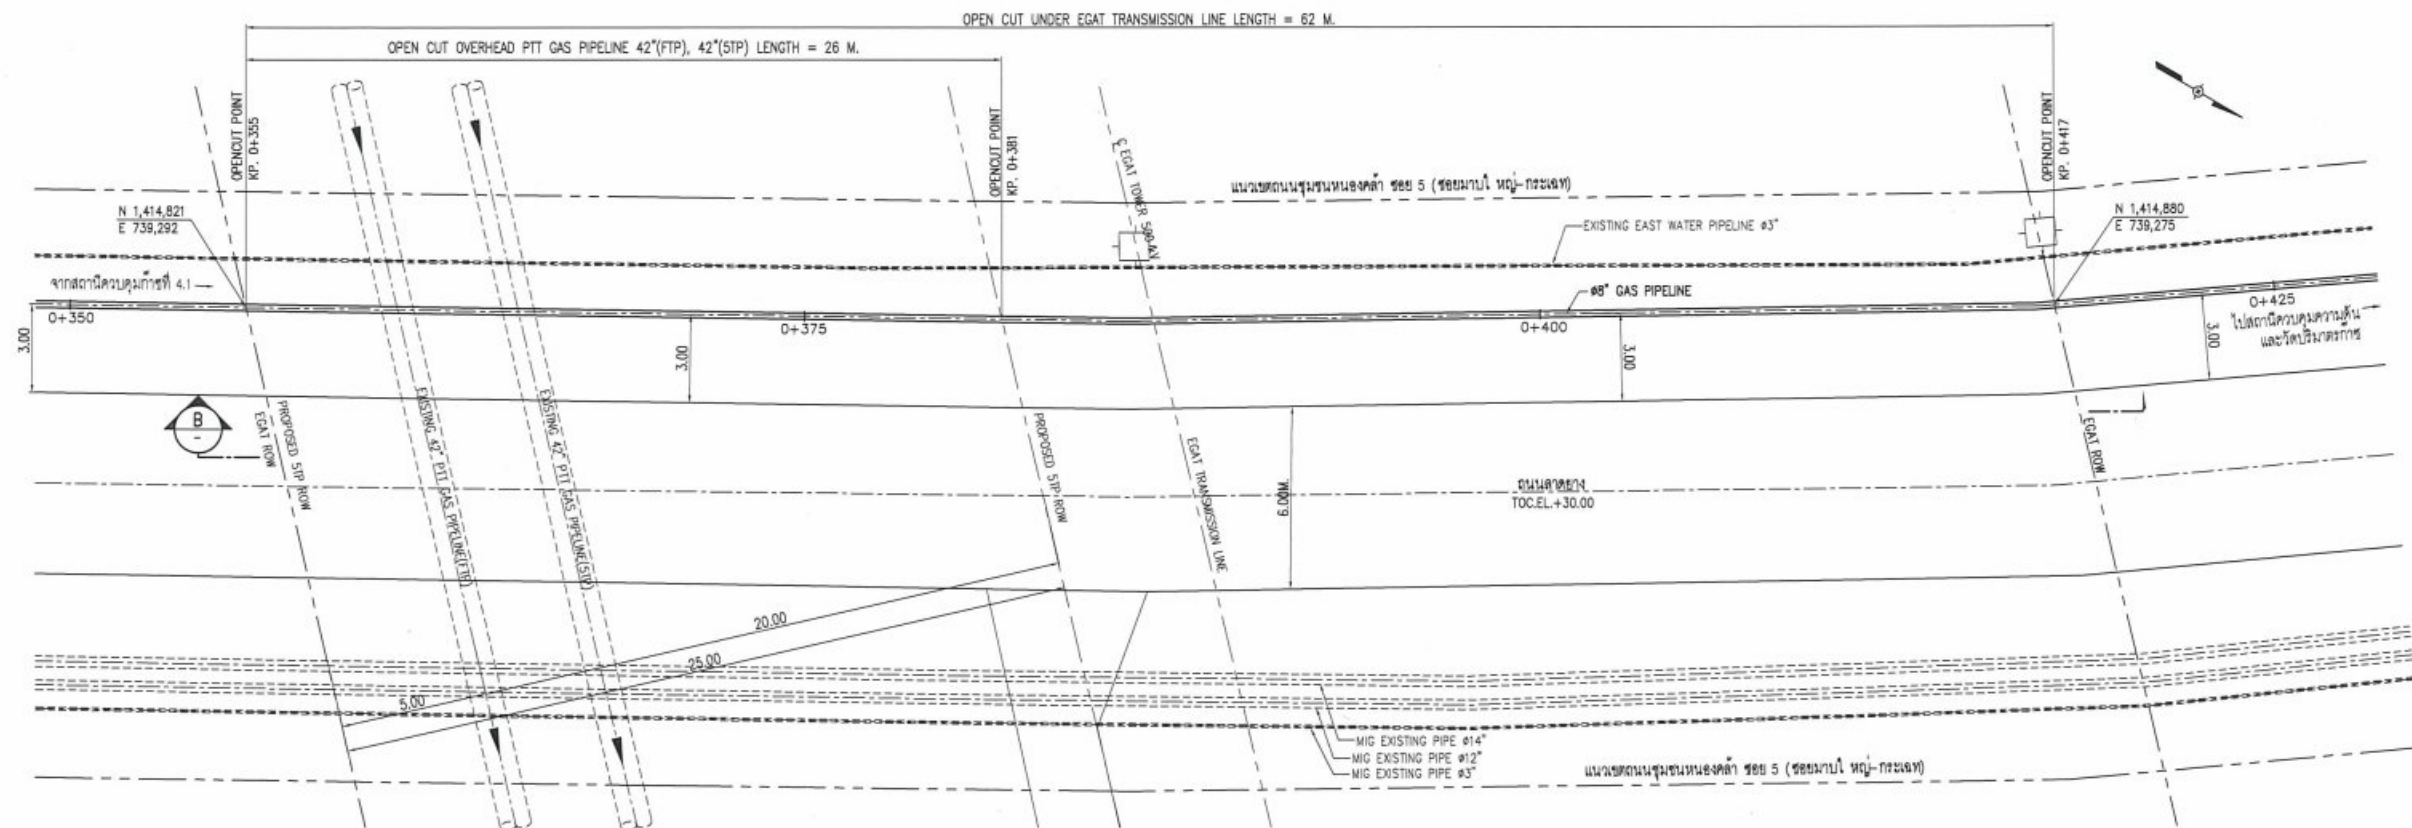

CROSSING OPEN CUT PLAN KP.0+355 TO KP.0+417
SCALE 1:125

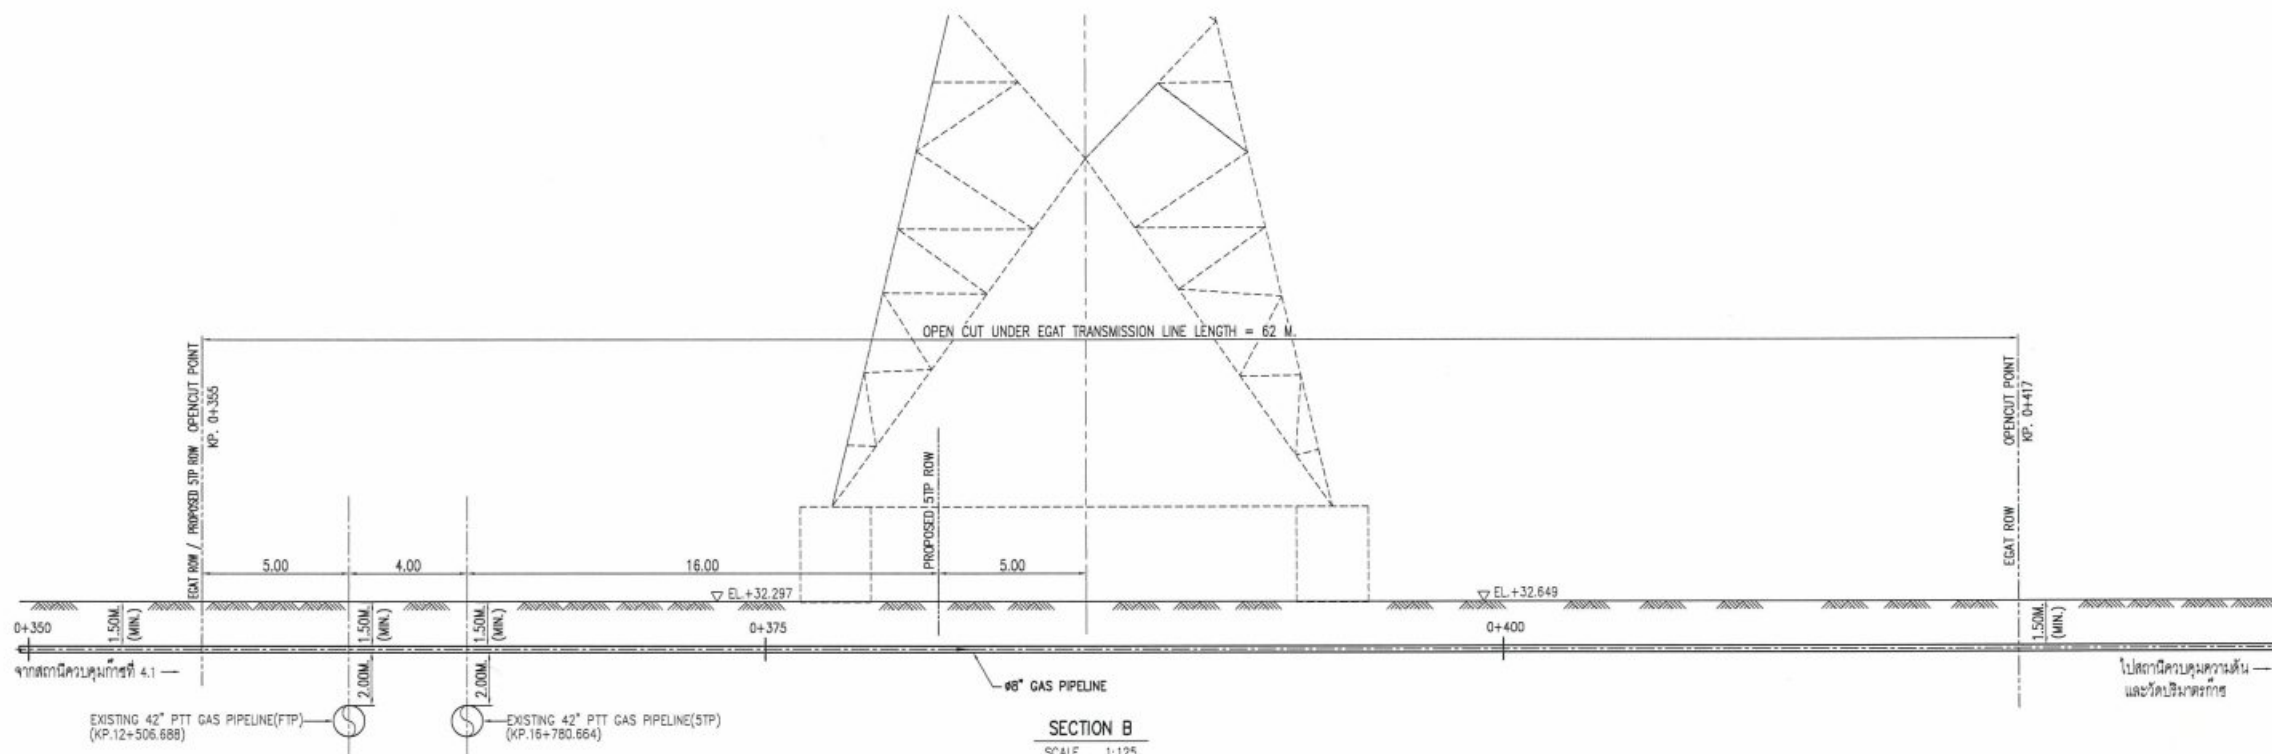

SECTION B
SCALE 1:125


AS-BUILT

REFERENCE DRAWINGS			GENERAL NOTES :	<div><div><div><div><div><div></div><div></div><div></div></div><div><div></div><div></div><div></div></div><div><div></div><div></div><div></div></div></div><div><div></div><div></div><div></div></div><div><div></div><div></div><div></div></div></div><div>REVIEW STAMP</div><div>PROJECT NO.: 2006.10</div><div><div><div><input checked="" type="checkbox"/> E : Work may proceed.</div><div><input type="checkbox"/> F : Work may proceed. Submit Final Document / Drawing.</div><div><input type="checkbox"/> G : Review and Resubmit. Work may proceed subject to incorporation of changes indicated.</div><div><input type="checkbox"/> H : Review and Resubmit. Work may not proceed.</div><div><input type="checkbox"/> I : Review not required. Work may proceed.</div></div><div>Acceptance in any of these categories shall in no way relieve the Contractor / Supplier of its responsibility for the accuracy of the information provided.</div></div></div></div>	PROJECT ADVISOR : <div><div><div></div><div></div><div></div></div><div>PTT Public Company Limited</div></div>				PROJECT : <div>NEW GAS PIPELINE SYSTEM FOR EGCO COGENERATION SPP REPLACEMENT PROJECT</div>			
NO.	DRAWING NO.	TITLE			CLIENT : <div><div><div></div><div></div><div></div></div><div>EGCO COGENERATION COMPANY LIMITED</div></div>				TITLE : <div>CROSSING OPEN CUT KP.0+355 TO KP.0+417</div>			
1	7-5531-0036-B	ALIGNMENT SHEET TO/THAINOX LATERAL STA.0+000.000 TO 0+959.885	<div>2</div> <div>04/07/2023</div> <div>ISSUED FOR AS-BUILT</div>	<div>WY</div> <div>WRP</div> <div>PWK</div> <div>CHN</div>	<div>CHN</div>	ANT : <div><div><div></div><div></div><div></div></div><div>UNITY ENGINEERING AND CONSULTANCY SERVICES CO., LTD.</div></div>	CONTRACTOR : <div><div><div></div><div></div><div></div></div><div>TRC CONSTRUCTION PUBLIC COMPANY LIMITED</div></div>	DWG. NO. <div>D3-2006.10-4901-007</div>	SHEET 1 OF 1	REV. 2		
2	7-5531-0003-B	ALIGNMENT SHEET SEGMENT STA.0+000.000 TO 1+248.875										
3	01-1104.01-4900-009	MAINLINE 42" ALIGNMENT SHEET FROM KP.15+450 TO KP.16+850										
4	01-1504.01-6500-109	PRELIMINARY PIPELINE ALIGNMENT SHEET TIPS MIXING STATION TO RAG										
		MIXING STATION KP.11+200 TO 12+600										
5	03-2006.10-4901-004-01	ALIGNMENT SHEET KP.0+000 TO KP.0+700										
6	03-2006.10-4901-015	TYPICAL TRENCH EXCAVATION DETAILS	1	16/08/2022	RE-ISSUED FOR CONSTRUCTION	WY	WRP	PWK	CHN			
			0	06/07/2022	ISSUED FOR CONSTRUCTION	WY	WRP	PWK	CHN			
			A1	24/05/2022	RE-ISSUED FOR APPROVAL	IX	WRP	PWK	CHN			
			A	16/03/2022	ISSUED FOR APPROVAL	IX	WRP	PWK	CHN			
REV.	DATE	DESCRIPTION	BY	CHKD.	ENG.	APPR.						



CROSSING BORING PLAN KP.0+686 TO KP.0+699



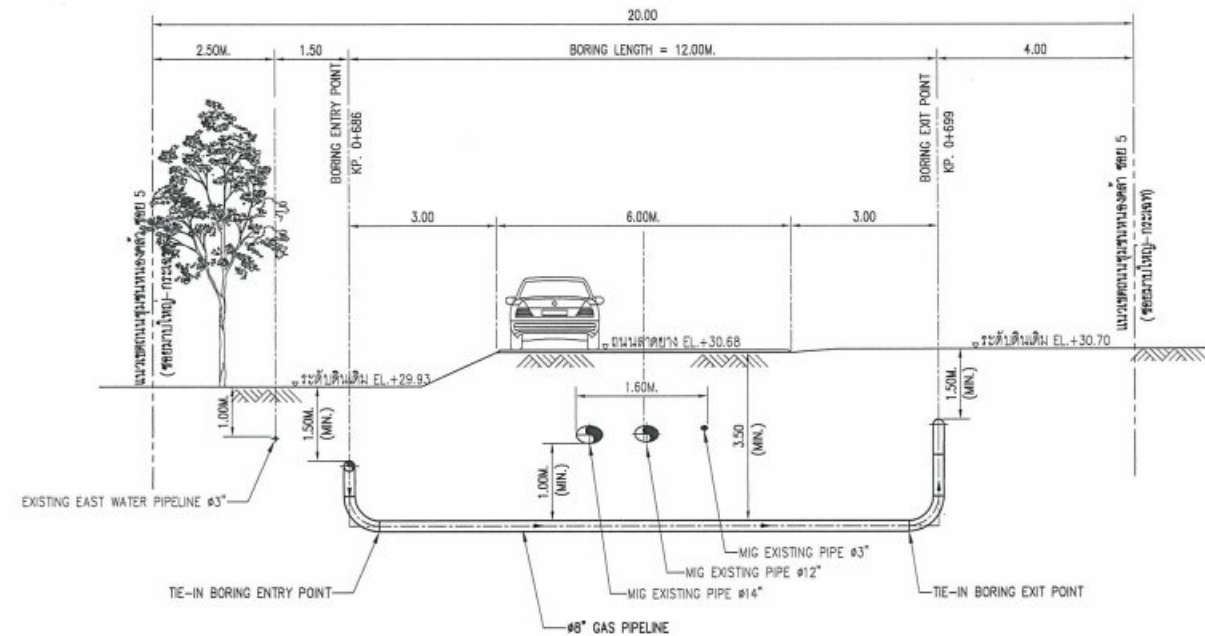


SCALE 1:75



SECTION C

SCALE 1:75

AS-BUILT

REFERENCE DRAWINGS			GENERAL NOTES : 1. CONTRACTOR SHALL VERIFY THE ADJACENT EXISTING PTT & MIG PIPELINE LOCATION BEFORE CONSTRUCTION. 2. SHORING BRACING OR MATERIAL FOR RETAINING WALLS SHALL BE INSTALLED BEFORE TRENCH EXCAVATION. 3. CONTRACTOR SHALL PERFORM SITE INVESTIGATION FOR INSTALLATION ALL MARKER POSTS BEFORE CONSTRUCTION. 4. CONTRACTOR SHALL VERIFY UNDERGROUND UTILITY BEFORE CONSTRUCTION. 5. REFER DOC. NO. MS-C-2006.10-010-002 FOR METHOD STATEMENT FOR BORING. 6. REFER DOC. NO. ED-D-2006.10-4901-004 FOR BUOYANCY CONTROL CALCULATION. 7. REFER DOC. NO. ED-D-2006.10-4901-001 FOR PIPELINE STRESS ANALYSIS REPORT. 8. REFER DOC. NO. ED-D-2006.10-4901-002 FOR PIPELINE STRESS CROSSING ROAD CALCULATION.	REVIEW STAMP PROJECT NO.: 2006.10		PROJECT ADVISOR : <div> PTT Public Company Limited</div>			PROJECT : NEW GAS PIPELINE SYSTEM FOR EGCO COGENERATION SPP REPLACEMENT PROJECT				
NO.	DRAWING NO.	TITLE		<div><div> REVIEW STAMP PROJECT NO.: 2006.10</div><div><input checked="" type="checkbox"/> E : Work may proceed. <input type="checkbox"/> F : Work may proceed, Submit Final Document / Drawing. <input type="checkbox"/> G : Review and Resubmit, Work may proceed subject to incorporation of changes indicated. <input type="checkbox"/> H : Review and Resubmit, Work may not proceed. <input type="checkbox"/> I : Review not required, Work may proceed. <small>Acceptance in any of these categories shall in no way relieve the Contractor / Supplier of its responsibility for</small></div></div>			<div><div> EGC COGENERATION COMPANY LIMITED</div></div>			TITLE : CROSSING BORING KP.0+686 TO KP.0+699			
1	7-5531-0036-B	ALIGNMENT SHEET TO/THAINOX LATERAL STA.0+000.000 TO 0+959.885		1	04/07/2023	ISSUED FOR AS-BUILT	WY	WRP	PWK	CHN	CONSULTANT : <div> UNITY UNITY ENGINEERING AND CONSULTANCY SERVICES CO., LTD.</div>		
2	7-5531-0003-B	ALIGNMENT SHEET SEGMENT STA.0+000.000 TO 1+248.675		0	30/08/2022	ISSUED FOR CONSTRUCTION	WY	WRP	PWK	CHN	CONTRACTOR : <div> TRC TRC CONSTRUCTION PUBLIC COMPANY LIMITED</div>		
3	D3-2006.10-4901-004-01	ALIGNMENT SHEET KP. 0+000 TO KP. 0+700		C	16/08/2022	RE-ISSUED FOR APPROVAL	WY	WRP	PWK	CHN	DWG. NO. D3-2006.10-4901-008		
4	D3-2006.10-4901-004-02	ALIGNMENT SHEET KP. 0+700 TO KP. 1+359.265		B	06/07/2022	RE-ISSUED FOR APPROVAL	WY	WRP	PWK	CHN	SHEET 1 OF 1		
				A1	24/5/2022	RE-ISSUED FOR APPROVAL	IX	WRP	PWK	CHN	REV. 1		
				A	16/3/2022	ISSUED FOR APPROVAL	IX	WRP	PWK	CHN	SCALE AS SHOWN		
				REV.	DATE	DESCRIPTION	BY	CHKD.	ENG.	APPR.			

PTT Public Company Limited

EGCO COGENERATION COMPANY LIMITED

UNITY ENGINEERING AND CONSULTANCY SERVICES CO., LTD.

TRC TRC CONSTRUCTION PUBLIC COMPANY LIMITED

1

7-5531-0036-B

ALIGNMENT SHEET TO/THAIKOK LATERAL

1


CONTRACTOR SHALL VERIFY THE ADJACENT EXISTING PTT & MIG PIPELINE LOCATION BEFORE CONSTRUCTION.

1


NEW GAS PIPELINE SYSTEM FOR

1

EGCO COGENERATION SPP REPLACEMENT PROJECT

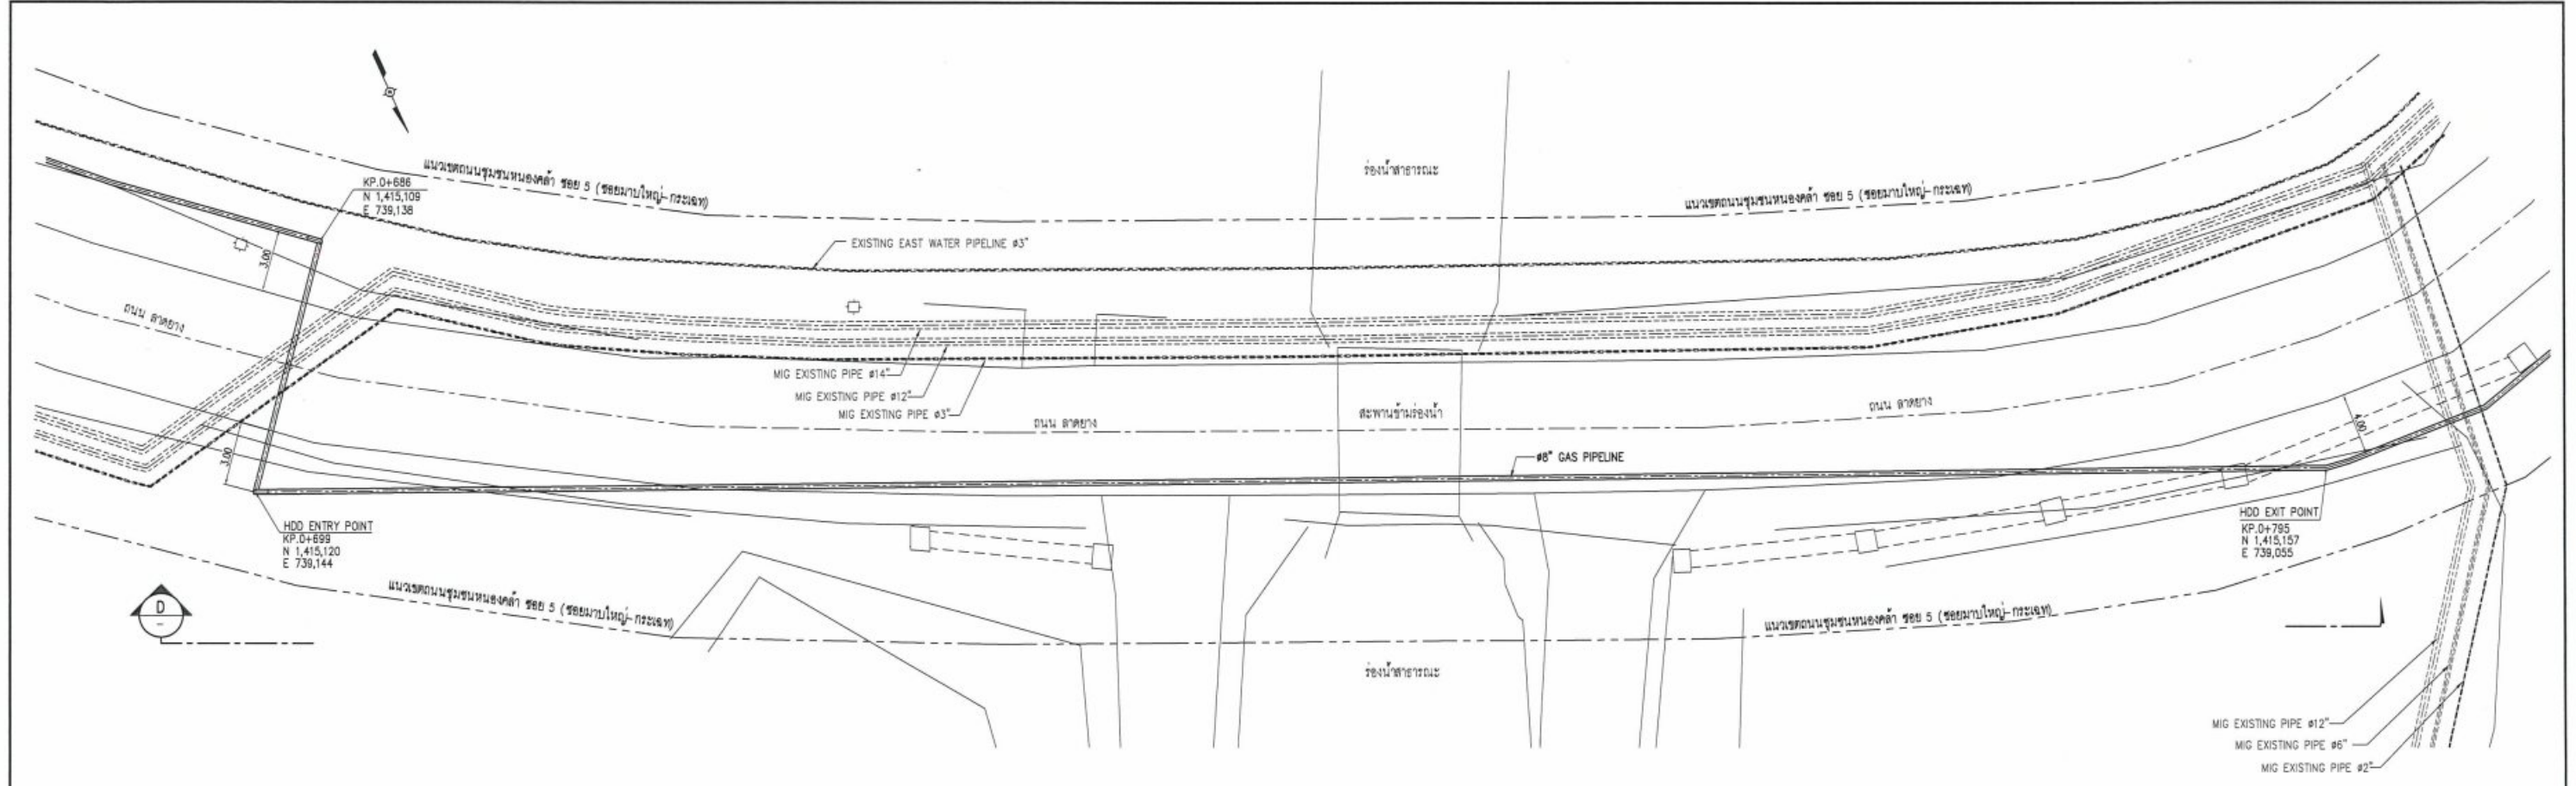

CROSSING HDD PLAN KP.0+699 TO KP.0+795
SCALE 1:150

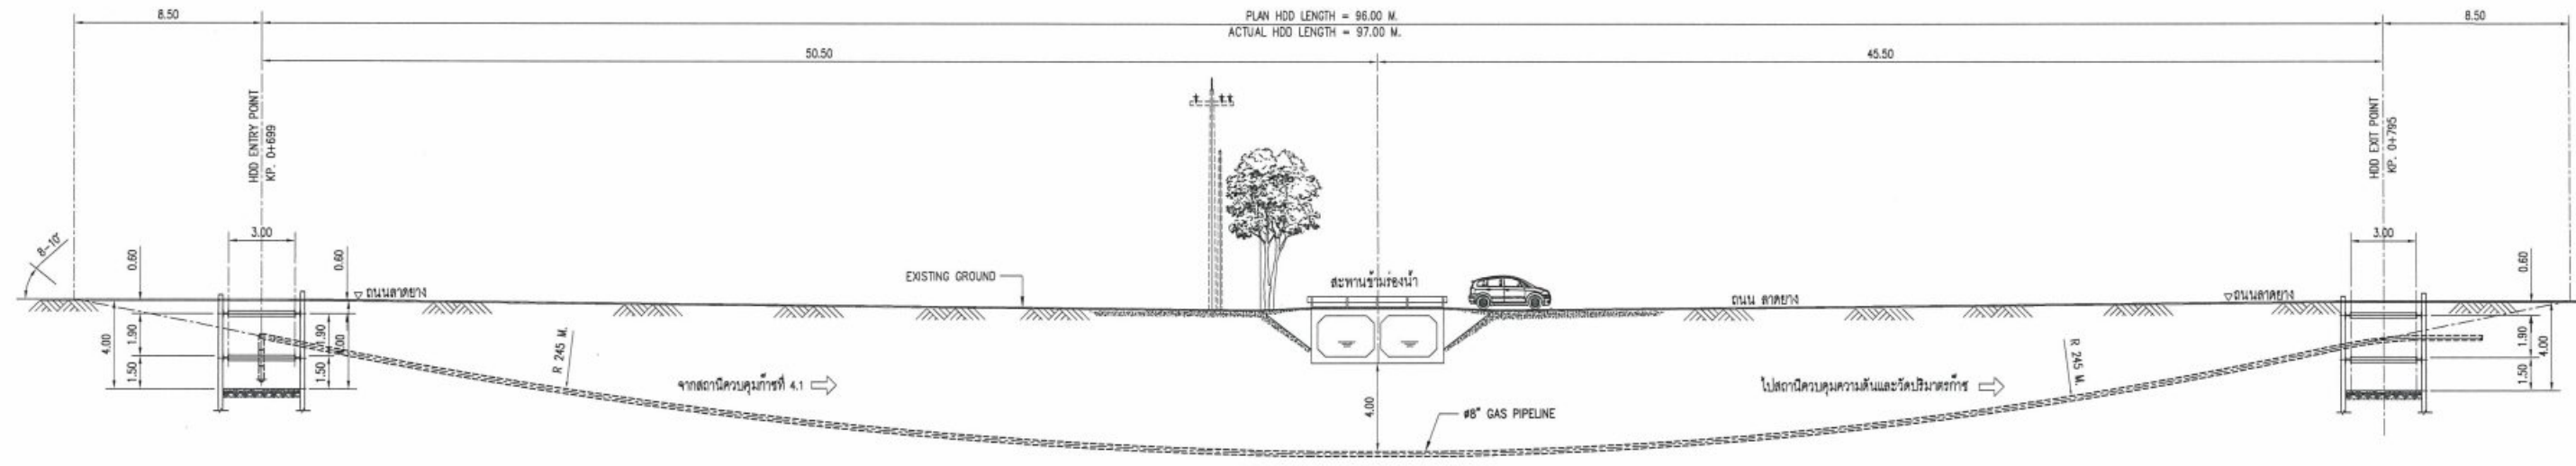

SECTION D
SCALE 1:150

AS-BUILT

REFERENCE DRAWINGS		
NO.	DRAWING NO.	TITLE
1	7-5531-0036-B	ALIGNMENT SHEET TO/THAIKHO LATERAL STA.0+000.000 TO 0+959.885
2	7-5531-0003-B	ALIGNMENT SHEET SEGMENT STA.0+000.000 TO 1+248.875
3	03-2006.10-4901-004-01	ALIGNMENT SHEET KP.0+000 TO KP.0+700
4	03-2006.10-4901-004-02	ALIGNMENT SHEET KP.0+700 TO KP.1+359

- GENERAL NOTES :
- CONTRACTOR SHALL VERIFY THE ADJACENT EXISTING PTT & MIG PIPELINE LOCATION BEFORE CONSTRUCTION.
 - SHORING BRACING OR MATERIAL FOR RETAINING WALLS SHALL BE INSTALLED BEFORE TRENCH EXCAVATION.
 - CONTRACTOR SHALL PERFORM SITE INVESTIGATION FOR INSTALLATION ALL MARKER POSTS BEFORE CONSTRUCTION.
 - CONTRACTOR SHALL VERIFY UNDERGROUND UTILITY BEFORE CONSTRUCTION.
 - REFER DOC. NO. MS-C-2006.10-010-001 FOR METHOD STATEMENT FOR HDD.
 - REFER DOC. NO. ED-D-2006.10-4901-004 FOR BUOYANCY CONTROL CALCULATION.
 - REFER DOC. NO. ED-D-2006.10-4901-001 FOR PIPELINE STRESS ANALYSIS REPORT.
 - REFER DOC. NO. ED-D-2006.10-4901-002 FOR PIPELINE STRESS CROSSING ROAD CALCULATION.

REVIEW STAMP
PROJECT NO.: 2006.10

☒ E : Work may proceed.
☐ F : Work may proceed. Submit Final Document / Drawing.
☐ G : Review and Resubmit. Work may proceed subject to incorporation of changes indicated.
☐ H : Review and Resubmit. Work may not proceed.
☐ I : Review not required. Work may proceed.

Acceptance in any of these categories shall in no way relieve the Contractor / Supplier of its responsibility for

REV.	DATE	DESCRIPTION	BY	CHKD.	ENG.	APPR.
2	04/07/2023	ISSUED FOR AS-BUILT				
1	16/08/2022	RE-ISSUED FOR CONSTRUCTION	WY	WRP	PKK	CHN
0	07/07/2022	ISSUED FOR CONSTRUCTION	WY	WRP	PKK	CHN
A1	24/05/2022	RE-ISSUED FOR APPROVAL	IX	WRP	PKK	CHN
A	16/03/2022	ISSUED FOR APPROVAL	IX	WRP	PKK	CHN


PROJECT ADVISOR : **PTT Public Company Limited**

CLIENT : **EGCO COGENERATION COMPANY LIMITED**


CONSULTANT : **UNITY ENGINEERING AND CONSULTANCY SERVICES CO., LTD.**

CONTRACTOR : **TRC CONSTRUCTION PUBLIC COMPANY LIMITED**


PROJECT : NEW GAS PIPELINE SYSTEM FOR EGCO COGENERATION SPP REPLACEMENT PROJECT		
TITLE : CROSSING HDD KP.0+699 TO KP.0+795		
DWG. NO. D3-2006.10-4901-009	SHEET 1 OF 1	REV. 2
SCALE 1:150		

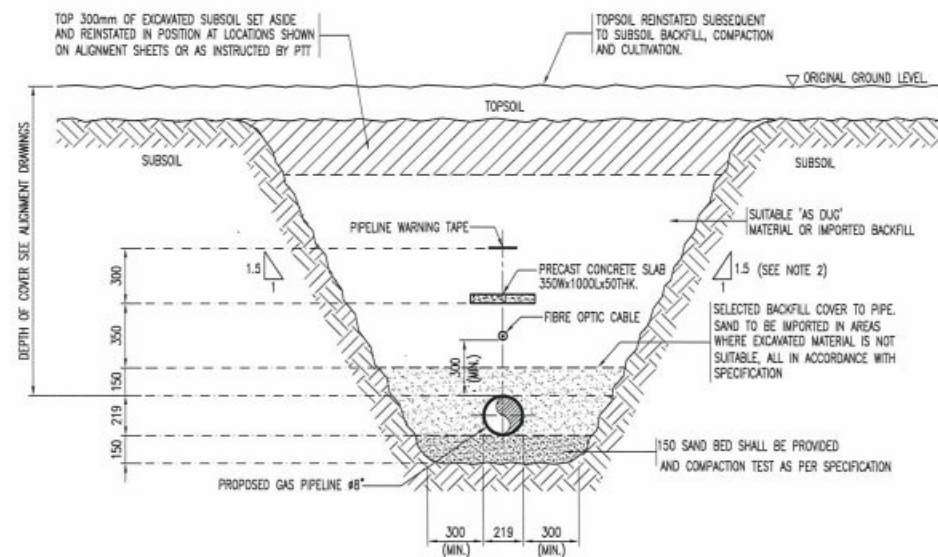


NORMAL INSTALLATION OF PIPELINE
(DEPTH OF COVER FOR STABILITY OF SOIL 1500 MM.)

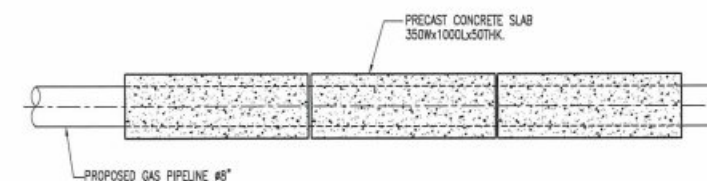

TYPICAL INSTALLATION CONCRETE SLAB PLAN

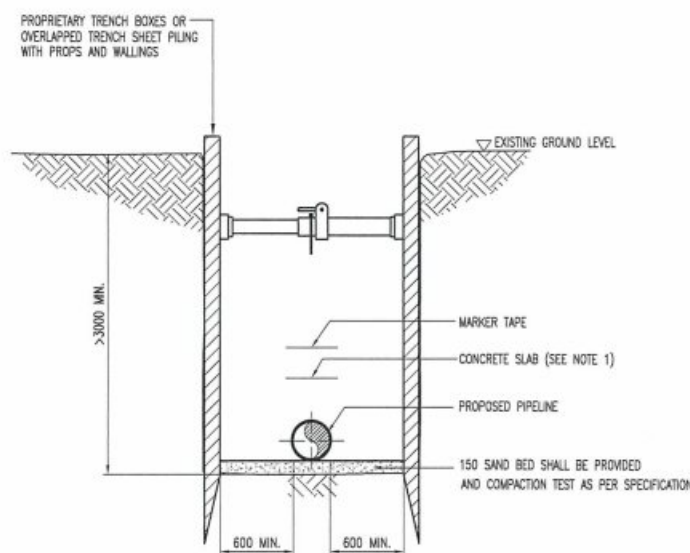

TYPE A
(SHEET PILING)

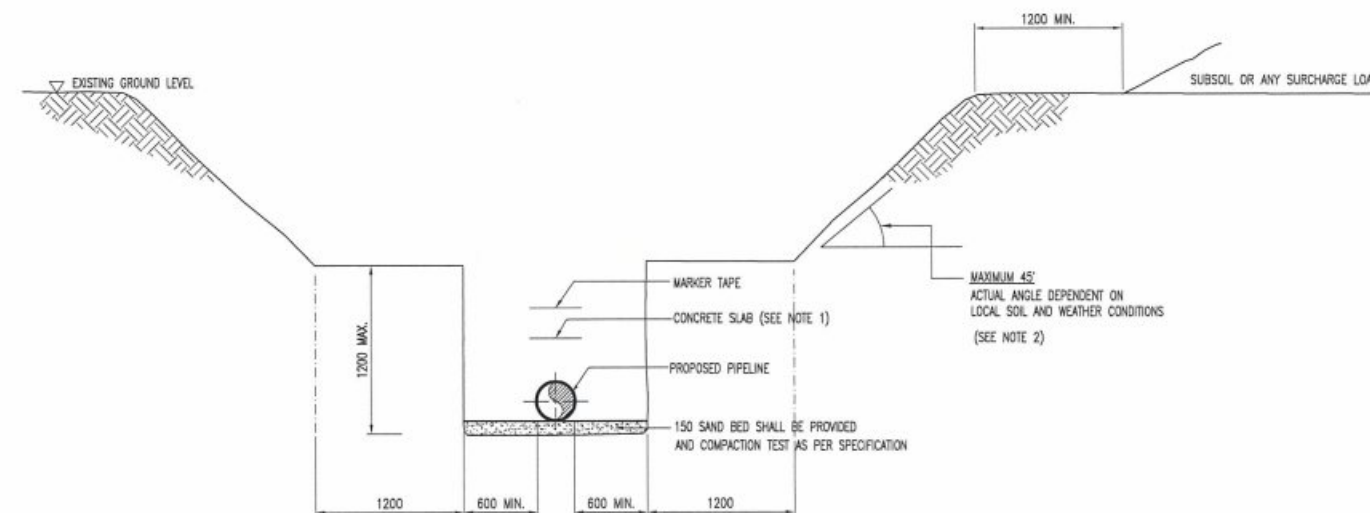

TYPE B

TRENCH SUPPORT AND DETAIL WHERE MANUAL ENTRY IS REQUIRED

AS-BUILT

REFERENCE DRAWINGS			GENERAL NOTES :		REVIEW STAMP PROJECT NO.: 2006.10		PROJECT ADVISOR :		PROJECT :	
NO.	DRAWING NO.	TITLE								
			1. CONCRETE SLAB PROTECTION NORMALLY WILL BE APPLIED FOR PIPELINE INSTALLATION BESIDE DOH/DOR, ROAD, AND SRT'S RAILWAY FOR THE OTHER SHALL BE FOLLOWED TYPICAL STANDARD DRAWING.		EGCO GROUP		PTT Public Company Limited		NEW GAS PIPELINE SYSTEM FOR EGCO COGENERATION SPP REPLACEMENT PROJECT	
			2. TRENCH EXCAVATION, SHEET PILE PIT AND SLOPE PROTECTION SHALL BE REFERRED TO CALCULATION NO ED-S-2006.10-4901-003		EGCO GROUP		EGCO COGENERATION COMPANY LIMITED		TYPICAL TRENCH EXCAVATION DETAILS	
			<input checked="" type="checkbox"/> E : Work may proceed. <input type="checkbox"/> F : Work may proceed, Submit Final Document / Drawing. <input type="checkbox"/> G : Review and Resubmit, Work may proceed subject to incorporation of changes indicated. <input type="checkbox"/> H : Review and Resubmit, Work may not proceed. <input type="checkbox"/> I : Review not required, Work may proceed.		3 04/07/2023 ISSUED FOR AS-BUILT 2 16/06/2022 RE-ISSUED FOR CONSTRUCTION WY WRP PWK CHN 1 06/07/2022 RE-ISSUED FOR CONSTRUCTION WY WRP PWK CHN 0 19/05/2022 ISSUED FOR CONSTRUCTION IX WRP PWK CHN A 16/03/2022 ISSUED FOR APPROVAL IX WRP PWK CHN		CONSULTANT : UNITY ENGINEERING AND CONSULTANCY SERVICES CO., LTD.		DWG. NO. D3-2006.10-4901-015 SHEET 1 OF 1 REV. 3	
			CONTRACTOR : TRC CONSTRUCTION PUBLIC COMPANY LIMITED		REV. DATE DESCRIPTION BY CHKD. ENG. APPR.		SCALE NTS.			



GAS PIPELINE WARNING SIGN
SCALE 1:3



COLOR: BLACK WORDING ON YELLOW
BACKGROUND (BS4800-10E55)
MATERIAL: 16 GAUGE STEEL PLATE
(1.5875 mm.THK.) AS A MINIMUM
PAINT: AS SPECIFIED IN TABLE 1 AND 2

หมายเหตุ

- เมื่อส่งงานไปยังหน่วยงานอื่น ให้มีป้ายกำกับ
- หนังสือแจ้งให้ทราบ
- ต้องบันทึกข้อมูลของป้ายด้วย
- ป้าย OFFSET WARNING SIGN ให้ติดตั้งเมื่อติดตั้งขุดหรือติดตั้งท่อหรือสายเคเบิล

TABLE 1 PRIMER		
PRODUCT	BRAND	DRY FILM THICKNESS (micron)
PENGUARD SPECIAL	JOTUN	80
GALVANIZE NO.400 PRIMER	TOA-CHUGOKU	40
INTERSEAL 670HS	INTERNATIONAL	100

TABLE 2 TOPCOAT (POLYURETHANE)		
PRODUCT	BRAND	DRY FILM THICKNESS (micron)
HARD TOP AS	JOTUN	35
UNY MARINE 100	TOA-CHUGOKU	35
INTERTHANE 990	INTERNATIONAL	50

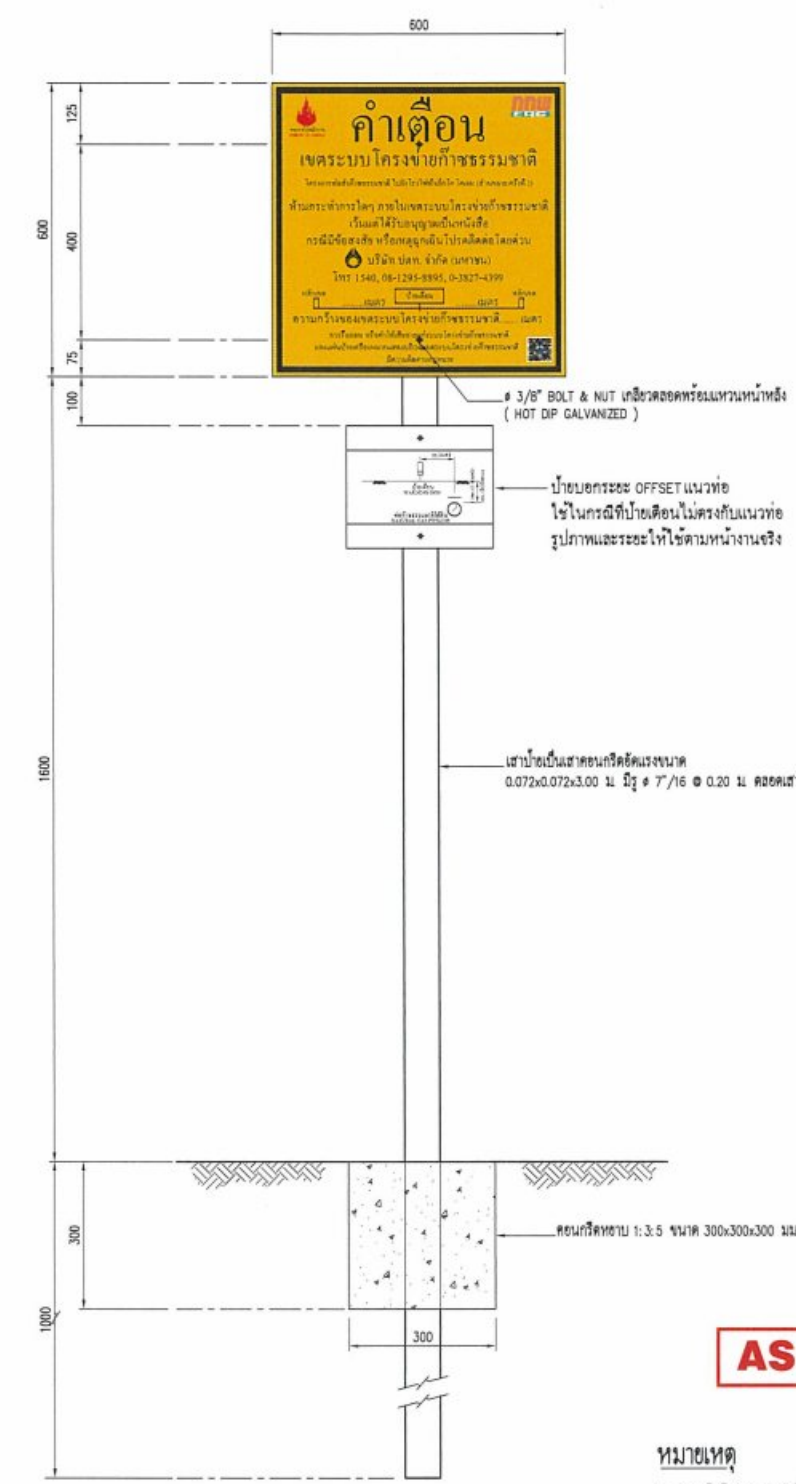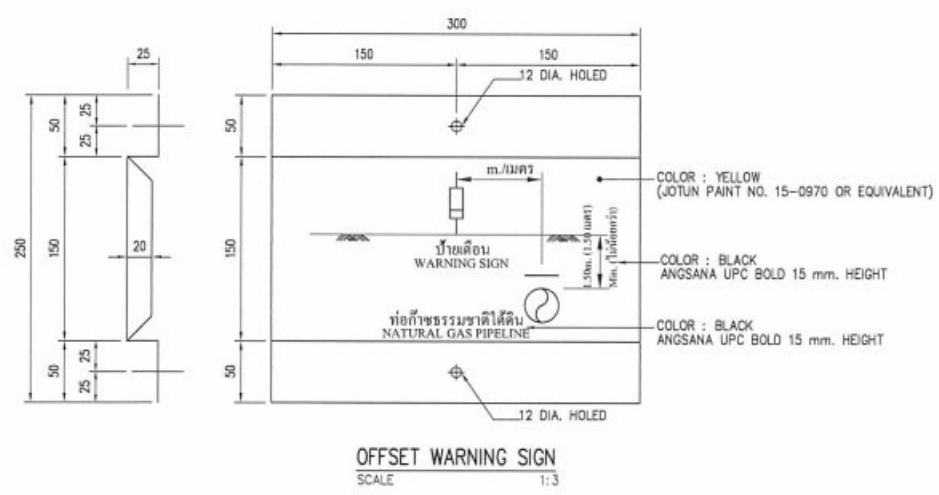

AS-BUILT

หมายเหตุ

- แบบที่ใช้กับแนวท่อส่งก๊าซธรรมชาติทั่วไป
- วิธีติดตั้งเป็นวงกลมตามแนวท่อส่งก๊าซธรรมชาติ
- แบบที่ใช้กับแนวท่อส่งก๊าซธรรมชาติ
- แบบที่ใช้กับแนวท่อส่งก๊าซธรรมชาติ
- แบบที่ใช้กับแนวท่อส่งก๊าซธรรมชาติ

REFERENCE DRAWINGS			GENERAL NOTES :		REVIEW STAMP		PROJECT ADVISOR :		PROJECT :	
NO.	DRAWING NO.	TITLE			EGCO GROUP		PTT Public Company Limited		NEW GAS PIPELINE SYSTEM FOR EGCO COGENERATION SPP REPLACEMENT PROJECT	
					PROJECT NO.: 2006.10		EGCO COGENERATION COMPANY LIMITED		TITLE :	
							CLIENT :		TYPICAL GAS PIPELINE WARNING SIGNS	
							CONTRACTOR :		DWG. NO.	
							TRC CONSTRUCTION PUBLIC COMPANY LIMITED		D3-2006.10-4901-016	
									SHEET	
									1 OF 1	
									REV.	
									2	
									SCALE	
									NOT TO SCALE	



TEXT (BLACK COLOR)
CONDENSED STYLE


PLASTIC SHEET YELLOW COLOR
300um THICK POLYESTER FILM

TEXT (BLACK COLOR)
CONDENSED STYLE


PIPELINE WARNING TAPE
NOT TO SCALE

AS-BUILT


REFERENCE DRAWINGS			GENERAL NOTES :		<div>REVIEW STAMP PROJECT NO.: 2006.10 <input checked="" type="checkbox"/> E : Work may proceed. <input type="checkbox"/> F : Work may proceed. Submit Final Document / Drawing. <input type="checkbox"/> G : Revise and Resubmit. Work may proceed subject to Incorporation of changes indicated. <input type="checkbox"/> H : Revise and Resubmit. Work may not proceed. <input type="checkbox"/> I : Review not required. Work may proceed. <small>Acceptance in any of these categories shall in no way relieve the Contractor / Supplier of its responsibility for the design and proper performance of the Work.</small></div>	PROJECT ADVISOR : PTT Public Company Limited				PROJECT : NEW GAS PIPELINE SYSTEM FOR EGCO COGENERATION SPP REPLACEMENT PROJECT	
NO.	DRAWING NO.	TITLE				CLIENT : EGCO COGENERATION COMPANY LIMITED				TITLE : TYPICAL WARNING TAPE DETAIL	
			ANT : UNITY ENGINEERING AND CONSULTANCY SERVICES CO., LTD.				DWG. NO. D3-2006.10-4901-017		SHEET 1 OF 1	REV. 1	
			CONTRACTOR : TRC CONSTRUCTION PUBLIC COMPANY LIMITED				SCALE NOT TO SCALE				
			REV.	DATE	DESCRIPTION	BY	CHKD.	ENG.	APPR.		
			1	04/07/2023	ISSUED FOR AS-BUILT						
			0	06/07/2022	ISSUED FOR CONSTRUCTION						
			B	18/05/2022	RE-ISSUED FOR APPROVAL	IX	WRP	PIK	CHN		
			A	16/03/2022	ISSUED FOR APPROVAL	IX	WRP	PIK	CHN		

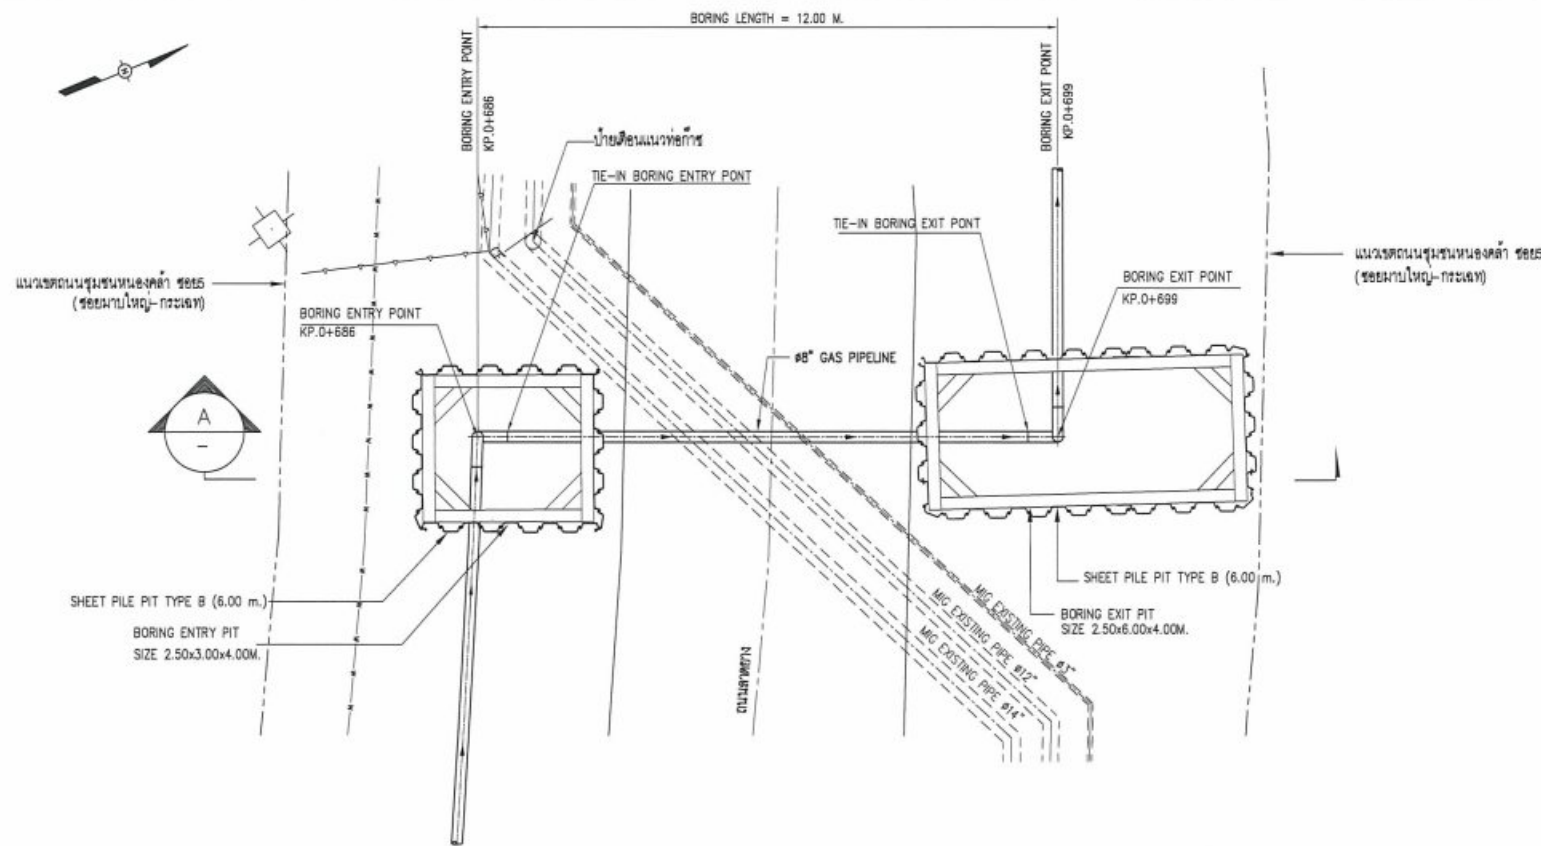


PLAN OF CROSSING MIG PRODUCT PIPELINES
SCALE 1:75

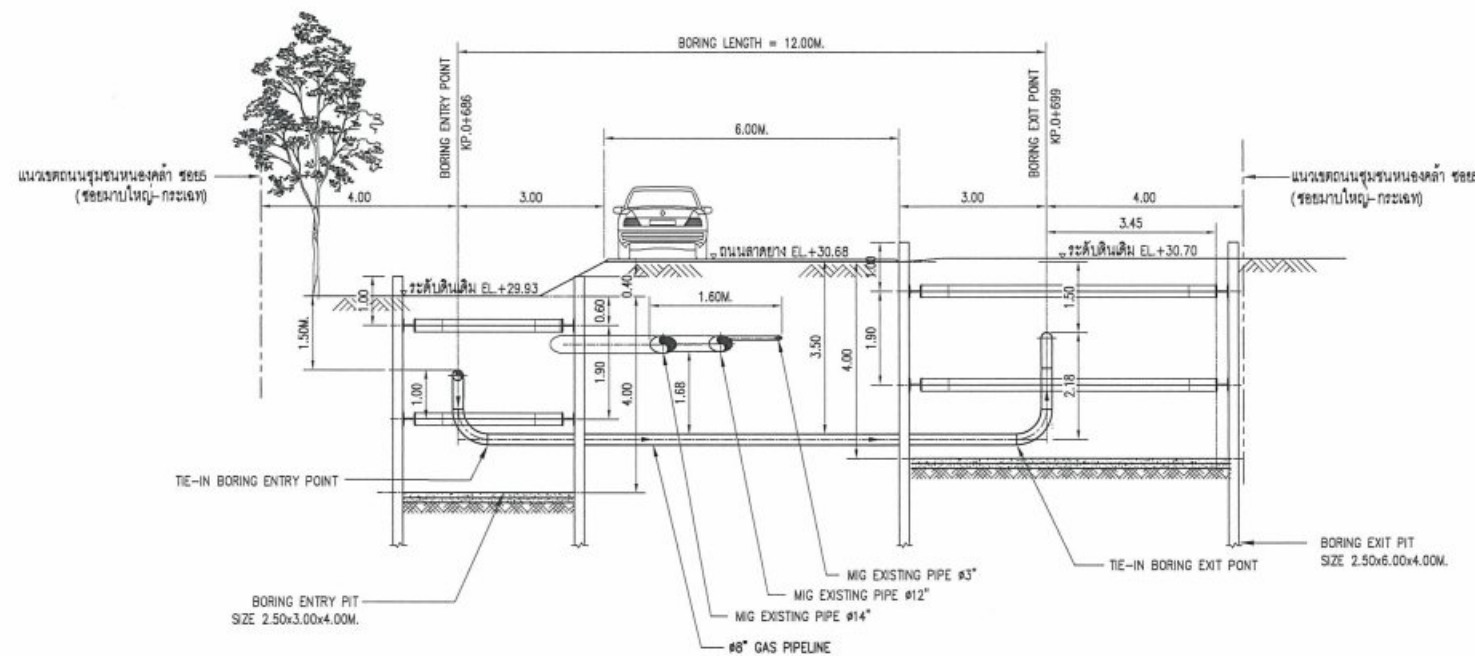


SECTION A
SCALE 1:75

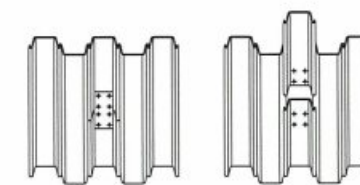

DETAIL OPEN SHEET PILE
SCALE NTS.

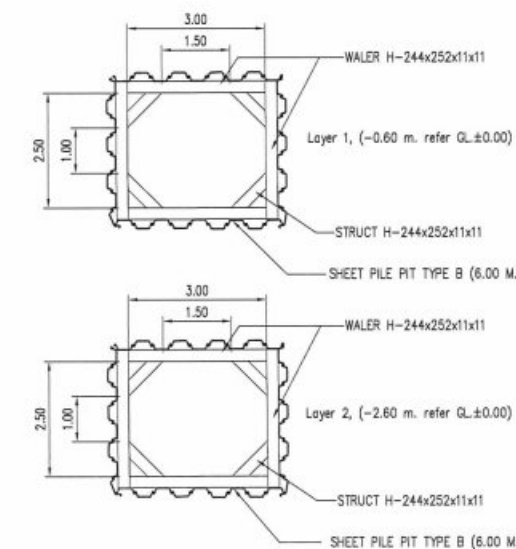


DETAIL OF BORING ENTRY PIT

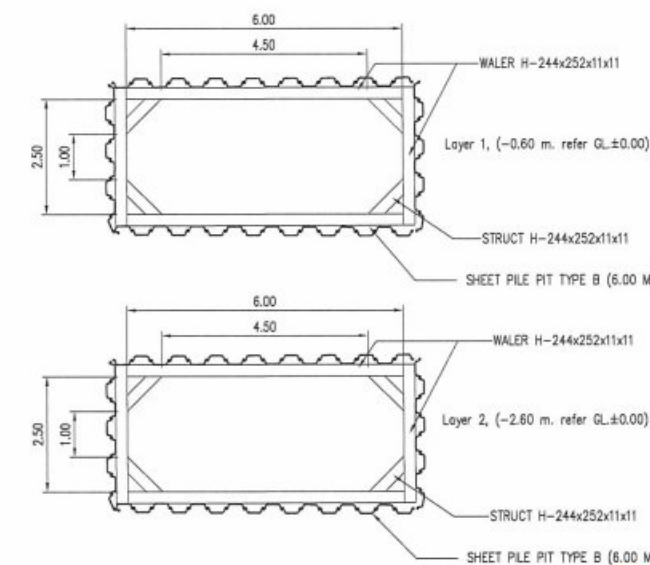


DETAIL OF BORING EXIT PIT

AS-BUILT

REFERENCE DRAWINGS			GENERAL NOTES :			REVIEW STAMP			PROJECT ADVISOR :			PROJECT :		
NO.	DRAWING NO.	TITLE				PROJECT NO.: 2006.10			PTT Public Company Limited			NEW GAS PIPELINE SYSTEM FOR		
1	7-5531-0036-B	ALIGNMENT SHEET TO/THAIKHOX LATERAL STA.0+000.000 TO 0+958.885	1. CONTRACTOR SHALL VERIFY THE ADJACENT EXISTING PIT & MIG PIPELINE LOCATION BEFORE CONSTRUCTION.			EGCO			EGCO COGENERATION COMPANY LIMITED			EGCO COGENERATION SPP REPLACEMENT PROJECT		
2	7-5531-0003-B	ALIGNMENT SHEET SEGMENT STA.0+000.000 TO 1+248.875	2. SHORING BRACING OR MATERIAL FOR RETAINING WALLS SHALL BE INSTALLED BEFORE TRENCH EXCAVATION.			E : Work may proceed. Submit Final Document / Drawing.			U			TITLE :		
3	D3-2006.10-4901-004-01	ALIGNMENT SHEET KP.0+000 TO KP.0+700	3. CONTRACTOR SHALL PERFORM SITE INVESTIGATION FOR INSTALLATION ALL MARKER POSTS BEFORE CONSTRUCTION.			F : Work may proceed. Submit Final Document / Drawing.			CONSULTANT :			PLAN OF CROSSING MIG PRODUCT PIPELINES		
4	D3-2006.10-4901-004-02	ALIGNMENT SHEET KP. 0+700 TO KP. 1+359.265	4. CONTRACTOR SHALL VERIFY UNDERGROUND UTILITY BEFORE CONSTRUCTION.			G : Revise and Resubmit. Work may proceed subject to Incorporation of changes Indicated.			CONTRACTOR :			DWG. NO.		
			5. REFER DOC. NO. ED-S-2006.10-4901-003 FOR SHEET PILE CALCULATION.			H : Revise and Resubmit. Work may not proceed.			TRC			D3-2006.10-4901-018		
			6. REFER DOC. NO. MS-C-2006.10-010-002 FOR METHOD STATEMENT FOR BORING.			I : Review not required. Work may proceed.			TRC CONSTRUCTION PUBLIC COMPANY LIMITED			SHEET		
			7. REFER DOC. NO. ED-D-2006.10-4901-004 FOR BUOYANCY CONTROL CALCULATION.			Acceptance in any of these categories shall in no way relieve the Contractor / Supplier of its responsibility for the due and proper performance of the Work in accordance with the Contract / Purchase Order.						1 OF 1		
			8. REFER DOC. NO. ED-D-2006.10-4901-001 FOR PIPELINE STRESS ANALYSIS REPORT.			EGCO			REV.			2		
			9. REFER DOC. NO. ED-D-2006.10-4901-002 FOR PIPELINE STRESS CROSSING ROAD CALCULATION.			REV.			DATE			DESCRIPTION		
						BY			CHKD.			ENG.		
						APPR.								

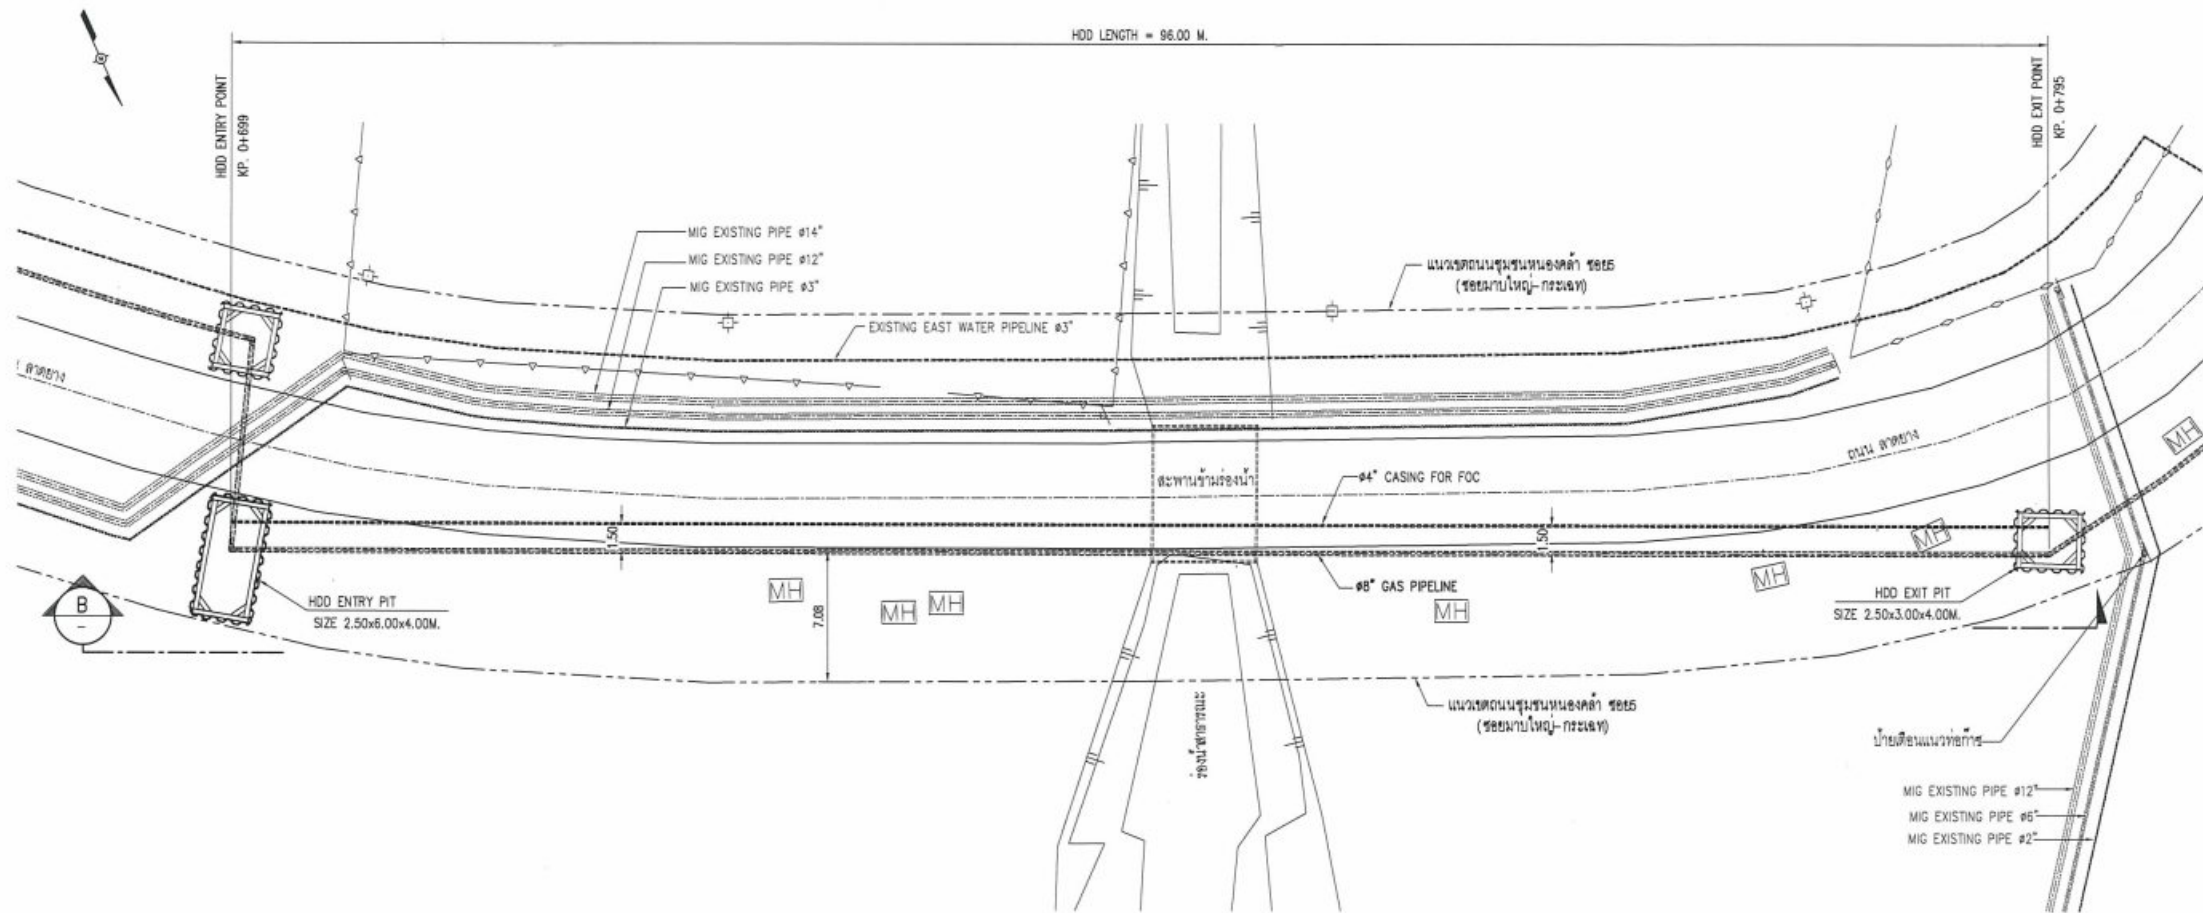


PLAN OF CROSSING MIG PRODUCT PIPELINES
SCALE 1:75

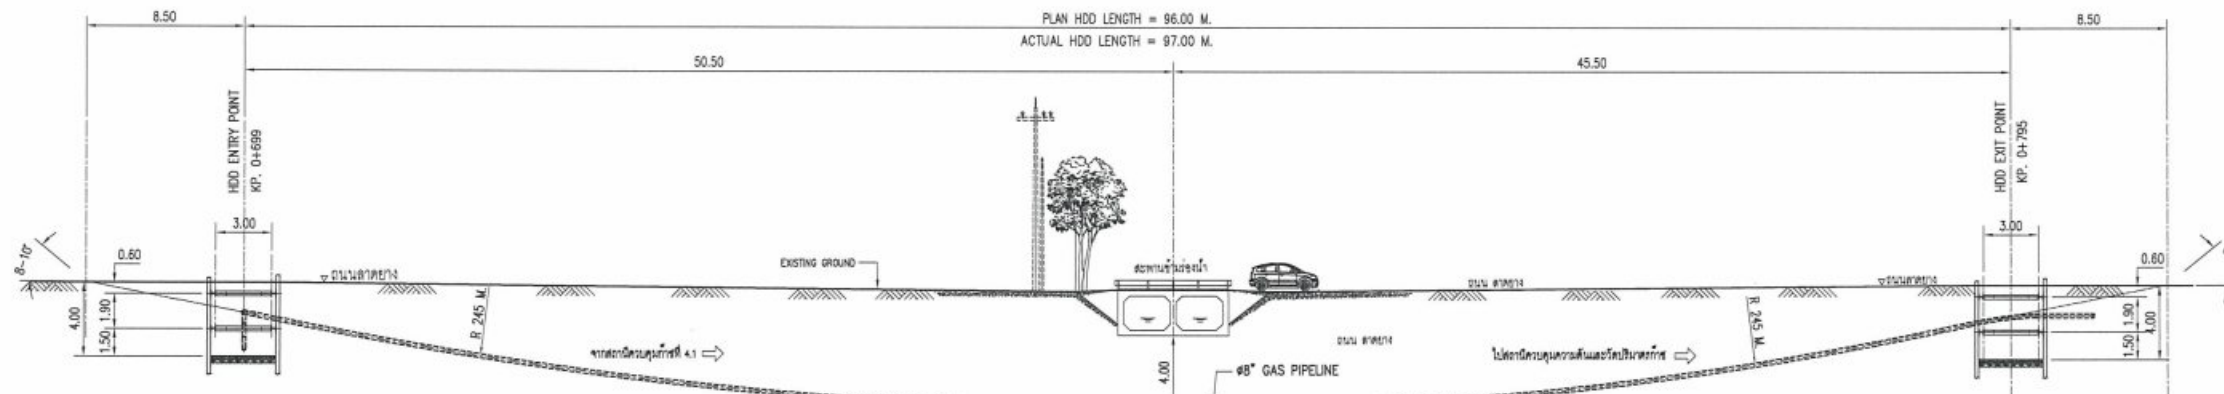


SECTION B
SCALE 1:200


AS-BUILT

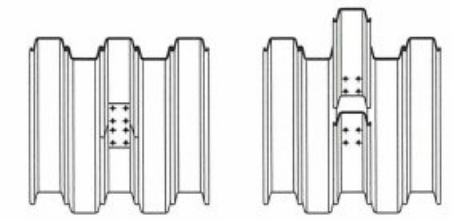

DETAIL OPEN SHEET PILE
SCALE NTS.

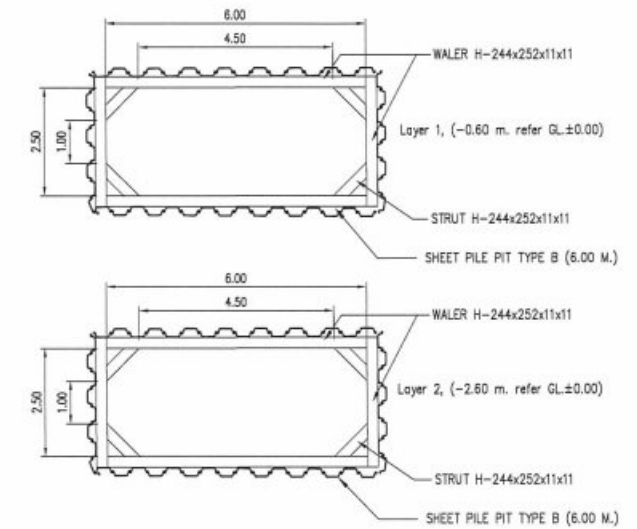

DETAIL OF HDD ENTRY PIT (BORING EXIT PIT)
SCALE 1:200

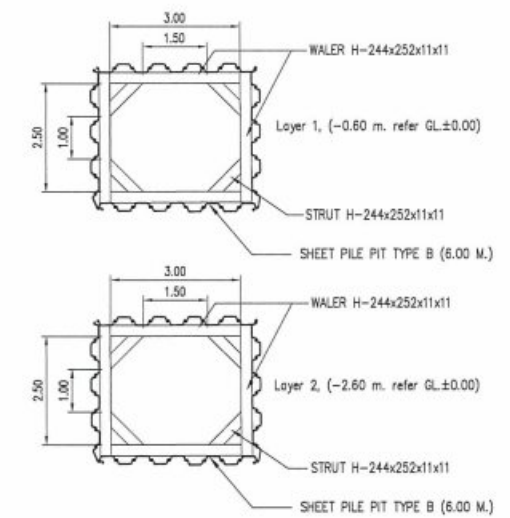

DETAIL OF HDD EXIT PIT
SCALE 1:200


NO.	DRAWING NO.	TITLE
1	7-5531-0036-B	ALIGNMENT SHEET TO/THAIKOK LATERAL STA.0+000.000 TO 0+959.885
2	7-5531-0003-B	ALIGNMENT SHEET SEGMENT STA.0+000.000 TO 1+248.875
3	03-2006.10-4901-004-01	ALIGNMENT SHEET KP. 0+000 TO KP. 0+700
4	03-2006.10-4901-004-02	ALIGNMENT SHEET KP. 0+700 TO KP. 1+359
5	03-2006.10-4901-005-08	TYPICAL CROSS SECTION DRAWING FROM APPROXIMATE KP. 0+699 TO KP. 0+795

- GENERAL NOTES :
- CONTRACTOR SHALL VERIFY THE ADJACENT EXISTING PTT & MIG PIPELINE LOCATION BEFORE CONSTRUCTION.
 - SHORING BRACING OR MATERIAL FOR RETAINING WALLS SHALL BE INSTALLED BEFORE TRENCH EXCAVATION.
 - CONTRACTOR SHALL PERFORM SITE INVESTIGATION FOR INSTALLATION ALL MARKER POSTS BEFORE CONSTRUCTION.
 - CONTRACTOR SHALL VERIFY UNDERGROUND UTILITY BEFORE CONSTRUCTION.
 - REFER DOC. NO. MS-C-2006.10-010-001 FOR METHOD STATEMENT FOR HDD.
 - REFER DOC. NO. ED-D-2006.10-4901-004 FOR BUOYANCY CONTROL CALCULATION.
 - REFER DOC. NO. ED-D-2006.10-4901-001 FOR PIPELINE STRESS ANALYSIS REPORT.
 - REFER DOC. NO. ED-D-2006.10-4901-002 FOR PIPELINE STRESS CROSSING ROAD CALCULATION.


REVIEW STAMP PROJECT NO.: 2006.10	
<input checked="" type="checkbox"/> E : Work may proceed. <input type="checkbox"/> F : Work may proceed. Submit Final Document / Drawing. <input type="checkbox"/> G : Review and Resubmit. Work may proceed subject to incorporation of changes indicated. <input type="checkbox"/> H : Review and Resubmit. Work may not proceed. <input type="checkbox"/> I : Review not required. Work may proceed.	Acceptance in any of these categories shall in no way relieve the Contractor / Supplier of its responsibility for the design and construction of the work.
EGO Name Sign Date	2 04/07/2023 ISSUED FOR AS-BUILT 1 16/08/2022 RE-ISSUED FOR CONSTRUCTION 0 07/07/2022 ISSUED FOR CONSTRUCTION A1 23/05/2022 RE-ISSUED FOR APPROVAL A 16/03/2022 ISSUED FOR APPROVAL
REV.	DATE DESCRIPTION BY CHKD. ENG. APPR.

PROJECT ADVISOR :	PTT Public Company Limited
CLIENT :	EGCO COGENERATION COMPANY LIMITED
CONSULTANT :	UNITY ENGINEERING AND CONSULTANCY SERVICES CO., LTD.
CONTRACTOR :	TRC CONSTRUCTION PUBLIC COMPANY LIMITED


PROJECT :	NEW GAS PIPELINE SYSTEM FOR EGCO COGENERATION SPP REPLACEMENT PROJECT		
TITLE :	PLAN OF CROSSING HDD		
DWG. NO.	D3-2006.10-4901-019	SHEET	REV.
SCALE	AS SHOWN	1 OF 1	2

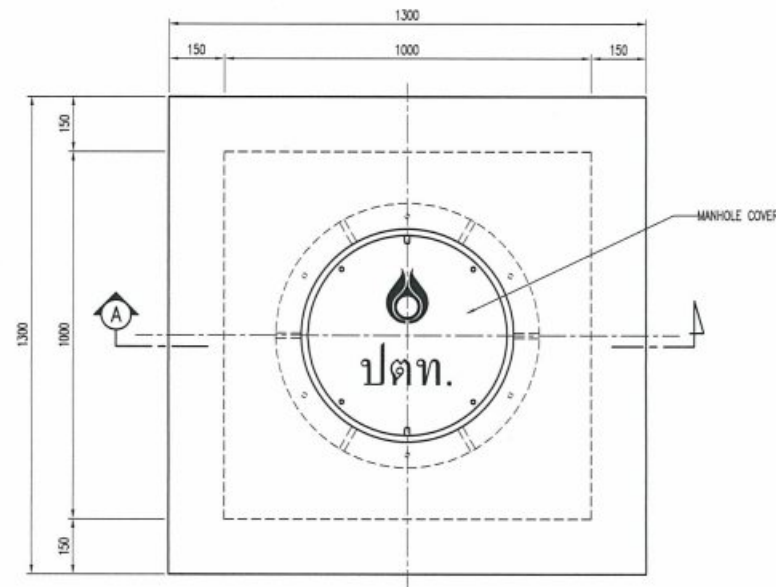


TOP PLAN
SCALE 1:20

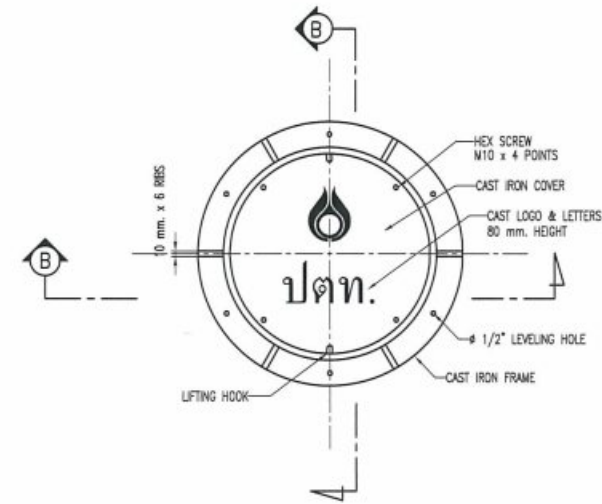


TOP VIEW
SCALE 1:20
MANHOLE COVER HEAVY DUTY SIZE Ø500 mm.

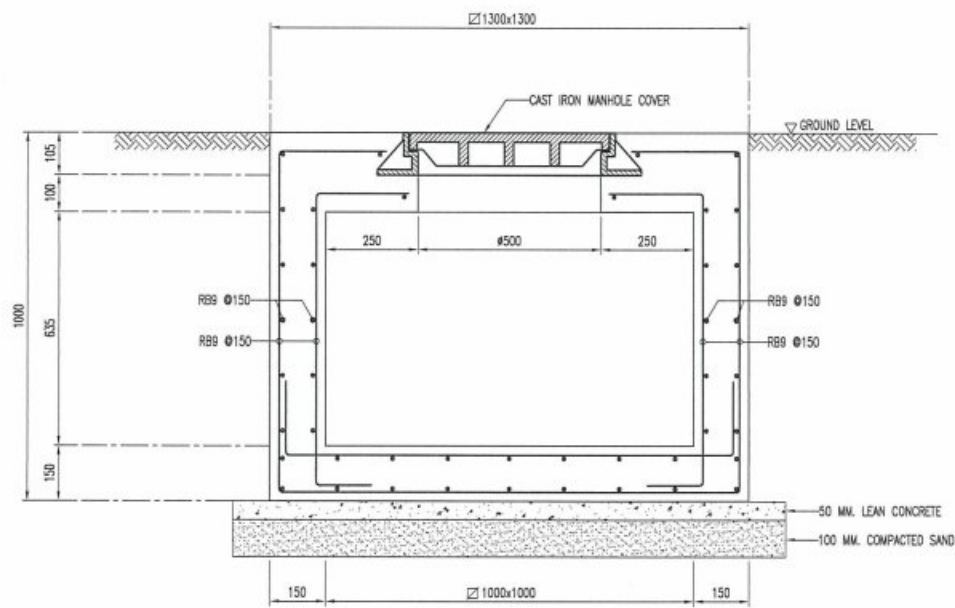


SECTION A
SCALE 1:20

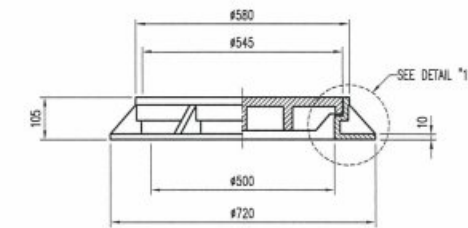

SECTION B
SCALE 1:20

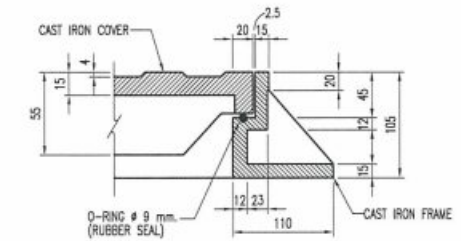



DETAIL "1"
SCALE 1:10

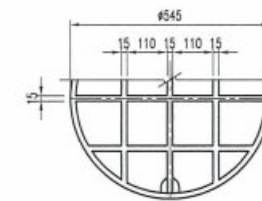

BOTTOM VIEW OF COVER
SCALE 1:20

AS-BUILT

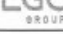REFERENCE DRAWINGS			GENERAL NOTES :		REVIEW STAMP		PROJECT ADVISOR :		PROJECT :	
NO.	DRAWING NO.	TITLE	1. ALL ELEVATIONS ARE IN METERS AND DIMENSIONS ARE IN MILLIMETERS OR UNO.		EGCO GROUP PROJECT NO.: 2006.10		PTT Public Company Limited		NEW GAS PIPELINE SYSTEM FOR EGCO COGENERATION SPP REPLACEMENT PROJECT	
					<input checked="" type="checkbox"/> E : Work may proceed. <input type="checkbox"/> F : Work may proceed. Submit Final Document / Drawing. <input type="checkbox"/> G : Revise and Resubmit. Work may proceed subject to Incorporation of changes indicated. <input type="checkbox"/> H : Revise and Resubmit. Work may not proceed. <input type="checkbox"/> I : Review not required. Work may proceed.		CLIENT : EGCO COGENERATION COMPANY LIMITED		TITLE : FIBER OPTIC MANHOLE (COVER HEAVY DUTY)	
					Acceptance in any of these categories shall in no way relieve the Contractor / Supplier of its responsibility for the due and proper performance of the Work in		CONSULTANT :  UNITY ENGINEERING AND CONSULTANCY SERVICES CO., LTD.		DWG. NO. 03-2006.10-4901-020	
							TRACTOR :  TRC CONSTRUCTION PUBLIC COMPANY LIMITED		SHEET 1 OF 1	
									REV. 1	